

ADDENDUM

ADDENDUM NO.: #01 **DATE:** 01/31/2024

PROJECT: Woodhouse Ford Pro: Building Improvements **PROJECT #:** 23043

TO: Prospective Bidders

This Addendum is issued by the Architect to all bidders of record prior to receipt of proposals. Bidders shall acknowledge receipt of this addendum by so indicating on the Proposal Form. Failure to do so may subject Bidder to disqualification. All information and instructions given herein shall become a part of the Contract Documents.

GENERAL

- 1. Specifications for the metal building insulation and roof liner are attached.
- 2. All revised drawings are attached.

DRAWINGS

1. AD1.1 - DEMO PLAN

ii.

- a. 1 FIRST FLOOR DEMO PLAN
 - i. Add notes 8 and 4 to walls at the existing Parts Storage room.
 - Added note 36 to the floor plan demo notes. "Remove existing $\frac{1}{2}$ "
 - plywood sheathing as shown on drawing in prep for new 3/4" sheathing."

2. A0.5 - ARCHITECTURAL SITE PLAN

- a. Sheet for reference only.
- b. Stripping is by the owner.

3. A1.1A - FIRST FLOOR PLAN - AREA A & B

- a. 1 FIRST FLOOR PLAN AREA A
 - i. Revised plywood sheathing on the exterior wall of LOBBY 2.
 - ii. Added two callouts.
 - 1. 2/6.2 "PLAN DETAIL OUTSIDE CORNER 2 (FORD PRO WALL)
 - 2. 3/6.2 "PLAN DETAIL OUTSIDE CORNER (FORD PRO WALL)
 - iii. Added missing door tag 2B (see A7.1 notes).
 - iv. Added door #15 at CORR 15.
 - v. Added additional Note 12 at CORR 15.
 - vi. Revised all gridlines to match structural drawings.
 - vii. Added missing dimension to paint stripe in Service Drive
- b. 2 FIRST FLOOR PLAN AREA B
 - i. Added note to firestop existing rated wall.

4. A1.2B - FIRST FLOOR PLAN - AREA C

a. 1 - FIRST FLOOR PLAN - AREA C

BVH Architecture

- i. Add two M60 walls at COMPRESSOR 30 & ELEC. 42
- ii. Add a HM flush door #30 at COMPRESSOR 30
- iii. Add floor plan note #24
- iv. Added additional note #18 at west wall of SERVICE 32
- v. Revised all gridlines
- b. Removed detail #2 from sheet.

5. A1.4 - ENLARGED PLANS & INTERIOR ELEVATIONS

- a. Elevations 20&21:
 - i. Added additional notes to elevations
- b. 11 LOBBY ELEVATION NORTH
 - i. Revised control joint location
- c. 18 LOBBY ELEVATION SOUTH
 - i. Added additional notes
 - ii. Added detail references and new detail 4/6.2.

6. A2.1 - FIRST FLOOR RCP - AREA A&B

a. Revised Alternate 2 text. See attached specs.

7. A2.2 - FIRST FLOOR RCP - AREA C

a. Revised Alternate 2 text. See attached specs.

8. A5.1 - WALL SECTIONS

- a. WALL SECTIONS 5&6:
 - i. Revised detail references for overhead door head detail.
 - ii. Added note to provide new gutters per roof plan.
- b. 2 WALL SECTION FORD PRO WALL
 - i. Add note to provide WD blocking behind signage.
- c. 7 TYP EXT WALL ASSEMBLIES
 - i. Added note to provide FRT Plywood sheathing.

9. A6.1 - DETAILS

- a. 7 DETAIL FORD PRO WALL BASE
 - i. Revised plywood sheathing to ³/₄".
- b. 8 DETAIL PARAPET (FORD PRO WALL)
 - i. Revised plywood sheathing to 3/4".
- c. 12 DETAIL AREA A PONY WALL
 - i. Revised glazing and sill details
- d. Added detail 4.

10. A6.2 - DETAILS

- a. 2 PLAN DETAIL OUTSIDE CORNER 2 (FORD PRO WALL) Added
- b. 3 PLAN DETAIL OUTSIDE CORNER (FORD PRO WALL) Added
- c. 4 SILL DETAIL Added

11. A7.1 - DOOR AND WINDOW FRAME TYPES/DETAILS

- a. DOOR SCHEDULE
 - i. Add door #15 & #30
 - ii. Changed door #19 to #2B.
 - iii. Revised width of door #2A.
- b. Door panel elevations:



- i. Noted G1 glazing
- c. Detail #2: Revised insulation note.
- d. Specs:

ii.

- i. 084213 Aluminum Framed Entrances:
 - 1. Removed note to provide non thermal at interior.
 - 2. Revised finish spec
 - 3. Revised hardware sets
 - 084313 Aluminum Framed Storefronts
 - 1. Revised finish color from black to clear anodized.
- iii. 08800 Glazing
 - 1. Added CLR part numbers to glazing channels.
- iv. Hardware Schedule
 - 1. Revised as clouded.

SEE ATTACHED MORRISSEY ENGINEERING ADDENDUM NARRATIVE AND DRAWINGS.

END OF ADDENDUM



mechanical | electrical | lighting | technology | commissioning

addendum

addendum no.	01
date:	2/1/2024
bid date:	n/a
project name:	Woodhouse Ford Pro
project no:	23416

This addendum is hereby made a part of the contract documents to the same extent as if it were originally included therein. Contract documents shall be considered modified or revised as hereinafter described.

mechanical items

- 1. Sheet FP1.3 FLOOR PLAN FIRE PROTECTION AREA A
 - a. Add plan showing mezzanine requiring fire protection.
 - b. Add location of fire department connection.
 - c. Add notes for fire service design.
 - d. Add notes for avoiding relocated equipment.
- 2. Sheet MD1.3 DEMOLITION FLOOR PLAN HVAC AREA C
 - a. Salvage AC unit and unit heater for relocation.
 - b. Revised note for thermostats. All thermostats for new and existing equipment within the scope of work to be replaced with new programmable thermostats meeting energy code requirements.
- 3. Sheet MD2.3 DEMOLITION FLOOR PLAN PLUMBING AREA C
 - a. Demolish abandoned fire service serving old spray booths.
 - b. Demo refrigerant and condensate piping for relocated ac unit.
 - c. Demo gas piping required for salvaged unit heater.
- 4. Sheet M1.3 FLOOR PLAN HVAC AREA C
 - a. Relocate AC unit and unit heater. Provide new refrigerant piping for AC unit and gas piping for unit heater.
 - b. Provide new thermostats for AC unit and unit heater.
 - c. Add split system wall mounted unit to condition Elec 42. Add associated refrigerant piping and thermostat.
 - d. Revise thermostat for compressor room to be cooling only thermostat.
 - e. Provide new thermostat in Service 32 previously shown as existing.
- 5. Sheet M1.6 ROOF PLAN MECHANICAL AREA C
 - a. Add refrigerant piping hood and air cooled heat pump unit for new indoor unit serving Elec 42.
- Sheet M2.3 UNDERGROUND PLAN PLUMBING AREA C
 a. Change floor drain in Compressor 30 to floor sink.
- 7. Sheet M2.6 FLOOR PLAN PLUMBING AREA C

- a. Add gas piping for relocated unit heater.
- b. Add condensate piping for relocated ac unit and new AC-1 serving Elec 42.
- 8. Sheet M3.2 MECHANICAL DETAILS
 - a. Add split system detail
- 9. Sheet M4.1 MECHANICAL SCHEDULES
 - a. Add refrigerant and condensate piping to pipe insulation schedule.
 - b. Add split system air conditioning unit schedule.
- 10. Mechanical Specifications:
 - a. Section 233423 Power Ventilators
 - i. Add Soler & Palau to list of allowable manufacturers.
 - b. Section 235523 Gas-Fired Radiant Heaters
 - i. Add Re-Verber-Ray to list of allowable manufacturers.
 - c. Section 233113 Metal Ducts and Accessories
 - i. Add Louvers & Dampers Inc. to list of allowable manufacturers.

electrical items

- 1. Sheet E1.1 FLOOR PLAN LIGHTING AREA A
 - a. Add HVLS fans and controllers.
 - b. Revise Keynotes
- 2. Sheet E1.3 FIRST FLOOR PLAN LIGHTING AREA C
 - a. Add HVLS fans and controllers.
 - b. Revise Keynotes
- 3. Sheet E2.3 FIRST FLOOR PLAN POWER AREA C
 - a. Add cord reels in Service 32
 - b. Extend existing circuits to relocated mechanical equipment in Parts 29
 - c. Add electrical connection to AC-1 in Electrical Room 42.
- 4. Sheet E2.6 ROOF PLAN POWER AREA C a. Add connection to HP-1.
- 5. Sheet E4.0 ELECTRICAL SCHEDULES AND DIAGRAMS a. Mechanical Connection Schedule – Add AC-1 and HP-1
- 6. Sheet E4.1 ELECTRICAL PANEL SCHEDULES
 - a. Revise circuit breakers in Panel S1.
 - b. Revise circuit breakers in Panel H2.
 - c. Revise circuit breakers in Panel A1.
 - d. Revise circuit breakers in Panel H.

end of addendum

SECTION 07213

PRE-ENGINEERED BUILDING INSULATION

PART 1 GENERAL

1.1 SECTION INCLUDES

- A. Pre-Engineered Building Insulation for Existing Construction.
- B. Aesthetic roof liner retrofit
- 1.2 RELATED SECTIONS A. N/A

1.3 REFERENCES

- A. ASTM E 84 Standard Test Method for Surface Burning Characteristics of Building Materials.
- B. ASTM E 96 Standard Test Method for Water Vapor Transmission of Materials in Sheet Form (Procedure B).
- C. ASTM C 665 Standard Specification for Mineral-Fiber Blanket Thermal Insulation for Light Frame Construction and Manufactured Housing.
- D. NFPA 255 Standard Method of Test of Surface Burning Characteristics of Building Materials.
- E. UL 723 Tests for Surface Burning Characteristics of Building Materials.
- F. ASTM C 1136 Standard Specification for Flexible, Low Permeance Vapor Retarders for Thermal Insulation.

1.4 DESIGN REQUIREMENTS

- A. Insulating system shall have a continuous vapor barrier inside of building girts, and insulation to provide complete isolation from inside conditioned air.
- C. Roof system shall be an aesthetic retrofit of existing roof system, applied over existing insulation and roof purlins. Existing roof features continuous exterior insulation.

1.5 SUBMITTALS

- A. Submit under provisions of Section 01300.
- B. [Product Data]: Manufacturer's data sheets on each product to be used, including:
 - 1. Preparation instructions and recommendations.
 - 2. Storage and handling requirements and recommendations.
 - 3. Installation instructions.
- C. Shop Drawings: Indicate locations of connections and attachments, general details, anchorages and method of anchorage and installation.

- Verification Samples: For each finish product specified, two samples, minimum size 6 inches (150 mm) square or long, representing actual products required for this project.
- E. Manufacturer's Certificate: Certify products meet or exceed specified requirements.

1.6 QUALITY ASSURANCE

- A. Manufacturer Qualifications: Company specializing in manufacturing product systems specified in this section with minimum ten years documented experience.
- B. Installer Qualifications: Company specializing in performing work of this section.
- C. Insulation system components to include a ten-year limited material warranty.

1.7 DELIVERY, STORAGE, AND HANDLING

- A. Store products in manufacturer's unopened packaging until ready for installation.
- B. Store products indoors and protect from moisture, construction traffic, and damage.

1.8 PROJECT CONDITIONS

A. Maintain environmental conditions (temperature, humidity, and ventilation) within limits recommended by manufacturer for optimum results. Do not install products under environmental conditions outside manufacturer's absolute limits.

PART 2 PRODUCTS

2.1 MANUFACTURERS

- A. Acceptable Manufacturer: Thermal Design, Inc., Simple Saver System. P.O. Box 468, 601 N. Main Street, Madison, NE 68748. ASD. Tel: (800) 255-0776 or (402) 454-6591. Fax: (402) 454-2708. Email: <u>sales@thermaldesign.com</u>, www.thermaldesign.com.
- B. Requests for substitutions will be considered in accordance with provisions of Section 01600.

2.2 MATERIALS

- A. **Walls**: Simple Saver System consists of Blanket Insulation, Wall Insulation, Vapor Barrier Liner Fabric, Thermal Breaks, Straps, and other devices and components in a proprietary insulation system as follows:
 - 1. Wall Insulation: Formaldehyde-free fiberglass blanket or batt complying with ASTM C 991 Type 1, ASTM E 136 and ASTM E 84 with a thermal resistance and thickness as follows:
 - a. <u>R-19, 6" for existing 6.5 inch girts.</u>
 - 2. At walls: Vapor Barrier Liner Fabric: Syseal® type woven, reinforced, highdensity polyethylene yarns coated on both sides with a continuous white or colored polyethylene coatings, as follows:
 - a. Product complies with ASTM C 1136, Types I through Type VI.
 - b. Perm rating: 0.02 for fabric and for seams in accordance with ASTM E 96.
 - c. Flame/Smoke Properties:

- 1) 25/50 in accordance with ASTM E 84.
- 2) Self-extinguishes with field test using matches or butane lighter.
- d. Ultra violet radiation inhibitor to minimum UVMAX® rating of 8.
- e. Size and seaming: Manufactured in large custom pieces by triple extrusion welding from roll goods, and fabricated to substantially fit defined building area with minimum practicable job site sealing.
- f. Provide with factory triple, extrusion welded seams. Stapled seams or heat-melted seams are not acceptable due to degradation of fabric.
- g. Factory-folded to allow for rapid installation.
- h. Color:
 - 1) White.
- 3. Vapor Barrier Lap Sealant: Solvent-based, Simple Saver polyethylene fabric adhesive.
- 4. Vapor Barrier Tape: Double-sided sealant tape 3/4 inch (19 mm) wide by 1/32 inch (.79 mm) thick.
- 5. Vapor Barrier Patch Tape: Single-sided, adhesive backed sealant tape 3 inches (76 mm) wide made from same material as Syseal® type liner fabric.
- 6. Thermal Breaks:
 - a. 3/16 inch (4.7 mm) thick by 3 inch (76 mm) wide white, closed-cell polyethylene foam with pre-applied adhesive film and peel-off backing applied to existing building girts.
- 7. UVMAX Straps:
 - a. 100 KSI minimum yield tempered, high-tensile-strength steel.
 - b. Size: Not less than 0.020 inch (0.50 mm) thick by 1 inch (25 mm) by continuous length.
 - c. Galvanized, primed, and painted to match specified finish color on the exposed side.
 - d. Color:
 - 1) White.
- 8. Fasteners:

1.

- a. For light gage steel: #12 by 3/4 (19 mm) inch plated Tek 2 type screws with sealing washer, painted to match specified color.
- b. For heavy gage steel: #12 by 1-1/2 inch (38 mm) plated Tek 4 type screws with sealing washer, painted to match specified color.
- 9. Wall Insulation Hangers: Fast-R preformed rigid hangers, 32 inch (813 mm) long galvanized steel strips with barbed arrows every 8 inches (203 mm) along its length.
- B. **Roof:** Simple Saver System consists of Perforated Liner Fabric, Straps, and other devices and 07213-3 components in a proprietary insulation system as follows:
 - Vapor Barrier Liner Fabric: Syseal® type woven, reinforced, highdensity polyethylene yarns coated on both sides with a continuous white or colored polyethylene coatings, as follows:
 - a. Product complies with ASTM C 1136, Types I through Type VI.
 - b. Syseal liner system fabric perm rating shall not function as a vapor retarder but shall be perforated with 3/16" minimum holes spaced not more than four (4") inches apart in each direction.
 - c. Flame/Smoke Properties:
 - 1) 25/50 in accordance with ASTM E 84.
 - 2) Self-extinguishes with field test using matches or butane lighter.
 - d. Ultra violet radiation inhibitor to minimum UVMAX® rating of 8.
 - e. Size and seaming: Manufactured in large custom pieces by triple extrusion welding from roll goods, and fabricated to substantially fit defined building area with minimum practicable job site sealing.
 - f. Provide with factory triple, extrusion welded seams. Stapled

seams or heat-melted seams are not acceptable due to degradation of fabric.

- g. Factory-folded to allow for rapid installation.
- h. Color:
- 1) White.
- 2. Vapor Barrier Lap Sealant: Solvent-based, Simple Saver polyethylene fabric adhesive.
- 3. Vapor Barrier Tape: Double-sided sealant tape 3/4 inch (19 mm) wide by 1/32 inch (.79 mm) thick.
- 4. Vapor Barrier Patch Tape: Single-sided, adhesive backed sealant tape 3 inches (76 mm) wide made from same material as Syseal® type liner fabric
- 5. UVMAX Straps:
 - a. 100 KSI minimum yield tempered, high-tensile-strength steel.
 - b. Size: Not less than 0.020 inch (0.50 mm) thick by 1 inch (25 mm) by continuous length.
 - c. Galvanized, primed, and painted to match specified finish color on the exposed side.
 - d. Color:
 - 1) White.
- 6. Fasteners:
 - a. For light gage steel: #12 by 3/4 (19 mm) inch plated Tek 2 type screws with sealing washer, painted to match specified color.

PART 3 EXECUTION

3.1 EXAMINATION

- A. Verify that building structure including all bracing and any concealed building systems are completed and approved prior to installing liner system and insulation in the structure.
- B. Correct any unsatisfactory conditions before proceeding.
- C. If conditions are the responsibility of another installer, notify Architect of unsatisfactory preparation before proceeding.

3.2 INSTALLATION - GENERAL

- A. Install pre-engineered building insulation system in accordance with manufacturer's installation instructions and the approved shop drawings.
- B. Prepare surfaces using the methods recommended by the manufacturer for achieving the best result for the substrate under the project conditions.
- C. Install in exterior spaces without gaps or voids. Do not compress insulation.
- D. Trim insulation neatly to fit spaces. Insulate miscellaneous gaps and voids.
- E. Fit insulation tight in spaces and tight to exterior side of the sealed liner fabric and around mechanical and electrical services within plane of insulation.

F. Verify penetrations in existing roof are patch and filled with insulation compatible with existing system.

3.3 WALL INSULATION INSTALLATION

A. Insulation:

- 1. Install thermal break to exterior surface of girts as wall sheathing is applied.
- 2. Install self-sticking foam thermal break to interior surface of girts prior to installation of insulation.
- 3. Position and secure Fast-R hangers to girts on the inside face of the wall sheathing.
- 4. Cut insulation to required lengths to fit vertically between girts.
- 5. Fluff the insulation to the full-specified thickness.
- 6. Neatly position in place and secure to Fast-R hangers.
- 7. Ensure that cavities are filled completely with insulation.
- B. Vapor Barrier Fabric:
 - 1. Install vapor barrier fabric in large one-piece custom fabricated pieces to substantially fit defined building areas with minimum practicable job site sealing.
 - 2. Apply the vapor barrier fabric by clamping it in position over eave strap and installing fasteners through the eave strap into each roof strap, permanently clamping the wall fabric between them.
 - 3. Once in position, draw the vapor barrier fabric down over the column flanges to the base angle and install vertical straps along each column and 5 feet 0 inches on center, maximum, fastening to each girt to retain system permanently in place.
 - 4. All seams must be completely sealed and stapled seams not acceptable.

C. Seal wall fabric to the roof fabric, to the base angle and up the columns to provide a continuous vapor barrier.

3.4 ROOF INSULATION INSTALLATION

A. Straps:

1. Cut straps to length and install in the pattern and spacings indicated on shop drawings.

- 2. Tension straps to required value.
- B. Roof Liner Fabric:
 - 1. Install fabric in large one-piece custom fabricated pieces to substantially fit defined building areas with minimum practicable job site sealing.
 - 2. Position pre-folded fabric on the strap platform along one eave purlin.
 - 3. Clamp the two bottom corners at the eave and also centered on the bay.

4. Pull the other end of the pleat-folded fabric across the building width on the strap platform, pausing only at the ridge to fasten the straps and fabric in position where plane of roof changes and to release temporary fasteners on the opposite ridge purlins.


5. Once positioned, install fasteners from the bottom side at each strap/purlins intersection.

- 6. Trim edges and seal along the rafters.
- 7. All seams must be completely sealed and stapled seams not acceptable.
- C. Seal liner fabric to the wall fabric.
- 3.5 CLEANING
 - A. Clean dirt or exposed sealant from the exposed vapor barrier fabric.
 - B. Remove scraps and debris from the site.
- 3.6 PROTECTION

- A. Protect system products until completion of installation.
- B. Repair or replace damaged products before completion of insulation system installation.

END OF SECTION

0	
9 INCH	
0 3" = 1'-0"	
3 SCALE	
12 INCH	
0 = 1'-0"	
12 0 SCALE 1-1/2" = 1'-0"	
2 3 FEET	
- -	
0 3/4" = 1'-0"	
1 SCALE	
FEET 5	
т	
1 2 1/2" = 1'-0"	
1 0 SCALE	
FEET 10	
8 9	
2 4 1/4" = 1'-0"	
2 0 2	
15 20	
9	
) 5 1/8" = 1'-0'	
5 0 SCALE	
35 40 45	
25 30 35	
10 15 20 1/16" = 1'-0"	
5 0 5 1 SCALE 1/1	
30 1911 30	WMNS 34 9 OFFICE 4
20 25	MENS 34 29 29 29
10 15 0"	
5 3/32" = 1'	1/16" = 1'-0"
5 0 SCALE	1/16" = 1'-0"

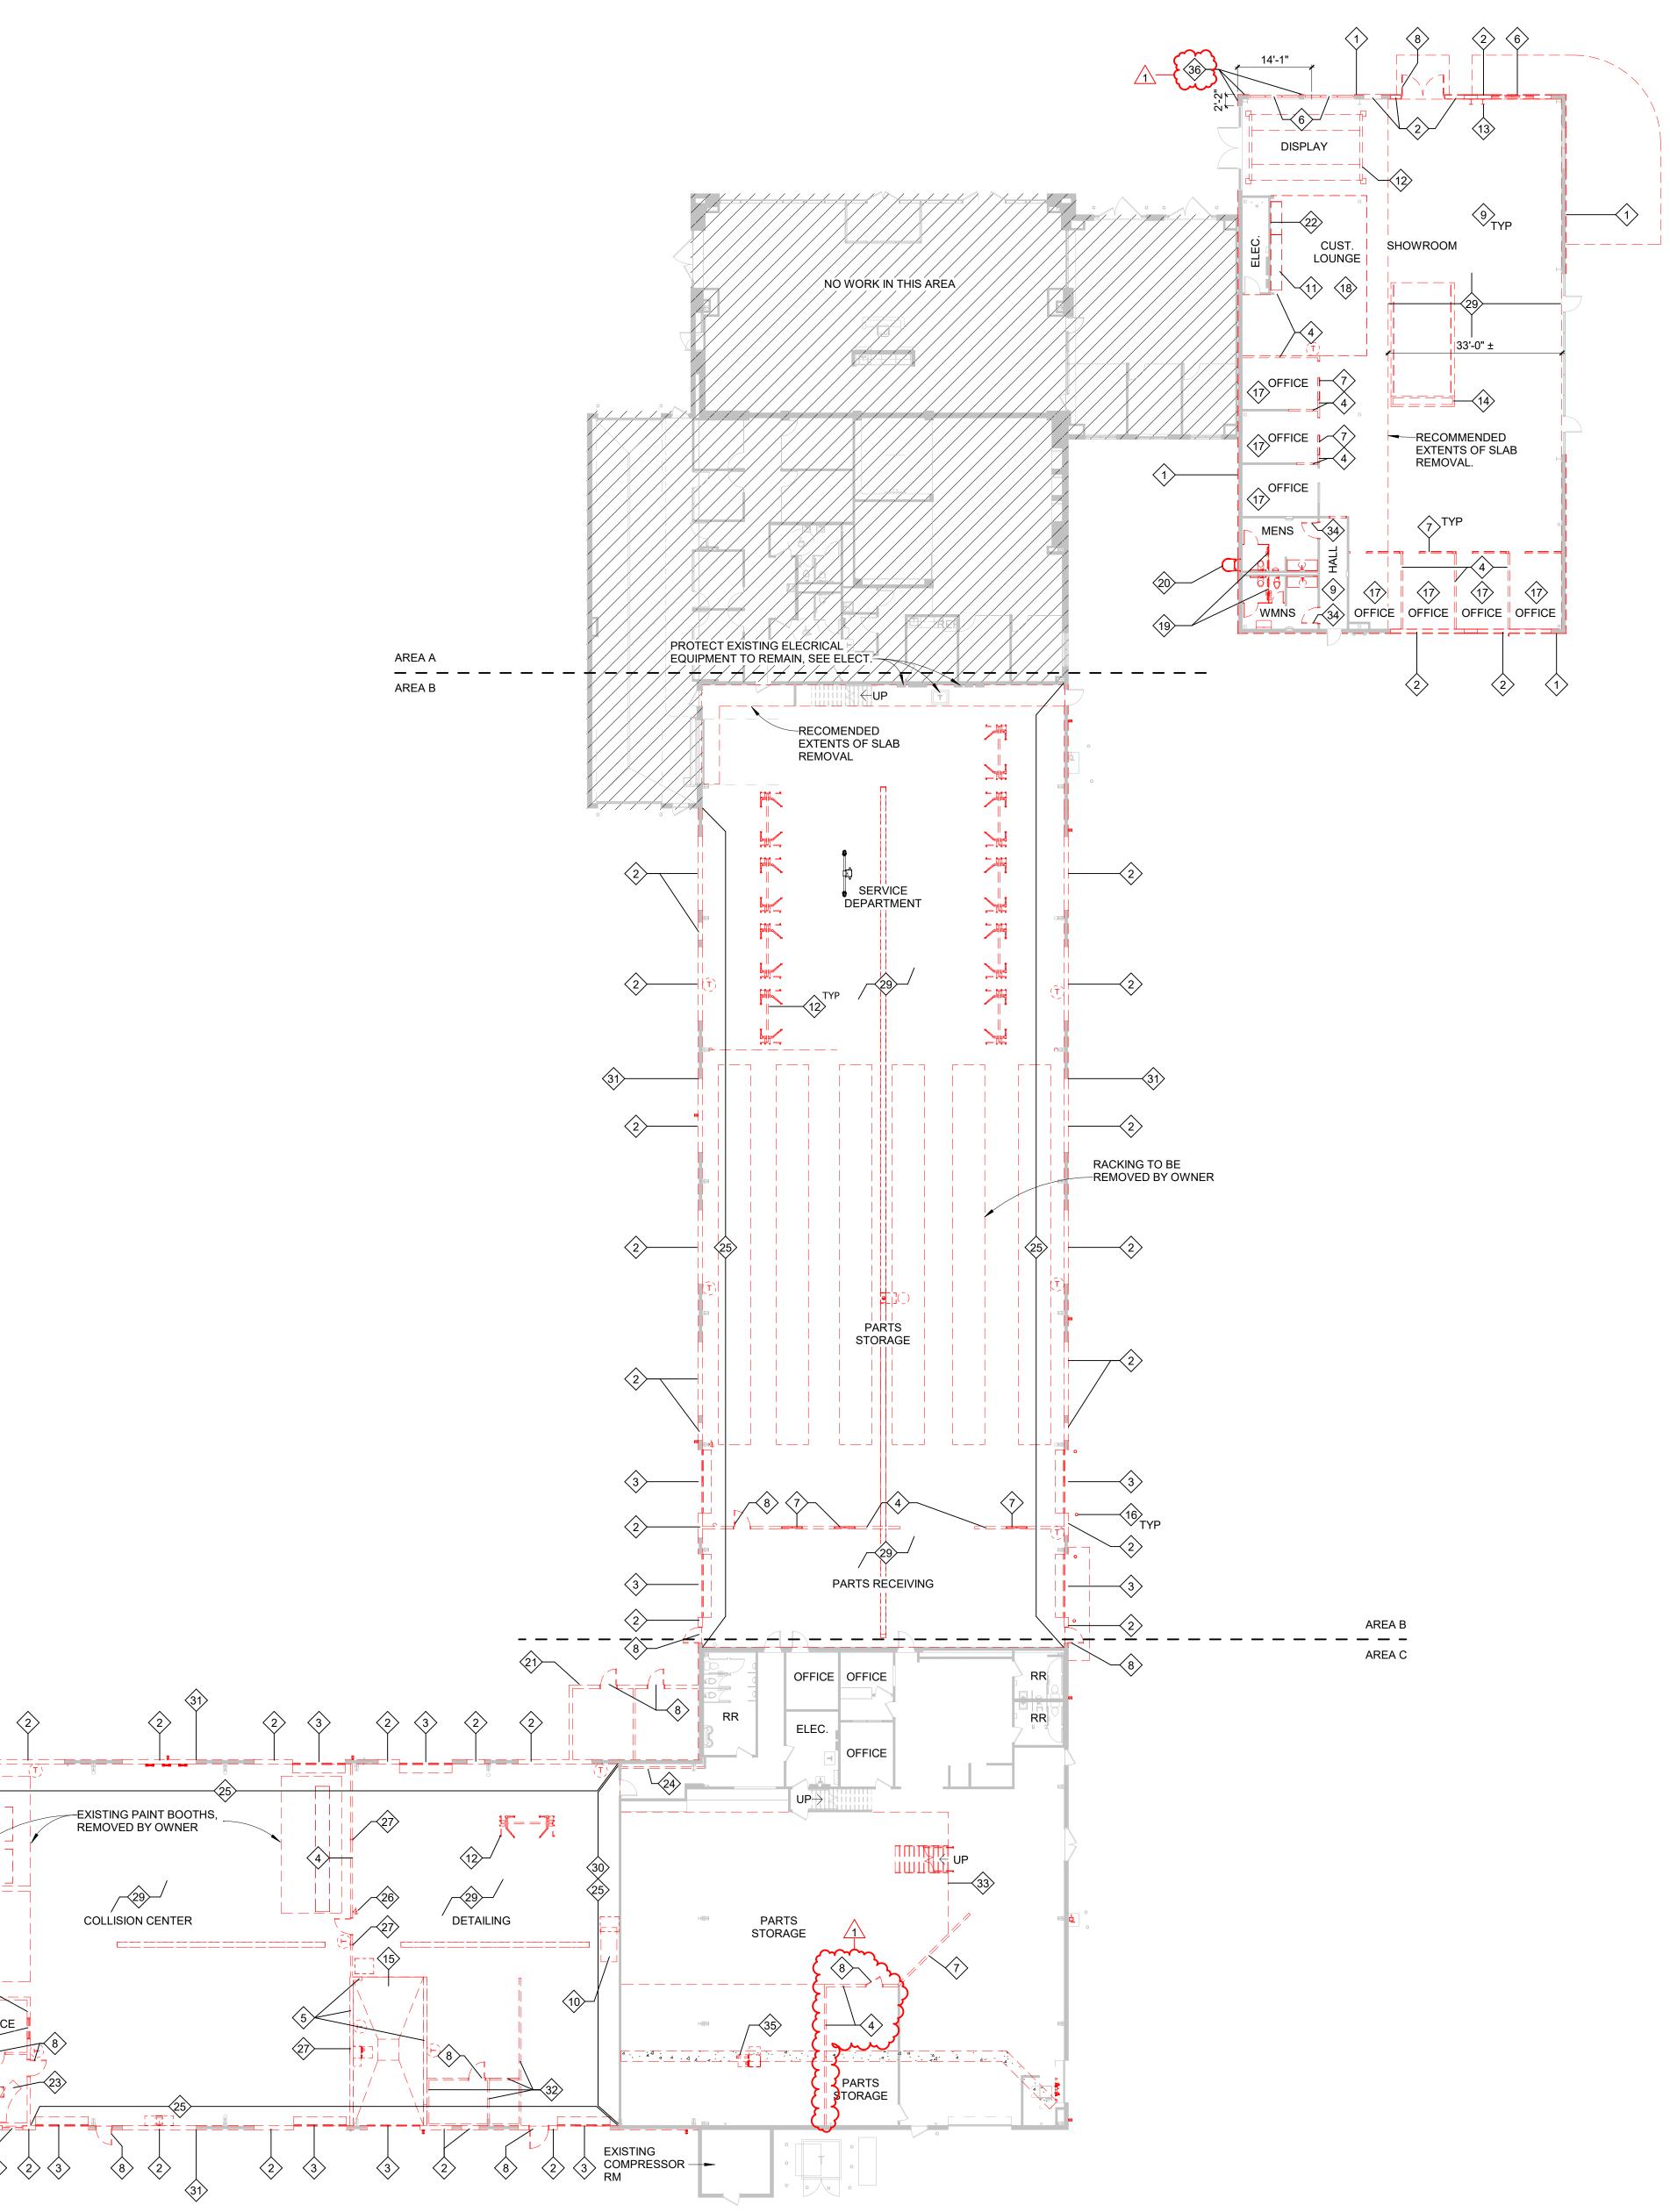

MO PLAN

GENERAL DEMOLITION NOTES

- REFERENCE STANDARDS


 A. 29 CFR 1926 U.S. OCCUPATIONAL SAFETY AND HEALTH STANDARDS; CURRENT EDITION.
 B. NFPA 241 - STANDARD FOR SAFEGUARDING
- CONSTRUCTION, ALTERATION, AND DEMOLITION OPERATIONS; 2019.
- 2. COMPLY WITH APPLICABLE CODES AND REGULATIONS FOR DEMOLITION OPERATIONS AND SAFETY OF ADJACENT STRUCTURES AND THE PUBLIC
- 3. QUALITY ASSURANCE
 A. DEMOLITION FIRM QUALIFICATIONS: COMPANY
- SPECIALIZING IN THE TYPE OF WORK REQUIRED. B. MINIMUM OF FIVE YEARS OF DOCUMENTED EXPERIENCE. 4. DO NOT BEGIN REMOVAL WORK UNTIL RECEIPT OF
- NOTIFICATION TO PROCEED FROM OWNER. 5. VERIFY EXISTING FIELD CONDITIONS, REPORT DISCREPANCIES TO ARCHITECT.
- DEMOLITION WORK AS SHOWN ON THE DRAWINGS IS TO INDICATE, IN A GENERAL MANNER, THE REMOVAL OFF EXISTING CONSTRUCTION AND IS NOT INTENDED TO BE INCLUSIVE. PROVIDE ALL DEMOLITION REQUIRED TO ACCOMMODATE OR INSTALL ALL WORK FOR ALL TRADES. VERIFY CONDITIONS AT BUILDING SITE.
- FILL EXCAVATIONS, OPEN PITS, AND HOLES IN GROUND AREAS GENERATED AS RESULT OF REMOVALS, USING SPECIFIED FILL; COMPACT FILL IN CIVIL DOCUMENTS.
- SHORING AND BRACING: PROVIDE AND MAINTAIN INTERIOR AND EXTERIOR SHORING AND BRACING.
 LOCATE, IDENTIFY, DISCONNECT, AND SEAL OR CAP OFF
- UTILITIES IN BUILDINGS TO BE DEMOLISHED. 10. REFER TO CIVIL, MECHANICAL, PLUMBING AND ELECTRICAL DRAWINGS FOR REQUIRED DEMOLITION AND FOR ITEMS TO
- REMAIN IN AREAS OF DEMOLITION. 11. REMOVE ALL FLOOR/WALL/CEILING MOUNTED ITEMS, DEVICES, CONDUIT, ETC. TO ACCOMMODATE NEW WORK
- SEPARATE AREAS IN WHICH DEMOLITION IS BEING CONDUCTED FROM OTHER AREAS THAT ARE STILL OCCUPIED.
 PROVIDE, ERECT, AND MAINTAIN TEMPORARY DUSTPROOF PARTITIONS OF CONSTRUCTION APPRORPRIATE FOR THE TASK
- AND IN LOCATIONS AS DECIDED BY CONSTRUCTION MANAGER AND OWNER.
 14. CONDUCT OPERATIONS TO MINIMIZE OBSTRUCTION OF PUBLIC AND PRIVATE ENTRANCES AND EXITS; DO NOT OBSTRUCT
- REQUIRED EXITS AT ANY TIME; PROTECT PERSONS USING ENTRANCES AND EXITS FROM REMOVAL OPERATIONS.
 15. PROTECT EXISTING CONSTRUCTION TO REMAIN. ALL CONSTRUCTION TO REMAIN WHICH AFFECTED BY DEMOLITION SHALL BE PATCHED, REPAIRED, PROPERLY MEMBERED, AND ALIGNED AS TO LEAVE NO EVIDENCE OF REPAIR.
- CLEAN AND PREPARE ALL SURFACES SCHEDULED TO RECEIVE NEW FINISHES.
 CONTRACTOR SHALL BE RESPONSIBLE FOR DISPOSAL OF ALL ITEMS NOT REMOVED BY OWNER. OWNER RESERVES THE
- RIGHT TO SALVAGE ITEMS REMOVED BY CONTRACTOR.

FLOOR PLAN DEMO NOTES


- 1 REMOVE METAL WALL PANEL OF EXISTING EXTERIOR WALL AS REQUIRED TO INSTALL NEW METAL PANEL. SEE ELEVATIONS.
- 2 REMOVE EXISTING EXTERIOR WALL ASSEMBLY FOR NEW OPENING. COORDINATE WITH NEW CONSTRUCTION.
- 3 REMOVE EXISTING OVERHEAD DOOR COMPLETE.4 REMOVE EXISTING WALL CONSTRUCTION COMPLETE.
- 5 REMOVE EXISTING HALF-HEIGHT CMU WALL COMPLETE.
 6 REMOVE EXISTING STOREFRONT COMPLETE. SEE ELEVATIONS FOR LOCATIONS.
- 7 REMOVE EXISTING INTERIOR STOREFRONT COMPLETE.
 8 REMOVE EXISTING DOOR, FRAME AND HARDWARE COMPLETE.
 9 DEMOVE EXISTING ELOOD THE AND BASE. CLEAN/DRED ELOOD
- 9 REMOVE EXISTING FLOOR TILE AND BASE. CLEAN/PREP FLOOR AND WALL FOR INSTALLATION OF NEW FINISH FLOOR. COORDINATE WITH EXISTING CONSTRUCTION.
 10 HOTSY EQUIPMENT, REMOVED BY OWNER. PATCH ROOF DENETRATIONS
- PENETRATIONS. 11 REMOVE EXISTING CASEWORK COMPLETE.
- 12 REMOVE EXISTING SERVICE LIFT COMPLETE. SALVAGE FOR OWNER.
- 13 REMOVE EXISTING STRUCTURAL STEEL COLUMN. SEE STRUCTURAL DRAWINGS FOR COMPLETE EXTENTS.
- REMOVE EXISTING CAR DISPLAY FEATURE.
 REMOVE EXISTING THICKEND SLAB.
- REMOVE EXISTING BOLLARD.
 REMOVE EXISTING CARPET AND WALL BASE.
- 18 REMOVE EXISTING VINYL FLOOR.
 19 REMOVE EXISTING FLOOR TILE AND BASE. REMOVE ALL EXISTING GRAB BARS AND TOILET ACCESSORIES (PROTECT OR SALVAGE RECESSED TOWEL DISPENSER COMBO FOR REUSE). REMOVE ALL EXISTING PLUMBING FIXTURES AND MIRRORS, REMOVE ALL COUNTERTOPS, AND ALL TOILET
- PARTITIONS COMPLETE. CLEAN/PREP FLOOR AND WALL FOR INSTALLATION OF NEW FINISH FLOOR.
 20 REMOVE EXISTING ROOF LADDER AS REQUIRED FOR NEW
- WORK, SALVAGE FOR REINSTALLATION.
 21 REMOVE PORTION OF EXISTING METAL BUILDING COMPLETE. COORDINATE WITH NEW CONSTRUCTION.
- 22 REMOVE EXISTING METAL PANEL.
 23 REMOVE EXISTING RECEPTION DESK COMPLETE.
 24 DEMO WALL AS REQUIRED FOR NEW STRUCTURAL
- 24 DEMO WALL AS REQUIRED FOR NEW STRUCTURAL CONNECTION.
 25 REMOVE EXISTING LINER PANEL.
- 26 REMOVE EXISTING EVE WASH STATION, SEE MECH. 27 DEMOVE EXISTING COLUMN: OFFICE OFFICE
- 27 REMOVE EXISTING COLUMN, SEE STRUCT.28 REMOVE EXISTING FURRING WALL, COMPLETE.
- 29 REMOVE CONC. FLOOR SLAB COMPLETE
 30 REMOVE EXISTING GWB ABOVE LINER PANEL.

<u>/1\</u>_

- 31 COORDINATE REMOVAL OF EXTERIOR WALL PANEL WITH STRUCTURAL MODIFICATIONS AT NEW OPENINGS. SALVAGE PANELS FOR RE-USE.
- REMOVE EXISTING HALF-HEIGHT WOOD FRAMED WALL ASSEMBLIES COMPLETE.
- REMOVE EXISTING, WOOD FRAMED MEZZANINE AND STAIR ASSEMBLY COMPLETE.
 NEW POOD WERE AND STAIR
- 34 NEW DOOR IN EXISTING FRAME TO REMAIN. SEE DOOR SCHEDULE.
 25 DI LIMPINIO TRENIOU OFFICIAL OF
- 35 PLUMBING TRENCH, SEE PLUMBING DRAWINGS. - 36 REMOVE EXISTING 1/2" PLYWOOD SHEATHING AS SHOWN ON DRAWING IN PREP FOR NEW 3/4" SHEATHING.

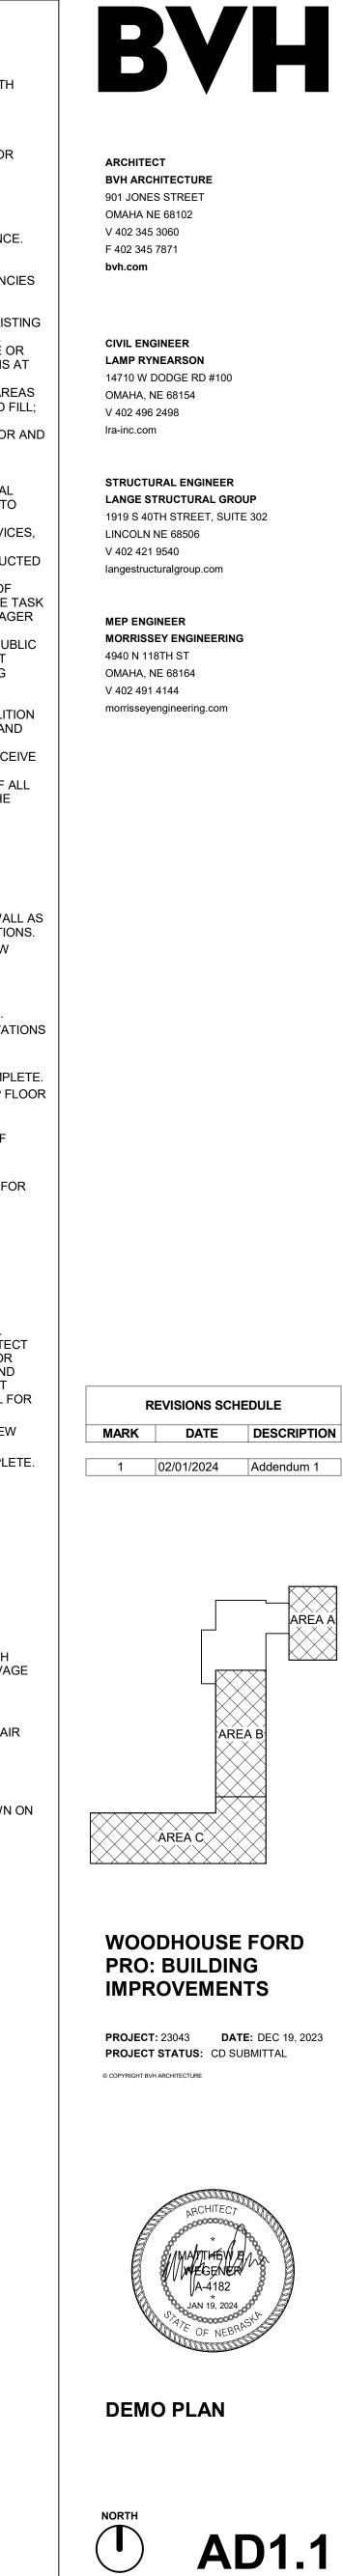

—	
0 INCH	
ω	
۳ •	
3" = 1'-0"	
3 SCALE	
_ო ∎ °	
- ∎ ⁻	
INCH	
= 1-0	
/2" = 1	
12 SCALE 1-1/2" = -	
€ ■	
3 FEET	
~	
1 3/4" = 1'-0"	
0 3/4" =	
1 SCALE	-
5 FEET	
4 T	
m	
0_ 7	
- -	
1/2" =	
1 0 SCALE	
[−] S	
1 1	
8 10 FEET	
G	
2 1/4" = 1	
2 0 SCALE	
∾ ■	
20 FEET	
15 FE	
6	
5 = 1'-0"	
5 1/8" = 1	
5 0 SCALE	
45 0 T	
0	
HEE.	
22 30	
- 20	
= 1'-0	
0 2 ALE	
5 0 5 SCALE	
8 🗖	
25 25 FEET	
50	
τ <u>τ</u>	
10 = 1'-0"	
5 3/32" :	
5 0 SCALE (21/2024 11:35:07 AM	
5 SC/	1" = 30'-0"

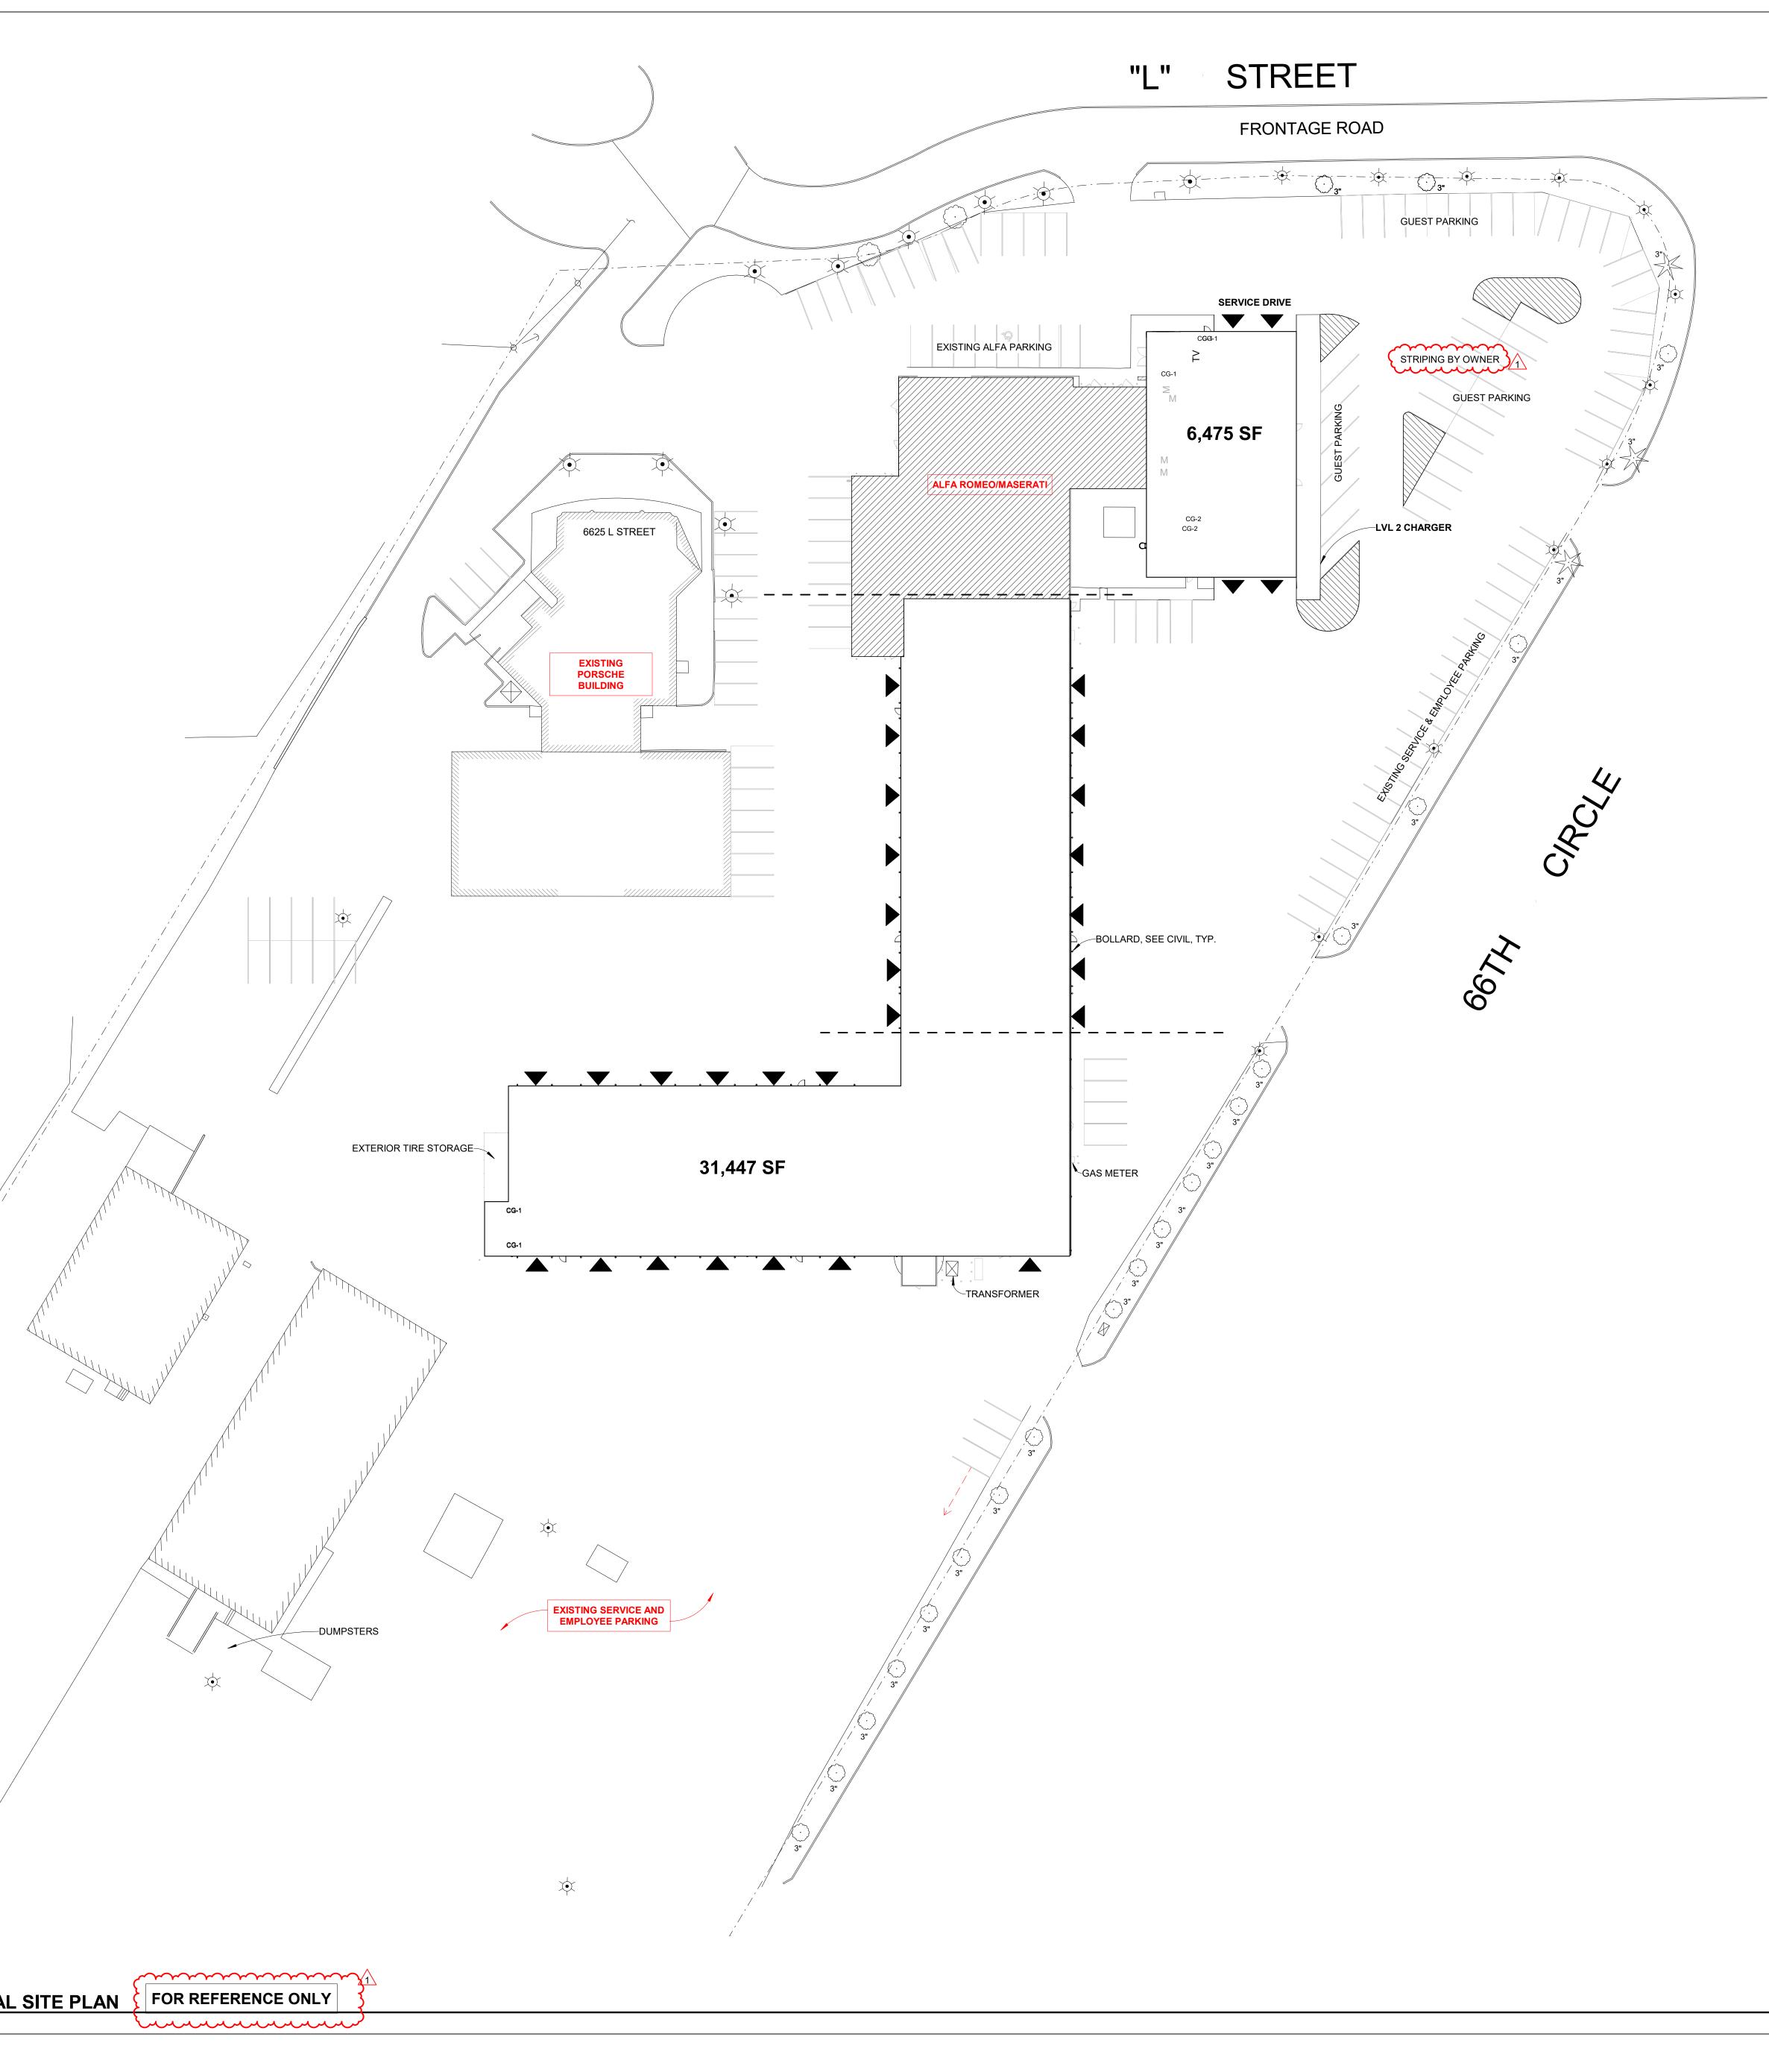




CIVIL ENGINEER LAMP RYNEARSON 14710 W DODGE RD #100 OMAHA, NE 68154 V 402 496 2498 Ira-inc.com

STRUCTURAL ENGINEER LANGE STRUCTURAL GROUP 1919 S 40TH STREET, SUITE 302 LINCOLN NE 68506 V 402 421 9540 langestructuralgroup.com


MEP ENGINEER MORRISSEY ENGINEERING 4940 N 118TH ST OMAHA, NE 68164 V 402 491 4144 morrisseyengineering.com

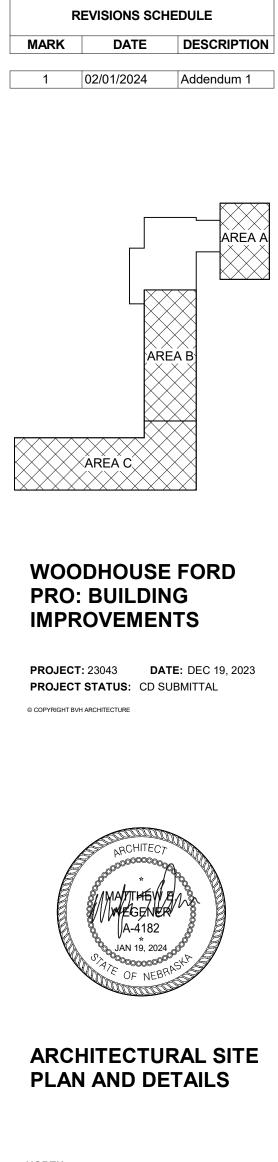





3 6 9 1-0" INCH			<u>1</u> - <u>(2-17) (X.1) (X.1</u>)
12 3 0 SCALE 3"=	EX.D	AREA A	
12 0 12 SCALE 1-1/2" = 1'-0" INCH	EX.E Q-17		
1 0 1 2 3 SCALE 3/4" = 1'-0" FEET	EX.P—	3 A4.1	
1 0 1 2 3 4 5	EX.G	1 A3.2	
2 0 2 4 6 8 10	EX.H	PAINTED SAFETY STRIPING, TYP	12 ⁻⁶
5 0 5 10 15 20			
20 25 30 35 40 45 FEET	EX.)		
25 30 5 0 5 10	EX.K		
5 0 5 10 15 20 SCALE 3/32" = 1'-0"		AREA B AREA C 2 FIRS 1/8" = 1'-1	

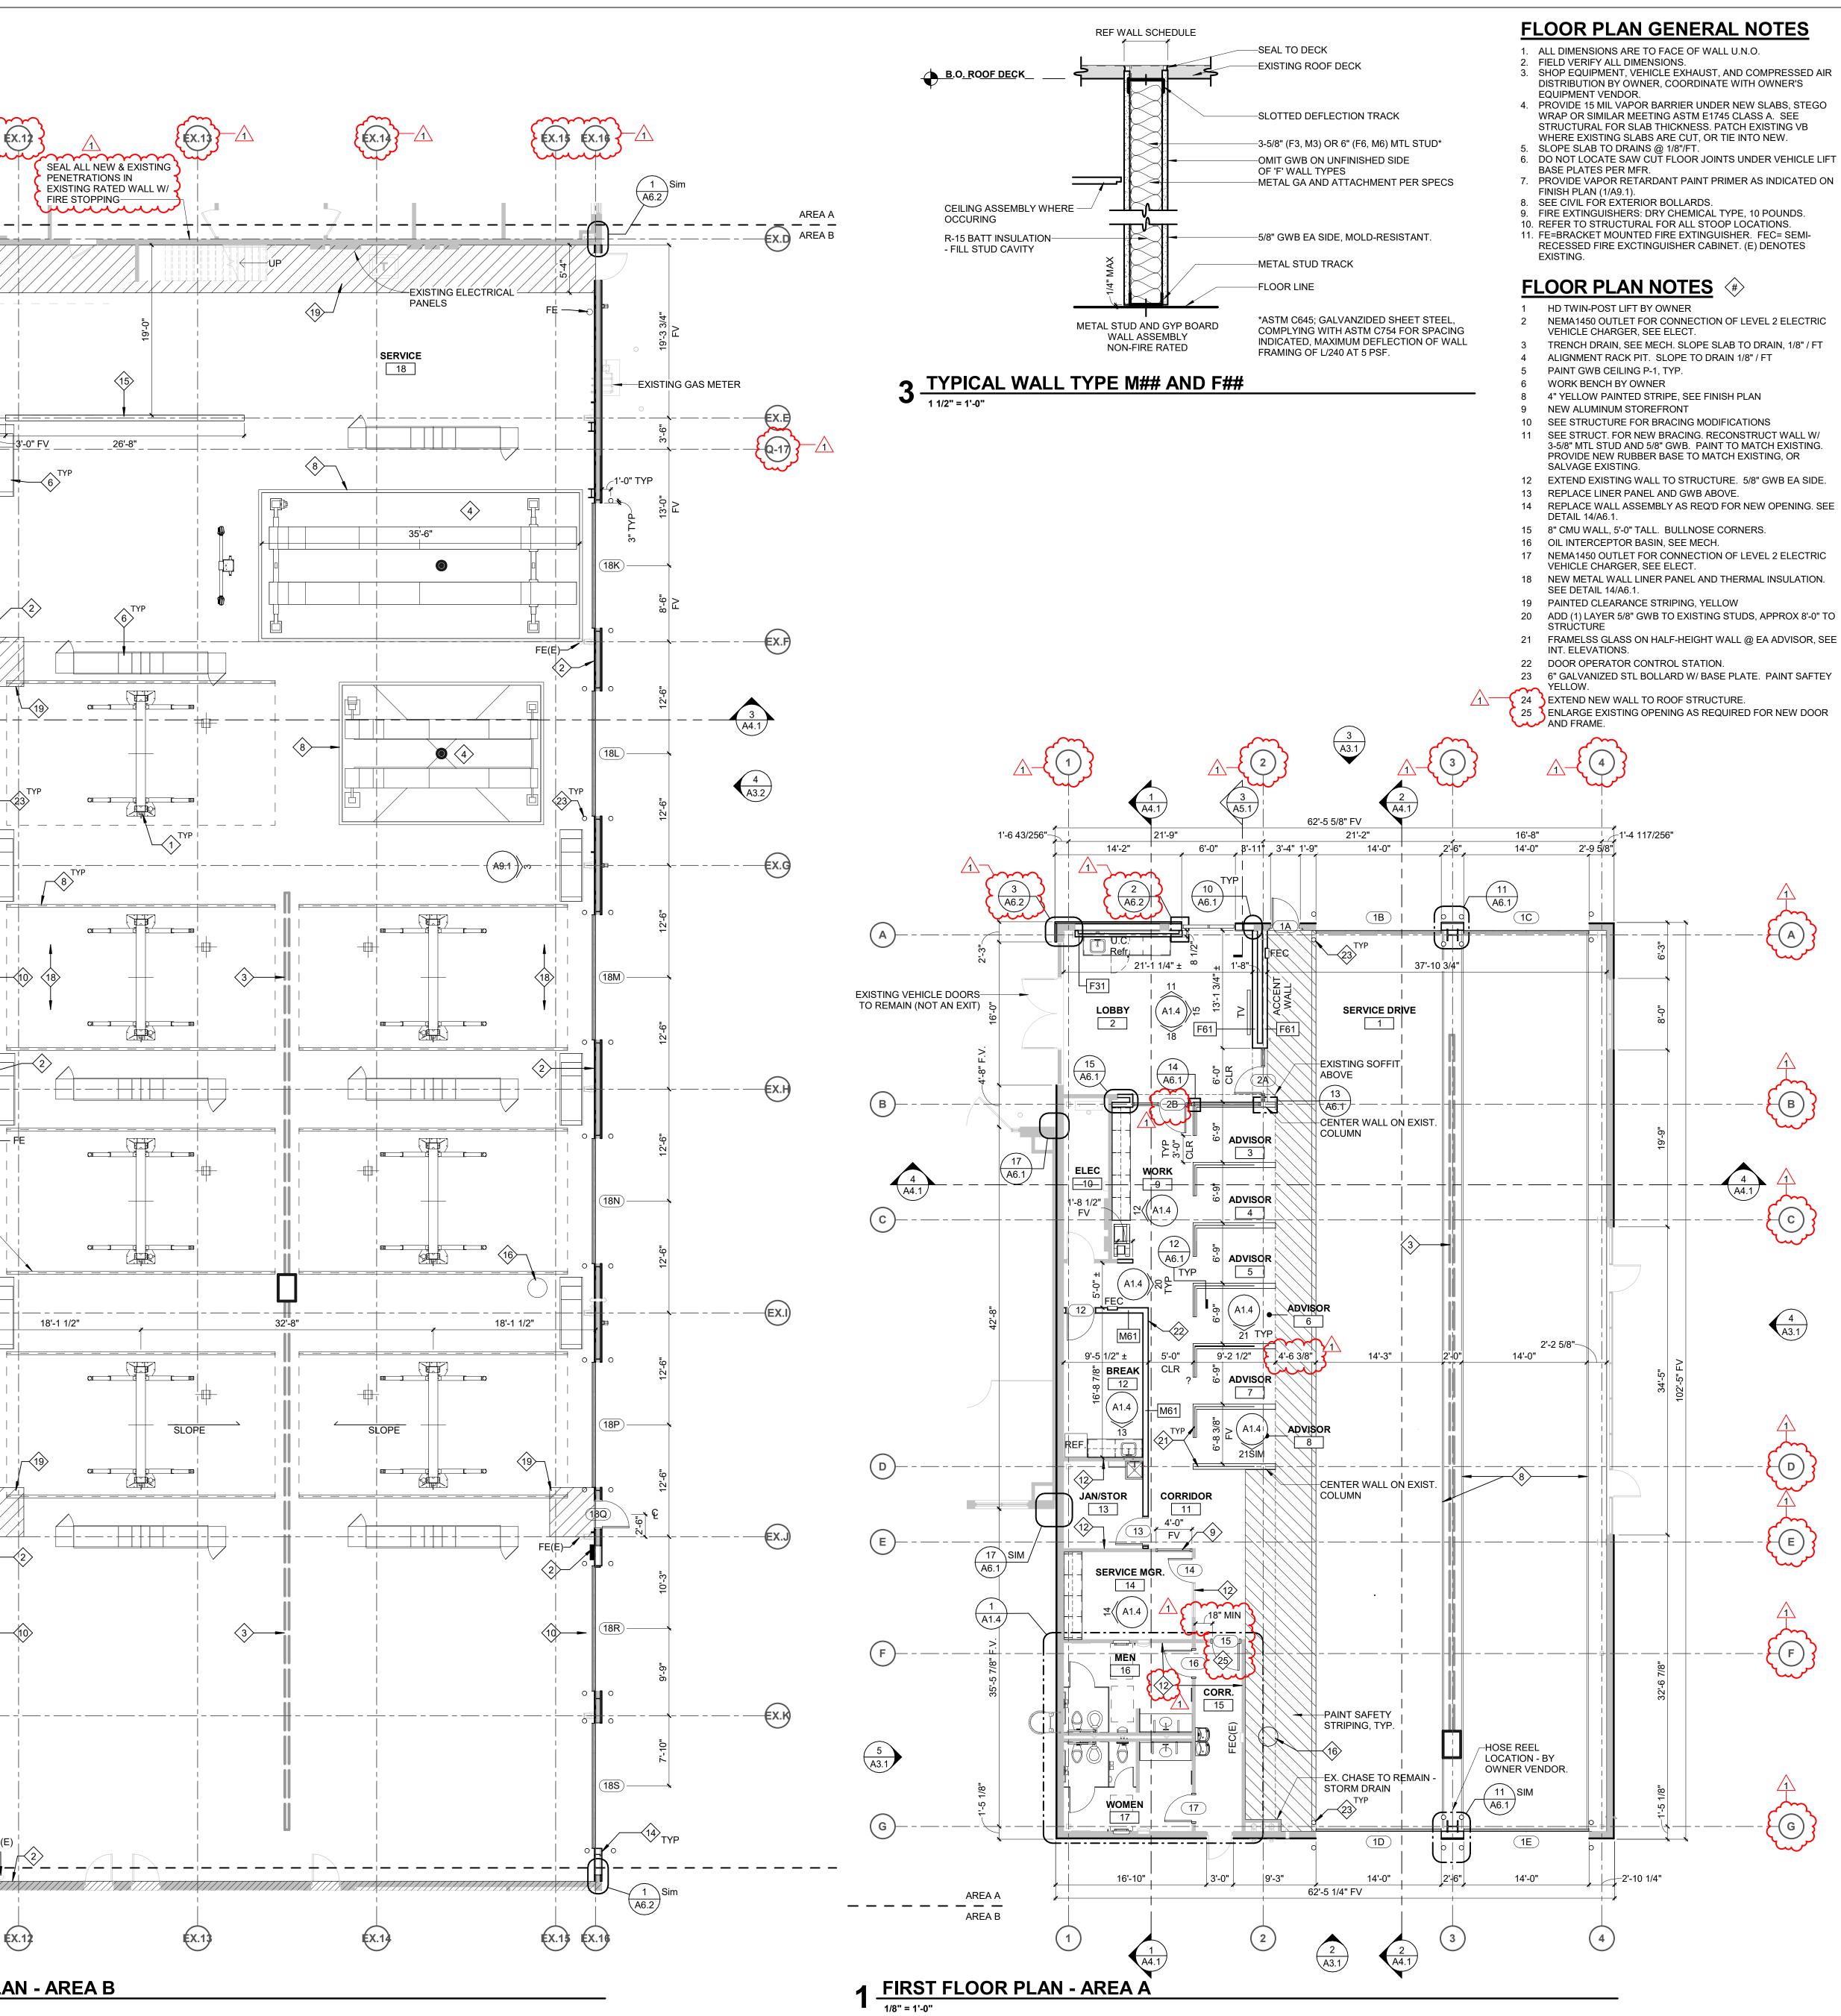





CIVIL ENGINEER LAMP RYNEARSON 14710 W DODGE RD #100 OMAHA, NE 68154 V 402 496 2498 Ira-inc.com


STRUCTURAL ENGINEER LANGE STRUCTURAL GROUP 1919 S 40TH STREET, SUITE 302 LINCOLN NE 68506 V 402 421 9540 langestructuralgroup.com

MEP ENGINEER MORRISSEY ENGINEERING 4940 N 118TH ST OMAHA, NE 68164 V 402 491 4144 morrisseyengineering.com

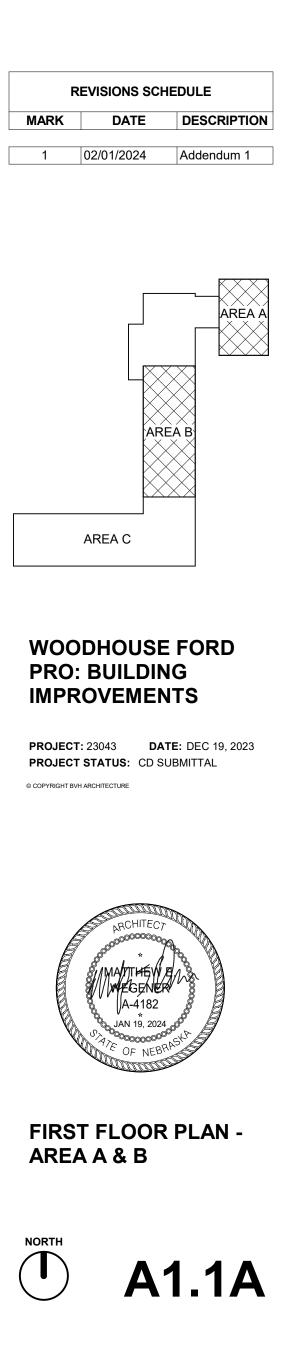

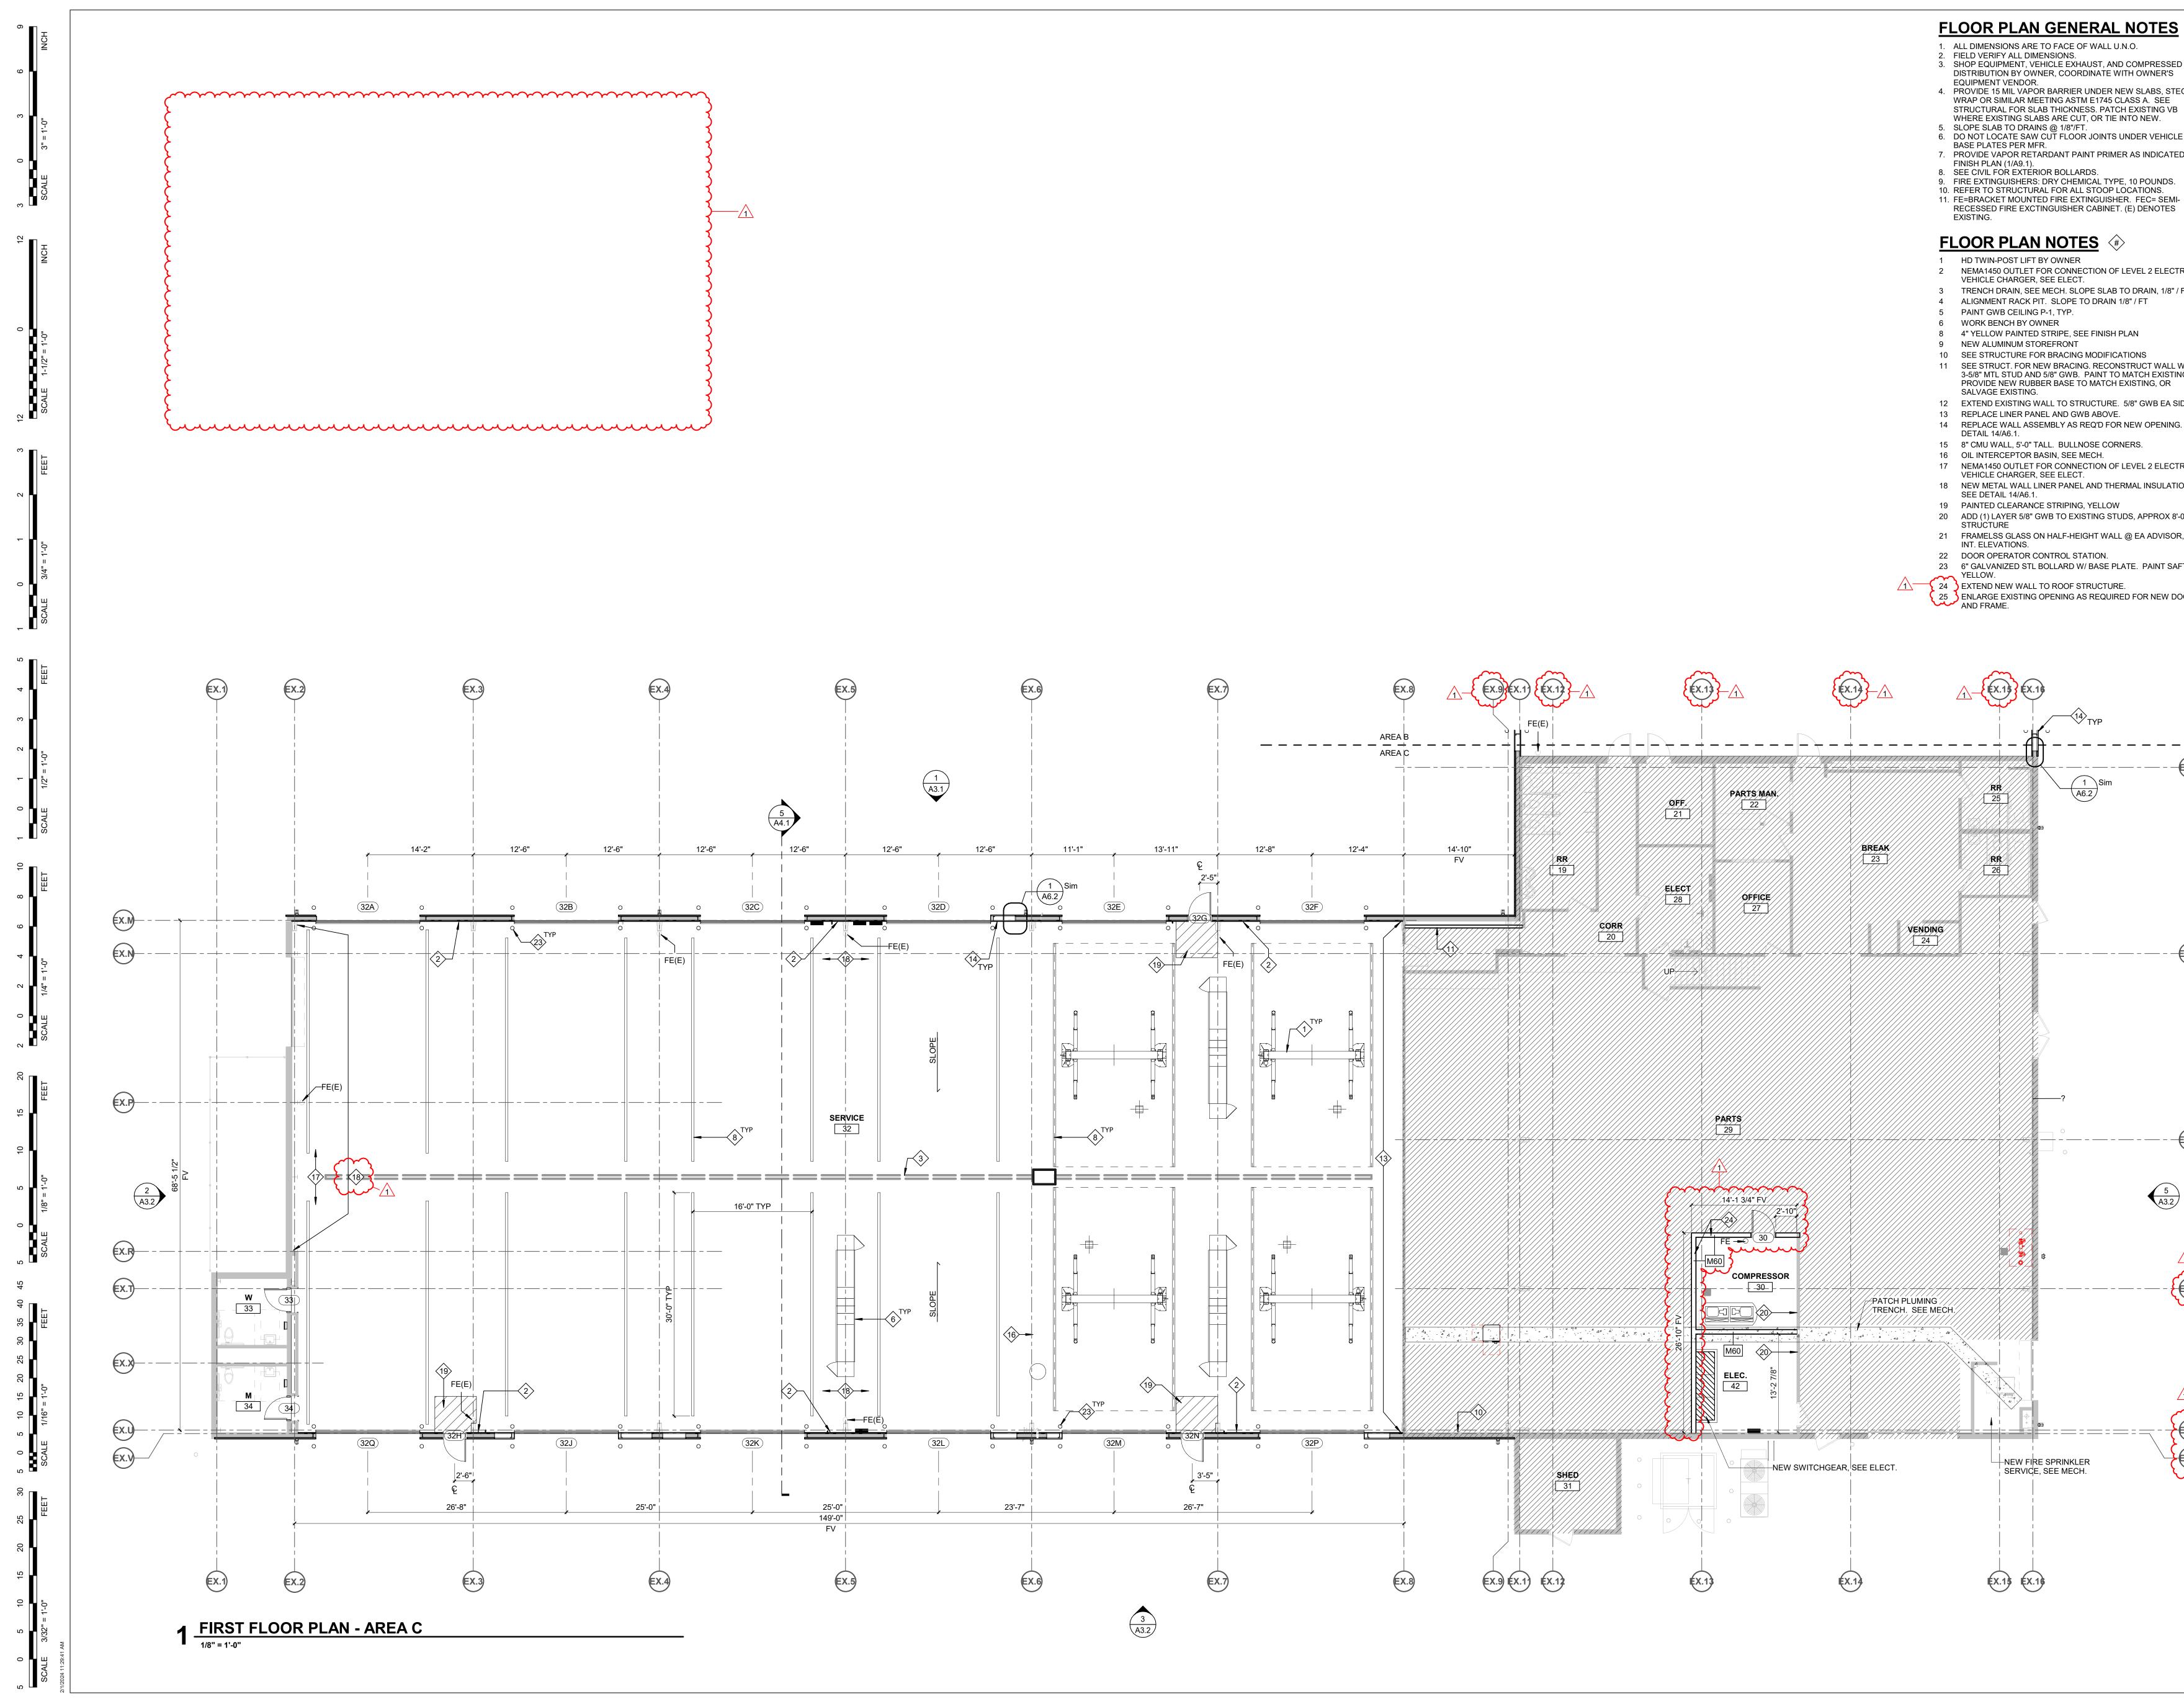

BVH 3. SHOP EQUIPMENT, VEHICLE EXHAUST, AND COMPRESSED AIR DISTRIBUTION BY OWNER, COORDINATE WITH OWNER'S 4. PROVIDE 15 MIL VAPOR BARRIER UNDER NEW SLABS, STEGO WRAP OR SIMILAR MEETING ASTM E1745 CLASS A. SEE STRUCTURAL FOR SLAB THICKNESS. PATCH EXISTING VB ARCHITECT **BVH ARCHITECTURE** 6. DO NOT LOCATE SAW CUT FLOOR JOINTS UNDER VEHICLE LIFT 901 JONES STREET OMAHA NE 68102 7. PROVIDE VAPOR RETARDANT PAINT PRIMER AS INDICATED ON V 402 345 3060 F 402 345 7871 bvh.com RECESSED FIRE EXCTINGUISHER CABINET. (E) DENOTES CIVIL ENGINEER LAMP RYNEARSON 14710 W DODGE RD #100 OMAHA, NE 68154 2 NEMA1450 OUTLET FOR CONNECTION OF LEVEL 2 ELECTRIC V 402 496 2498 Ira-inc.com 3 TRENCH DRAIN, SEE MECH. SLOPE SLAB TO DRAIN, 1/8" / FT STRUCTURAL ENGINEER LANGE STRUCTURAL GROUP 1919 S 40TH STREET, SUITE 302 LINCOLN NE 68506 V 402 421 9540 11 SEE STRUCT. FOR NEW BRACING. RECONSTRUCT WALL W/ 3-5/8" MTL STUD AND 5/8" GWB. PAINT TO MATCH EXISTING. langestructuralgroup.com PROVIDE NEW RUBBER BASE TO MATCH EXISTING, OR 12 EXTEND EXISTING WALL TO STRUCTURE. 5/8" GWB EA SIDE. MEP ENGINEER MORRISSEY ENGINEERING 14 REPLACE WALL ASSEMBLY AS REQ'D FOR NEW OPENING. SEE 4940 N 118TH ST OMAHA, NE 68164 V 402 491 4144 17 NEMA1450 OUTLET FOR CONNECTION OF LEVEL 2 ELECTRIC morrisseyengineering.com 18 NEW METAL WALL LINER PANEL AND THERMAL INSULATION. 20 ADD (1) LAYER 5/8" GWB TO EXISTING STUDS, APPROX 8'-0" TO 21 FRAMELSS GLASS ON HALF-HEIGHT WALL @ EA ADVISOR, SEE 23 6" GALVANIZED STL BOLLARD W/ BASE PLATE. PAINT SAFTEY 25 ENLARGE EXISTING OPENING AS REQUIRED FOR NEW DOOR AND FRAME. **REVISIONS SCHEDULE** DATE DESCRIPTIO 1 02/01/2024 Addendum 1 — - — - — - — - — - — - — Ex.0) - - (Ex.g) 5 A3.2 XAREA C $(\times \times \times \times \times \times$ WOODHOUSE FORD **PRO: BUILDING** - (EX.S) IMPROVEMENTS **PROJECT:** 23043 **DATE:** DEC 19, 2023 PROJECT STATUS: CD SUBMITTAL © COPYRIGHT BVH ARCHITECTURE EX.U _{€X.V} A-4182 FIRST FLOOR PLAN -AREA C NORTH A1.2B

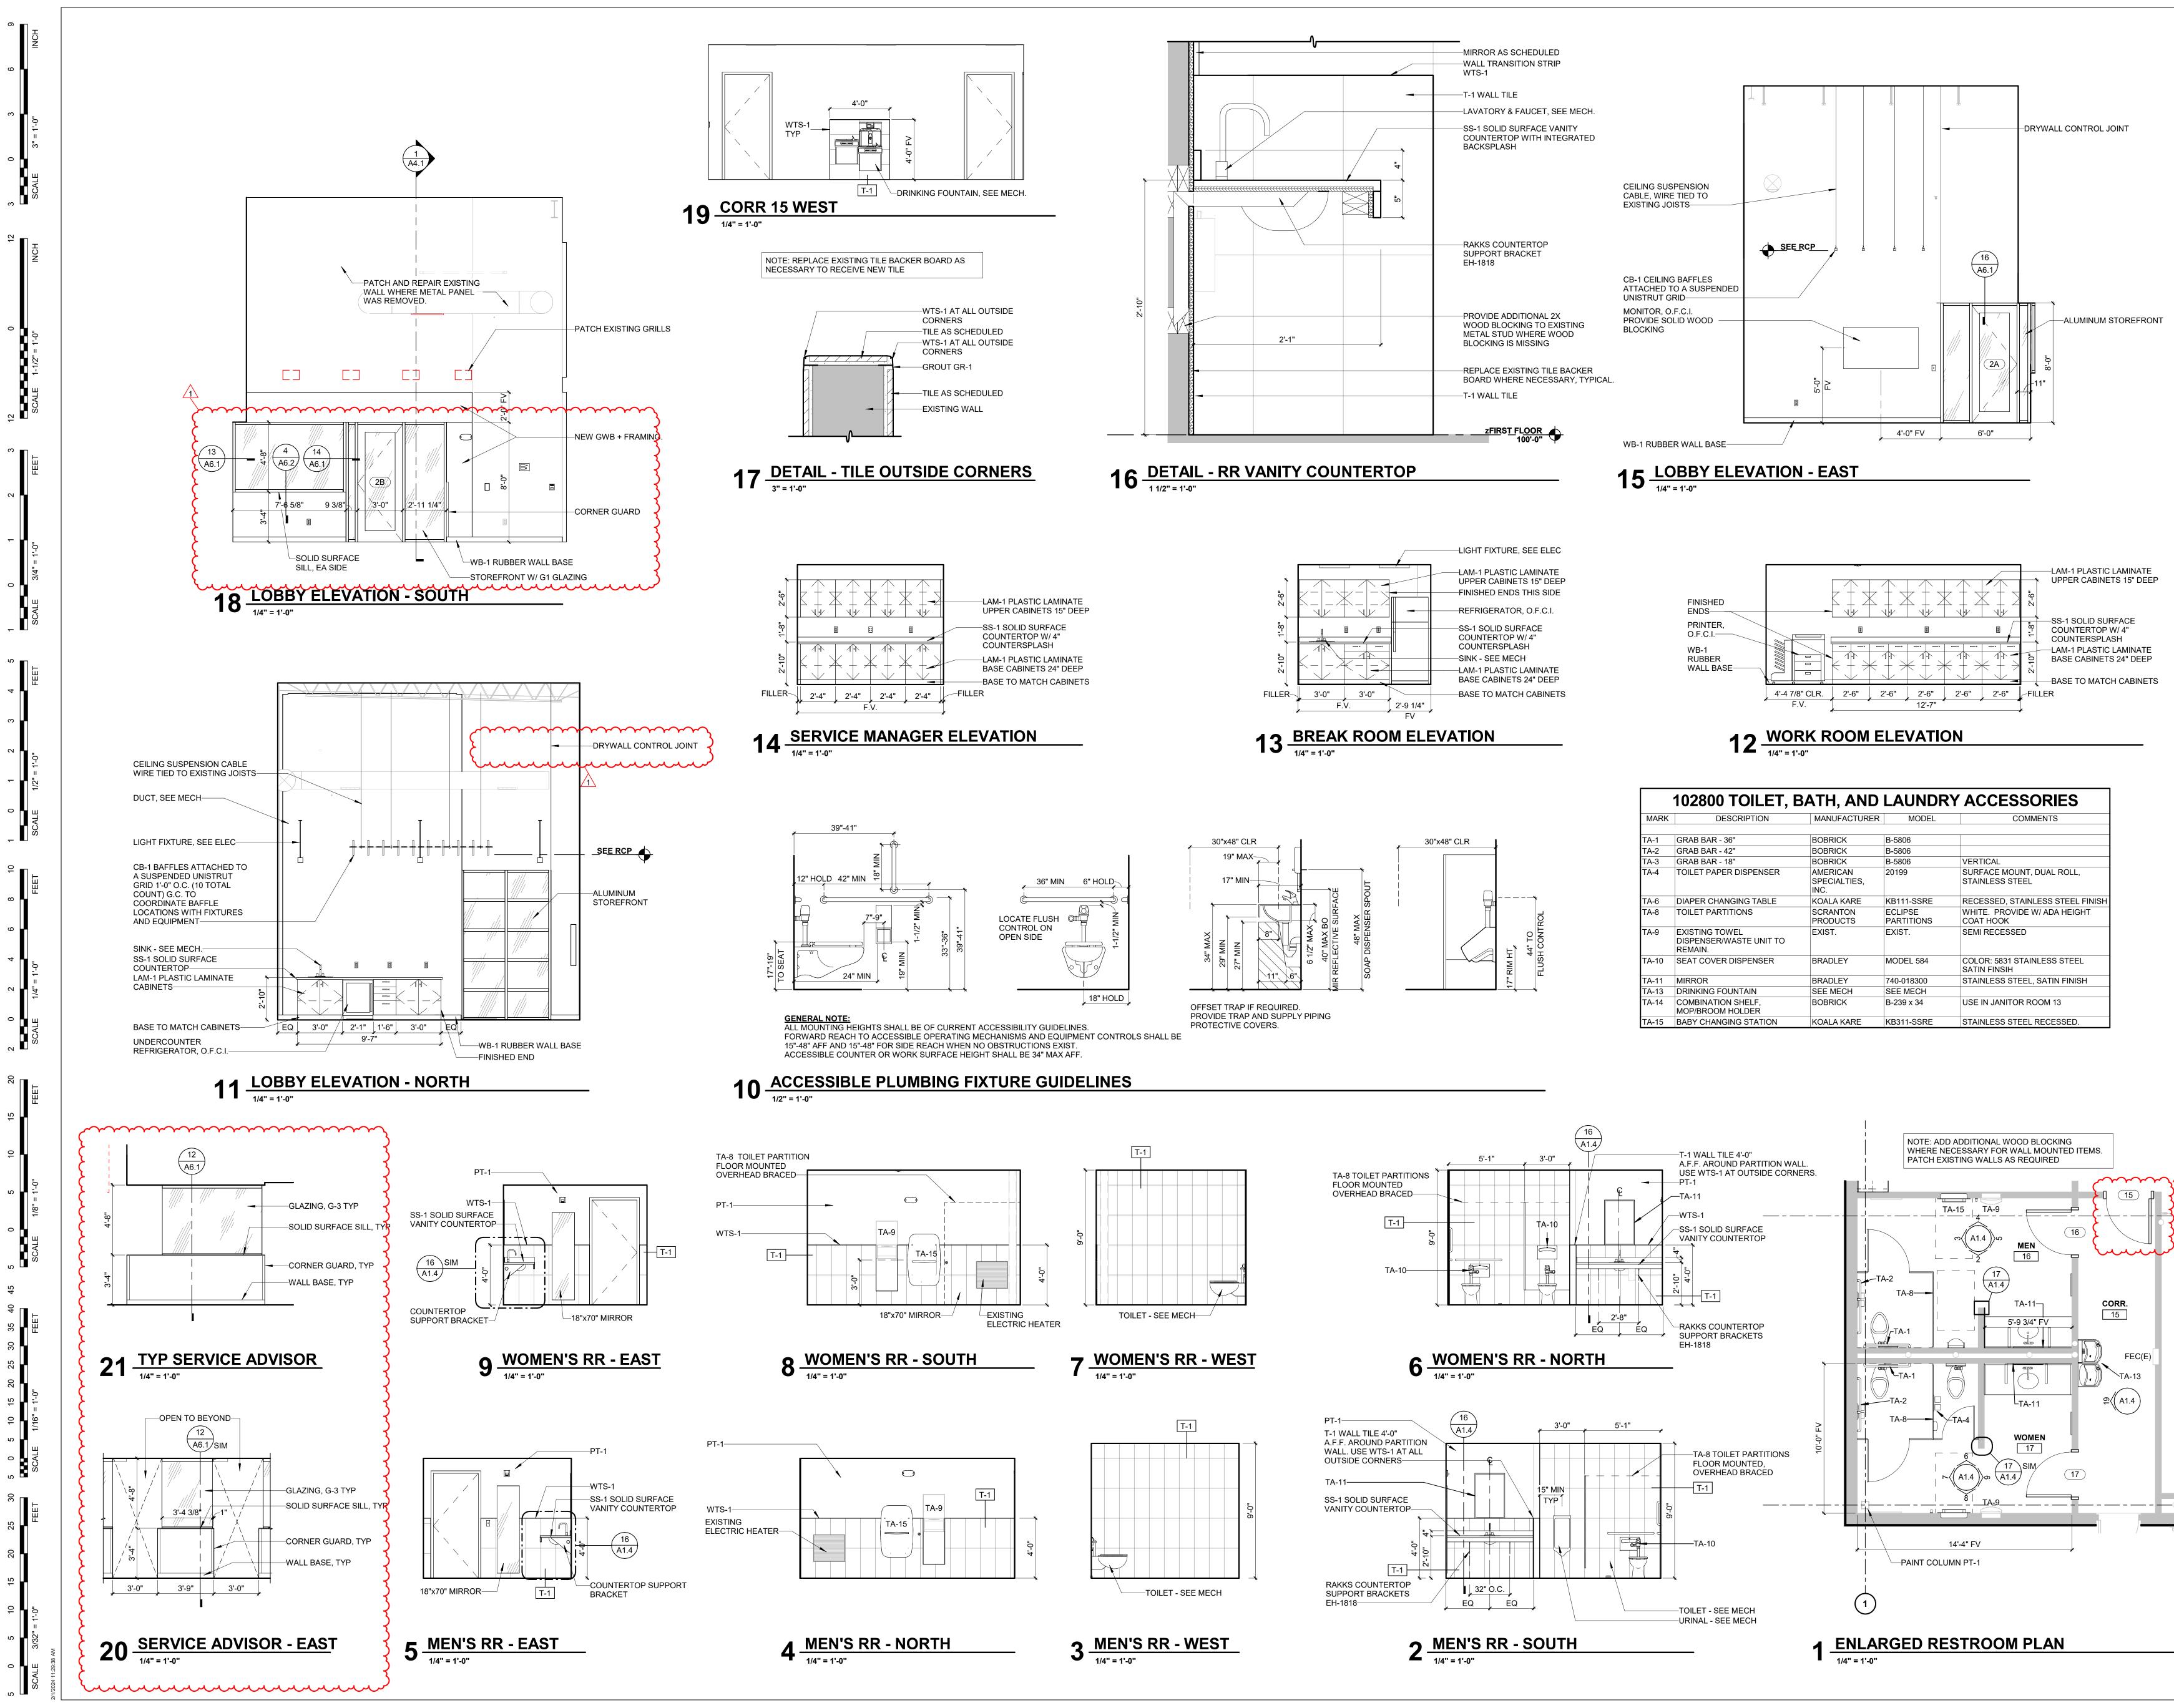

	102800 TOILET, E	BATH, AND	LAUNDRY	ACCESSORIES
MARK	DESCRIPTION	MANUFACTURER	MODEL	COMMENTS
TA-1	GRAB BAR - 36"	BOBRICK	B-5806	
TA-2	GRAB BAR - 42"	BOBRICK	B-5806	
TA-3	GRAB BAR - 18"	BOBRICK	B-5806	VERTICAL
TA-4	TOILET PAPER DISPENSER	AMERICAN SPECIALTIES, INC.	20199	SURFACE MOUNT, DUAL ROLL, STAINLESS STEEL
TA-6	DIAPER CHANGING TABLE	KOALA KARE	KB111-SSRE	RECESSED, STAINLESS STEEL FINISH
TA-8	TOILET PARTITIONS	SCRANTON PRODUCTS	ECLIPSE PARTITIONS	WHITE. PROVIDE W/ ADA HEIGHT COAT HOOK
TA-9	EXISTING TOWEL DISPENSER/WASTE UNIT TO REMAIN.	EXIST.	EXIST.	SEMI RECESSED
TA-10	SEAT COVER DISPENSER	BRADLEY	MODEL 584	COLOR: 5831 STAINLESS STEEL SATIN FINSIH
TA-11	MIRROR	BRADLEY	740-018300	STAINLESS STEEL, SATIN FINISH
TA-13	DRINKING FOUNTAIN	SEE MECH	SEE MECH	
TA-14	COMBINATION SHELF, MOP/BROOM HOLDER	BOBRICK	B-239 x 34	USE IN JANITOR ROOM 13
TA-15	BABY CHANGING STATION	KOALA KARE	KB311-SSRE	STAINLESS STEEL RECESSED.




CIVIL ENGINEER LAMP RYNEARSON 14710 W DODGE RD #100 OMAHA, NE 68154 V 402 496 2498 Ira-inc.com

STRUCTURAL ENGINEER LANGE STRUCTURAL GROUP 1919 S 40TH STREET, SUITE 302 LINCOLN NE 68506 V 402 421 9540 langestructuralgroup.com

MEP ENGINEER MORRISSEY ENGINEERING 4940 N 118TH ST OMAHA, NE 68164 V 402 491 4144 morrisseyengineering.com

REVISIONS SCHEDULE DATE DESCRIPTION MARK 1 02/01/2024 Addendum 1

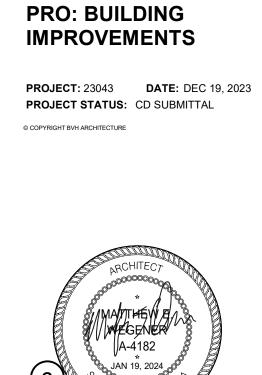

WOODHOUSE FORD






(2)

-(F)



6 9 INCH	
3 0 3 SCALE 3" = 1'-0"	
12 INCH	
12 0 SCALE 1-1/2" = 1-0"	
0 1 2 3 3/4" = 1'-0" FEET	
FEET SCALE	
8 10 1 0 1 2 FEET SCALE 1/2" = 1'-0"	
2 0 2 4 6	
5 0 5 10 15 20	
15 20 25 30 35 40 45	
20 25 30 5 0 5 10	AREA B AREA C
5 0 5 10 15 2 SCALE 3/32" = 1'-0"	2 <u>RCP - AREA B</u> 1/8" = 1'-0"

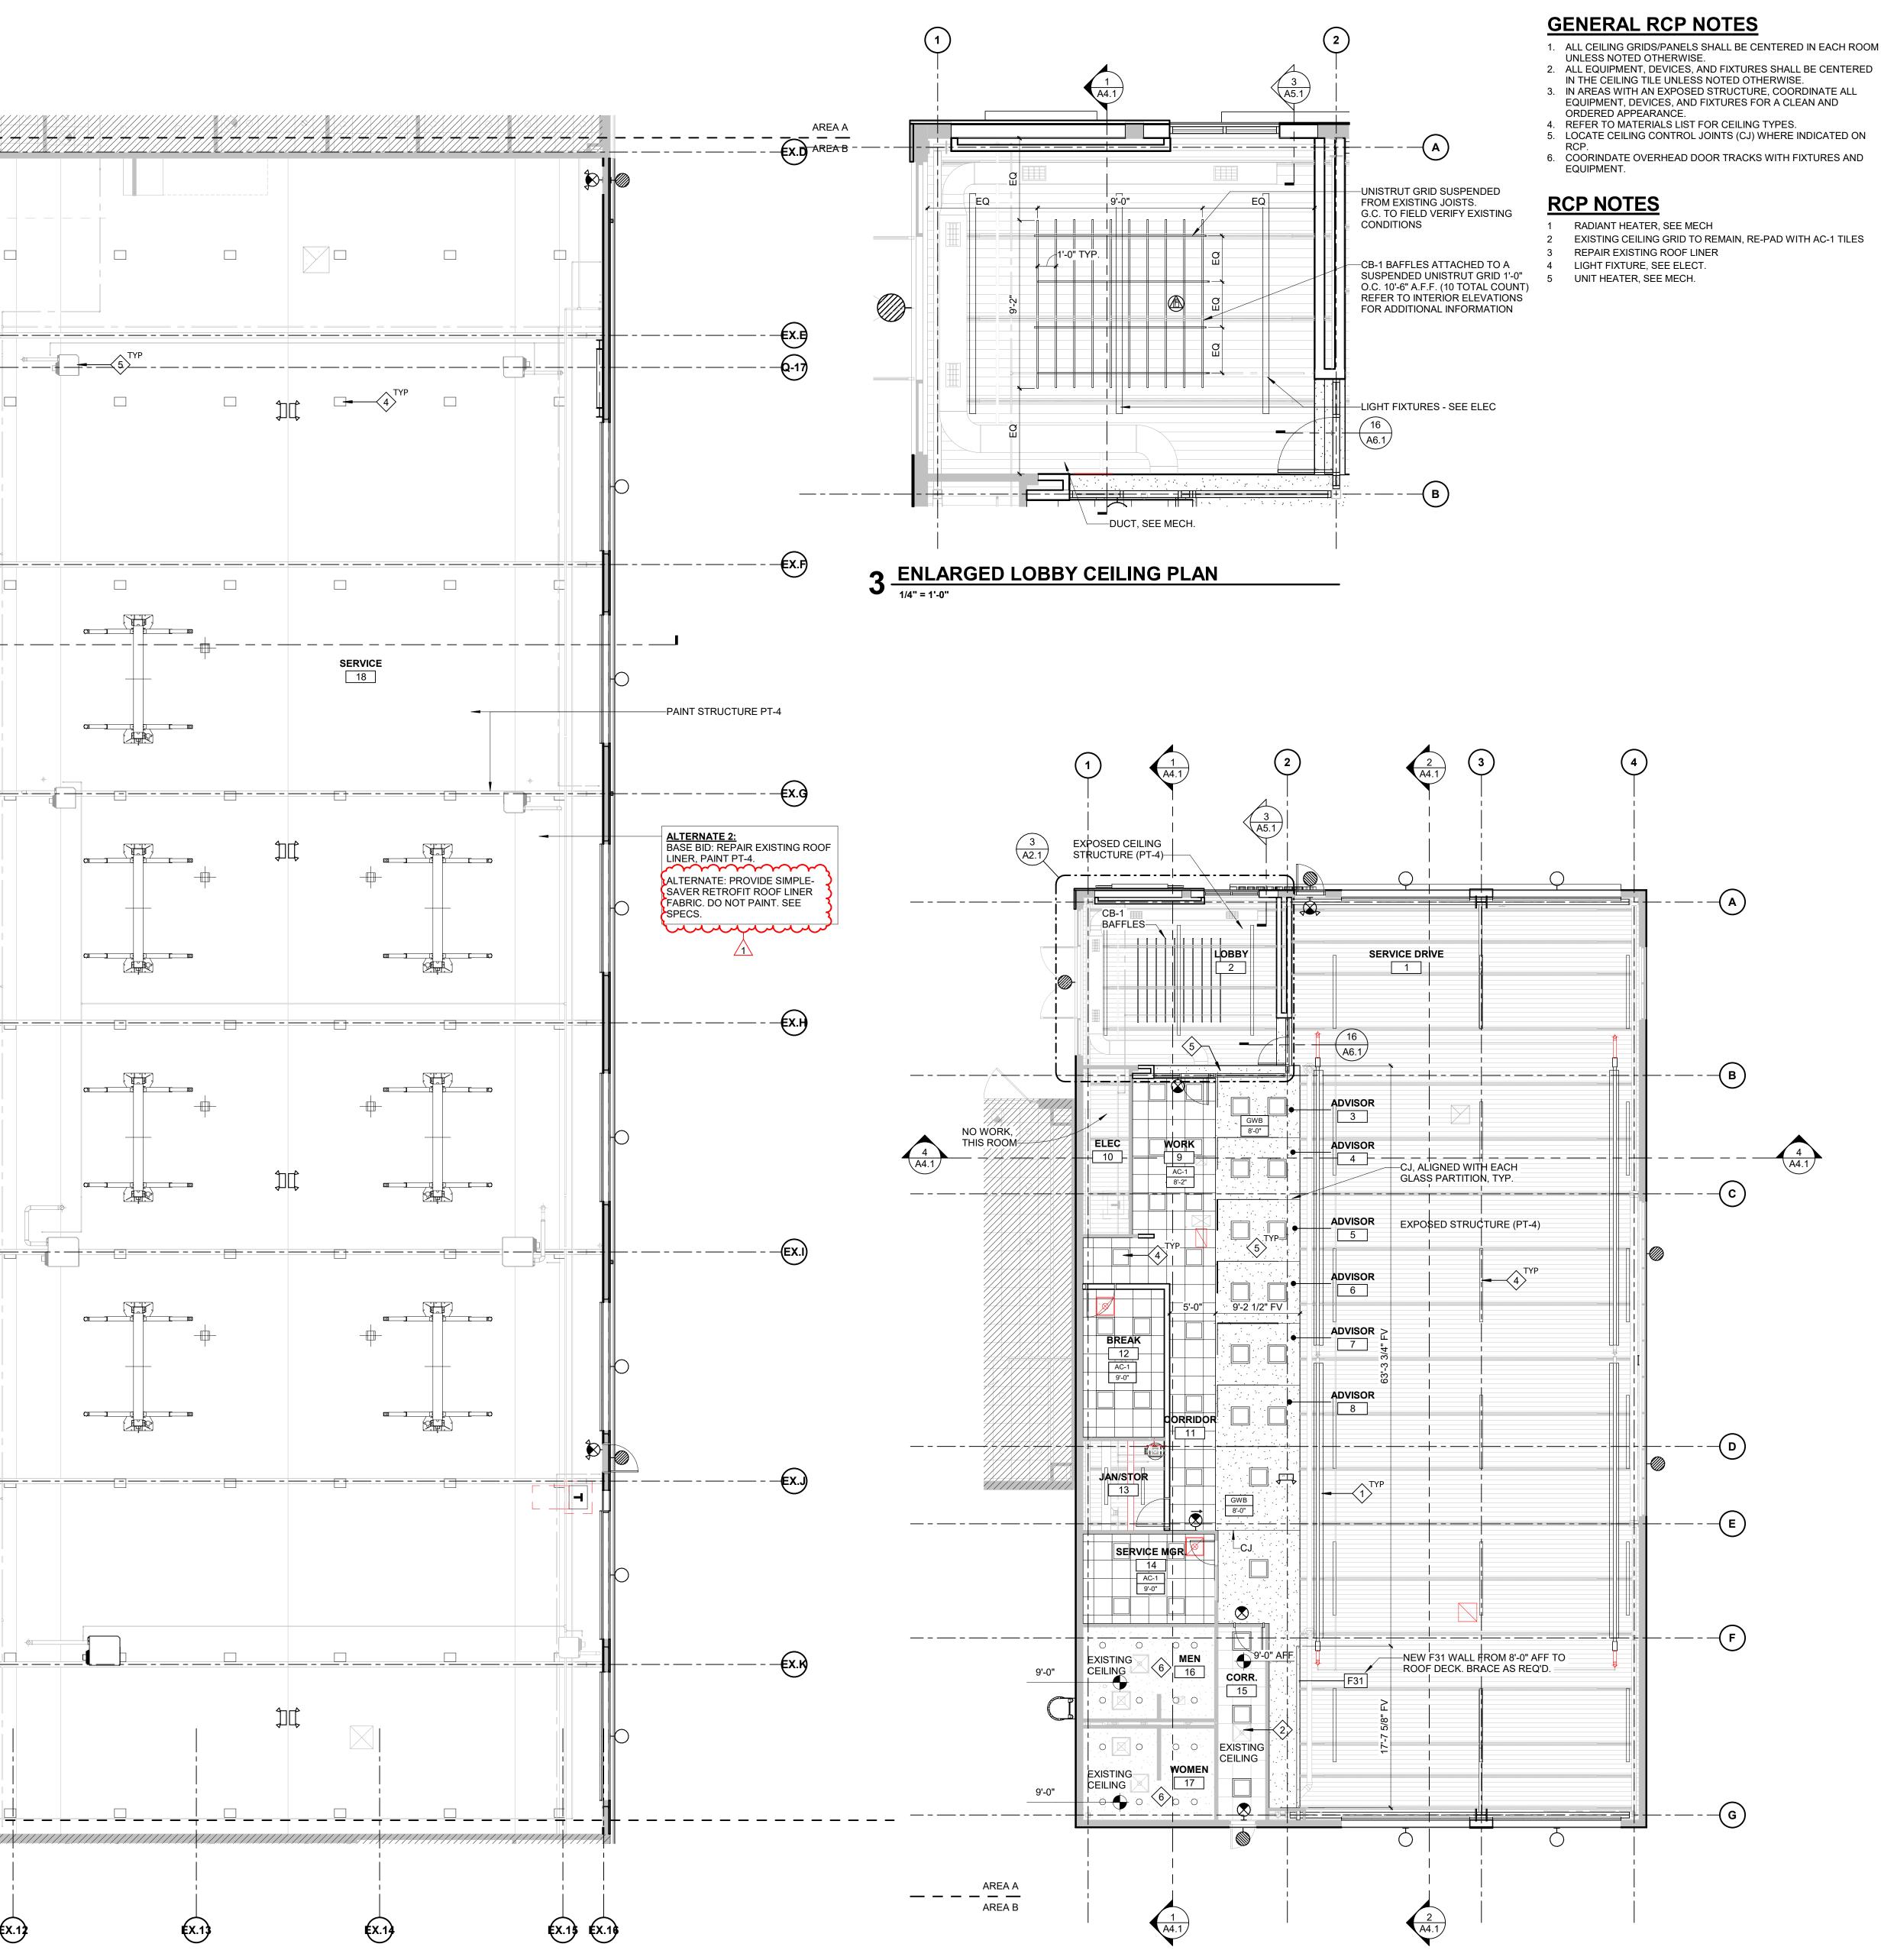



GENERAL RCP NOTES


- 2. ALL EQUIPMENT, DEVICES, AND FIXTURES SHALL BE CENTERED
- IN THE CEILING TILE UNLESS NOTED OTHERWISE. 3. IN AREAS WITH AN EXPOSED STRUCTURE, COORDINATE ALL EQUIPMENT, DEVICES, AND FIXTURES FOR A CLEAN AND
- 4. REFER TO MATERIALS LIST FOR CEILING TYPES.
- 5. LOCATE CEILING CONTROL JOINTS (CJ) WHERE INDICATED ON

- EXISTING CEILING GRID TO REMAIN, RE-PAD WITH AC-1 TILES

1 <u>RCP - AREA A</u> 1/8" = 1'-0"

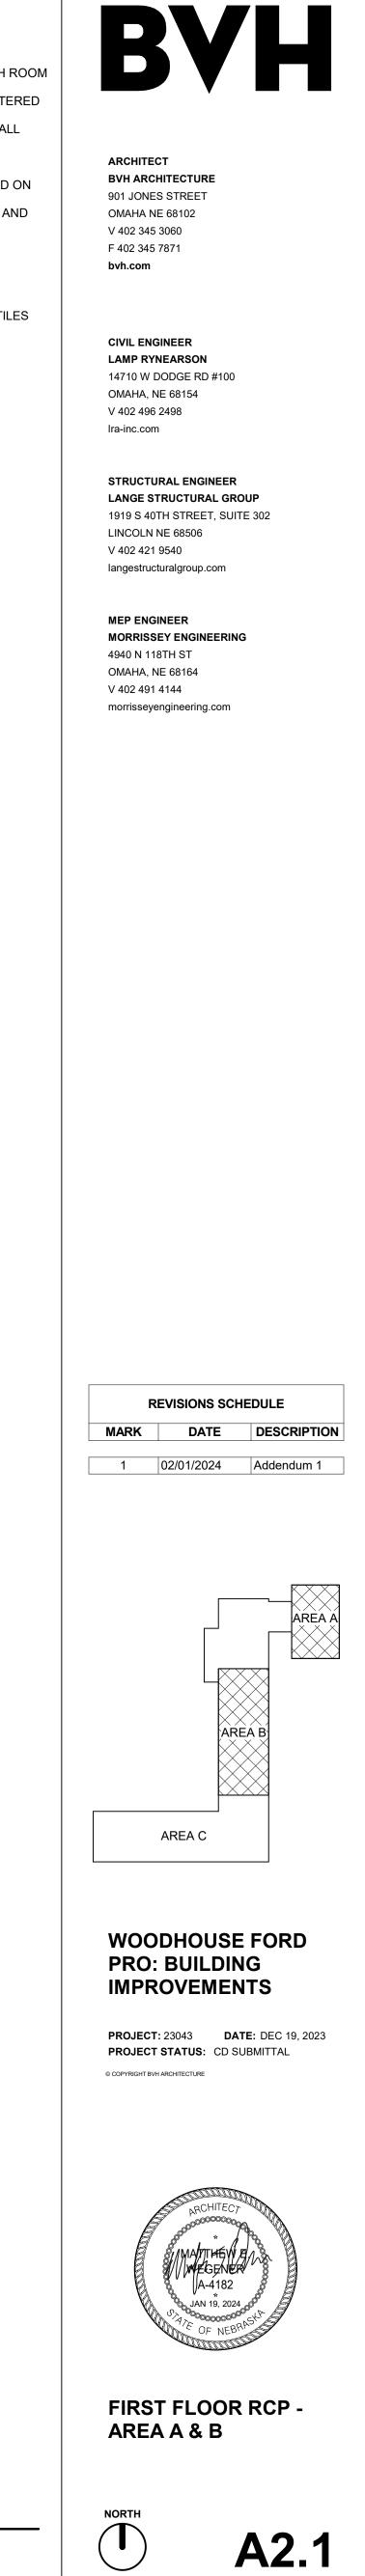

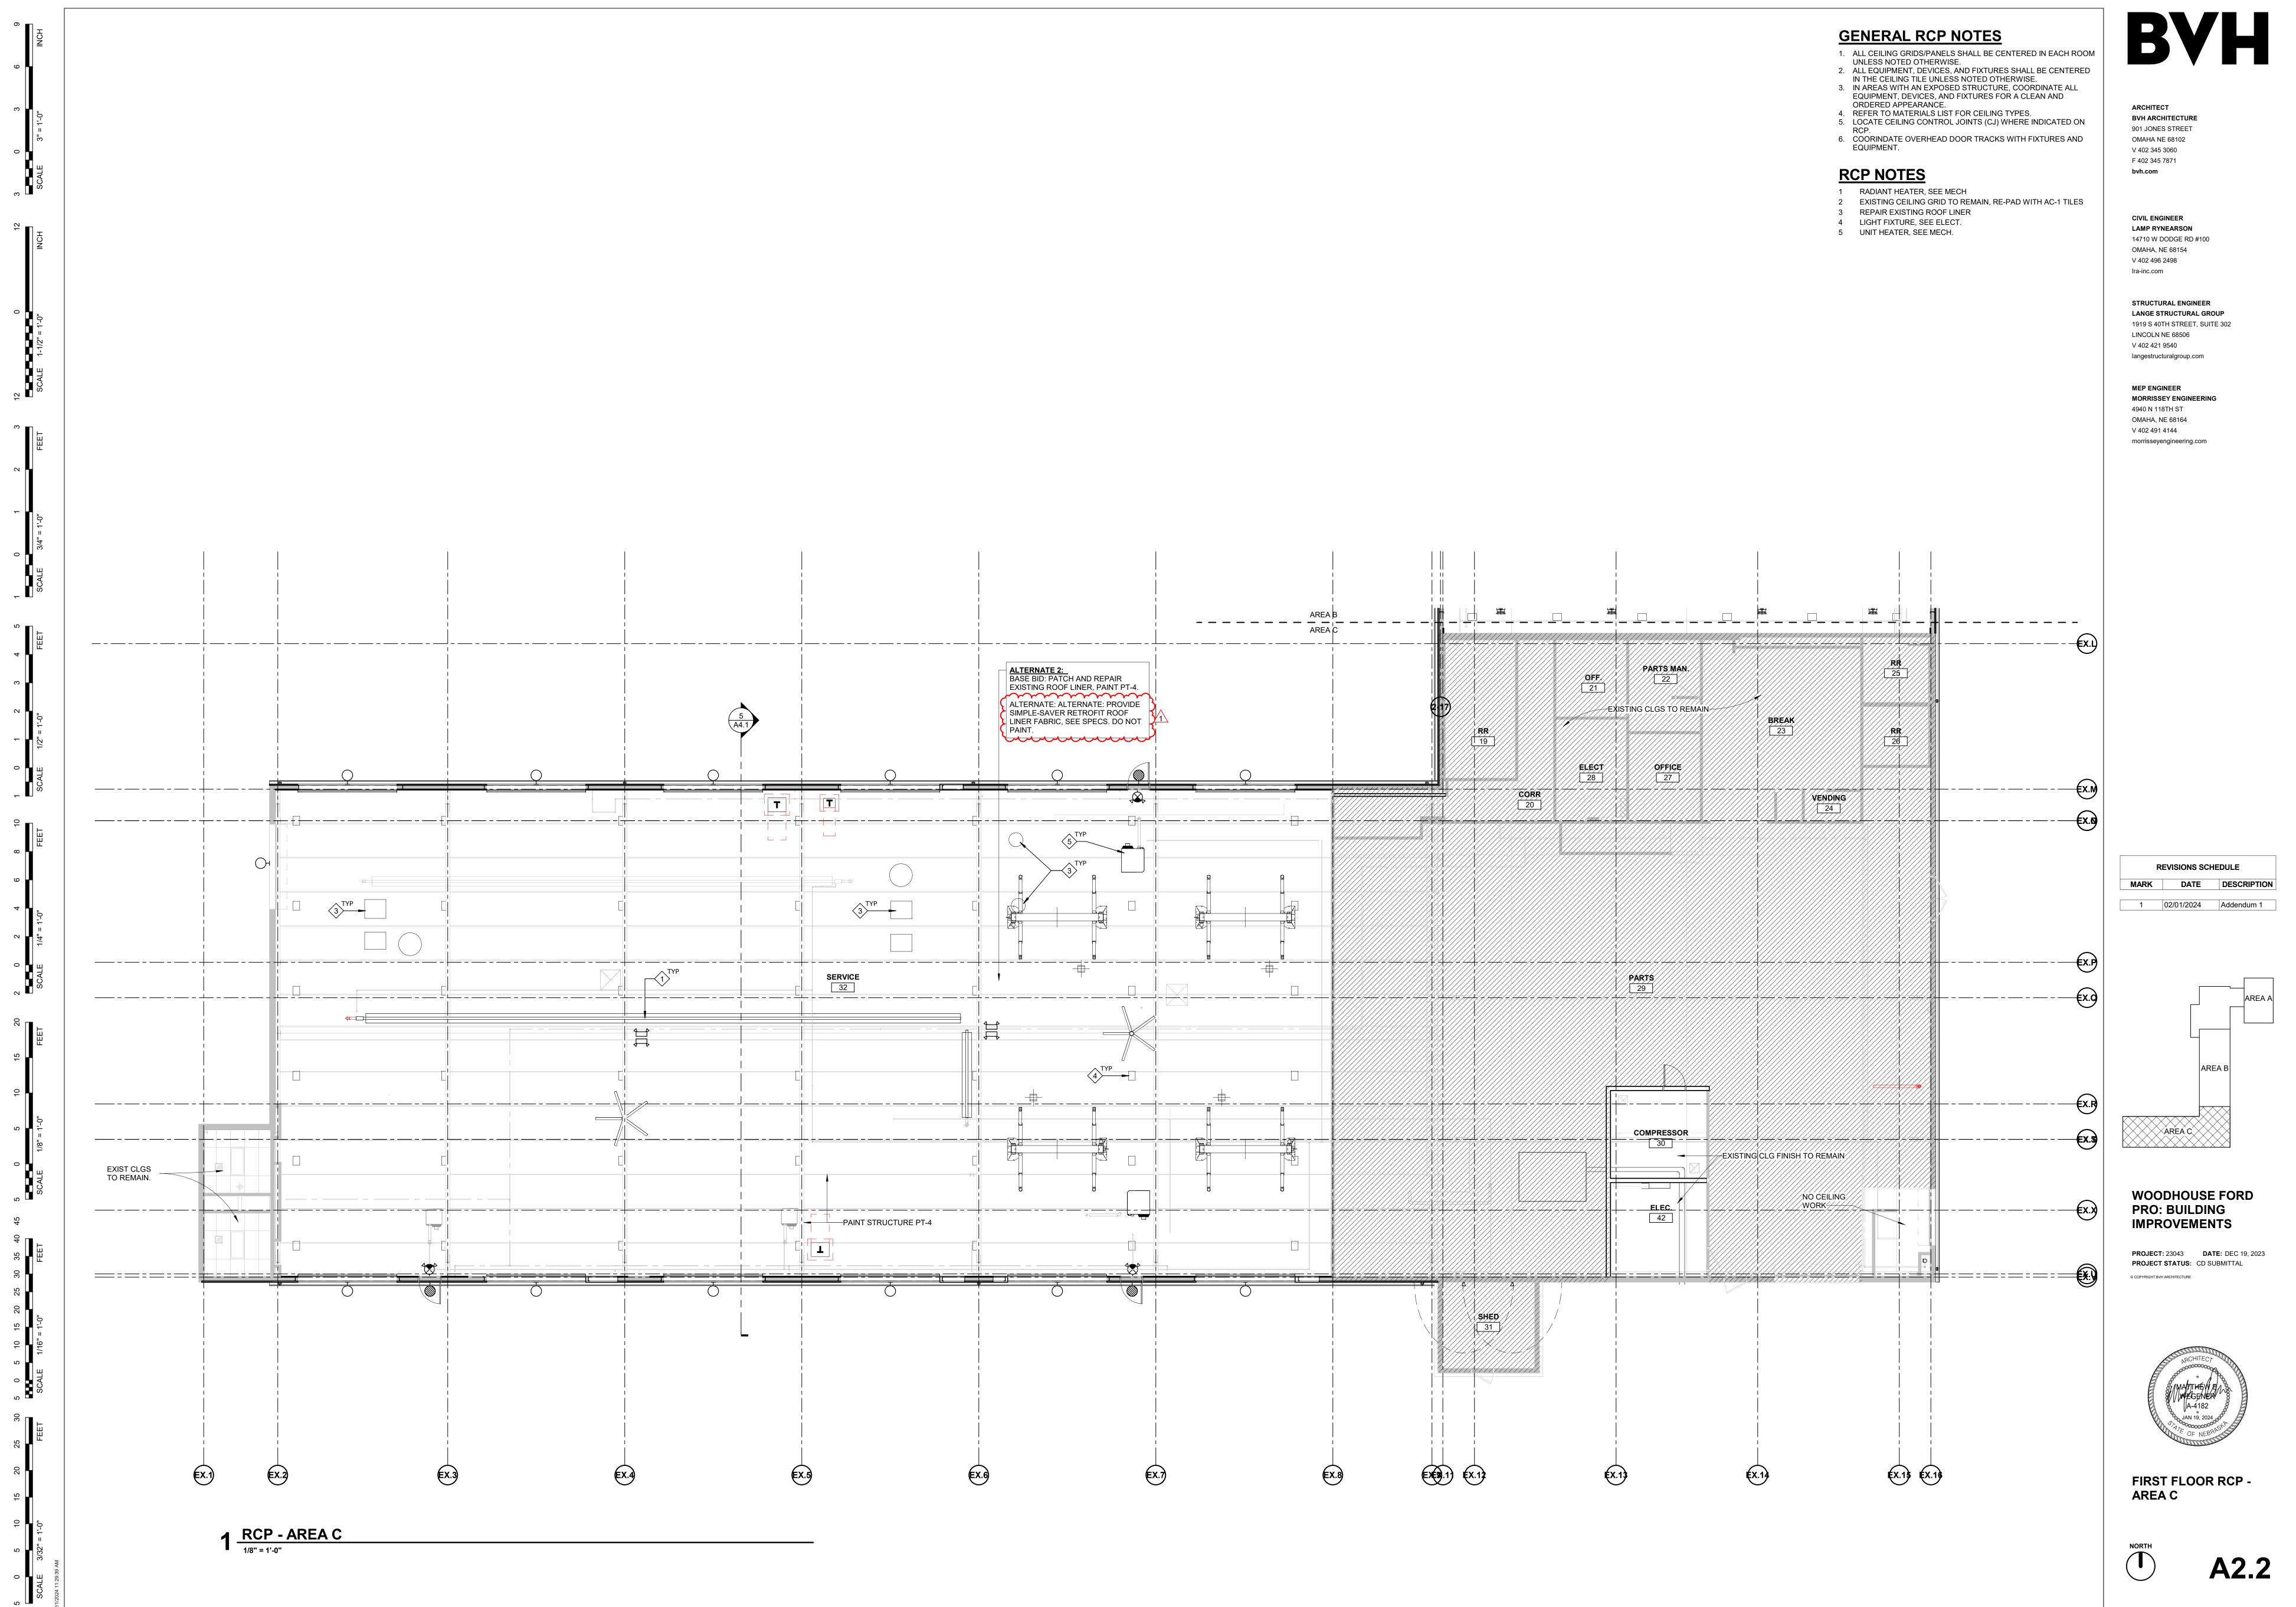

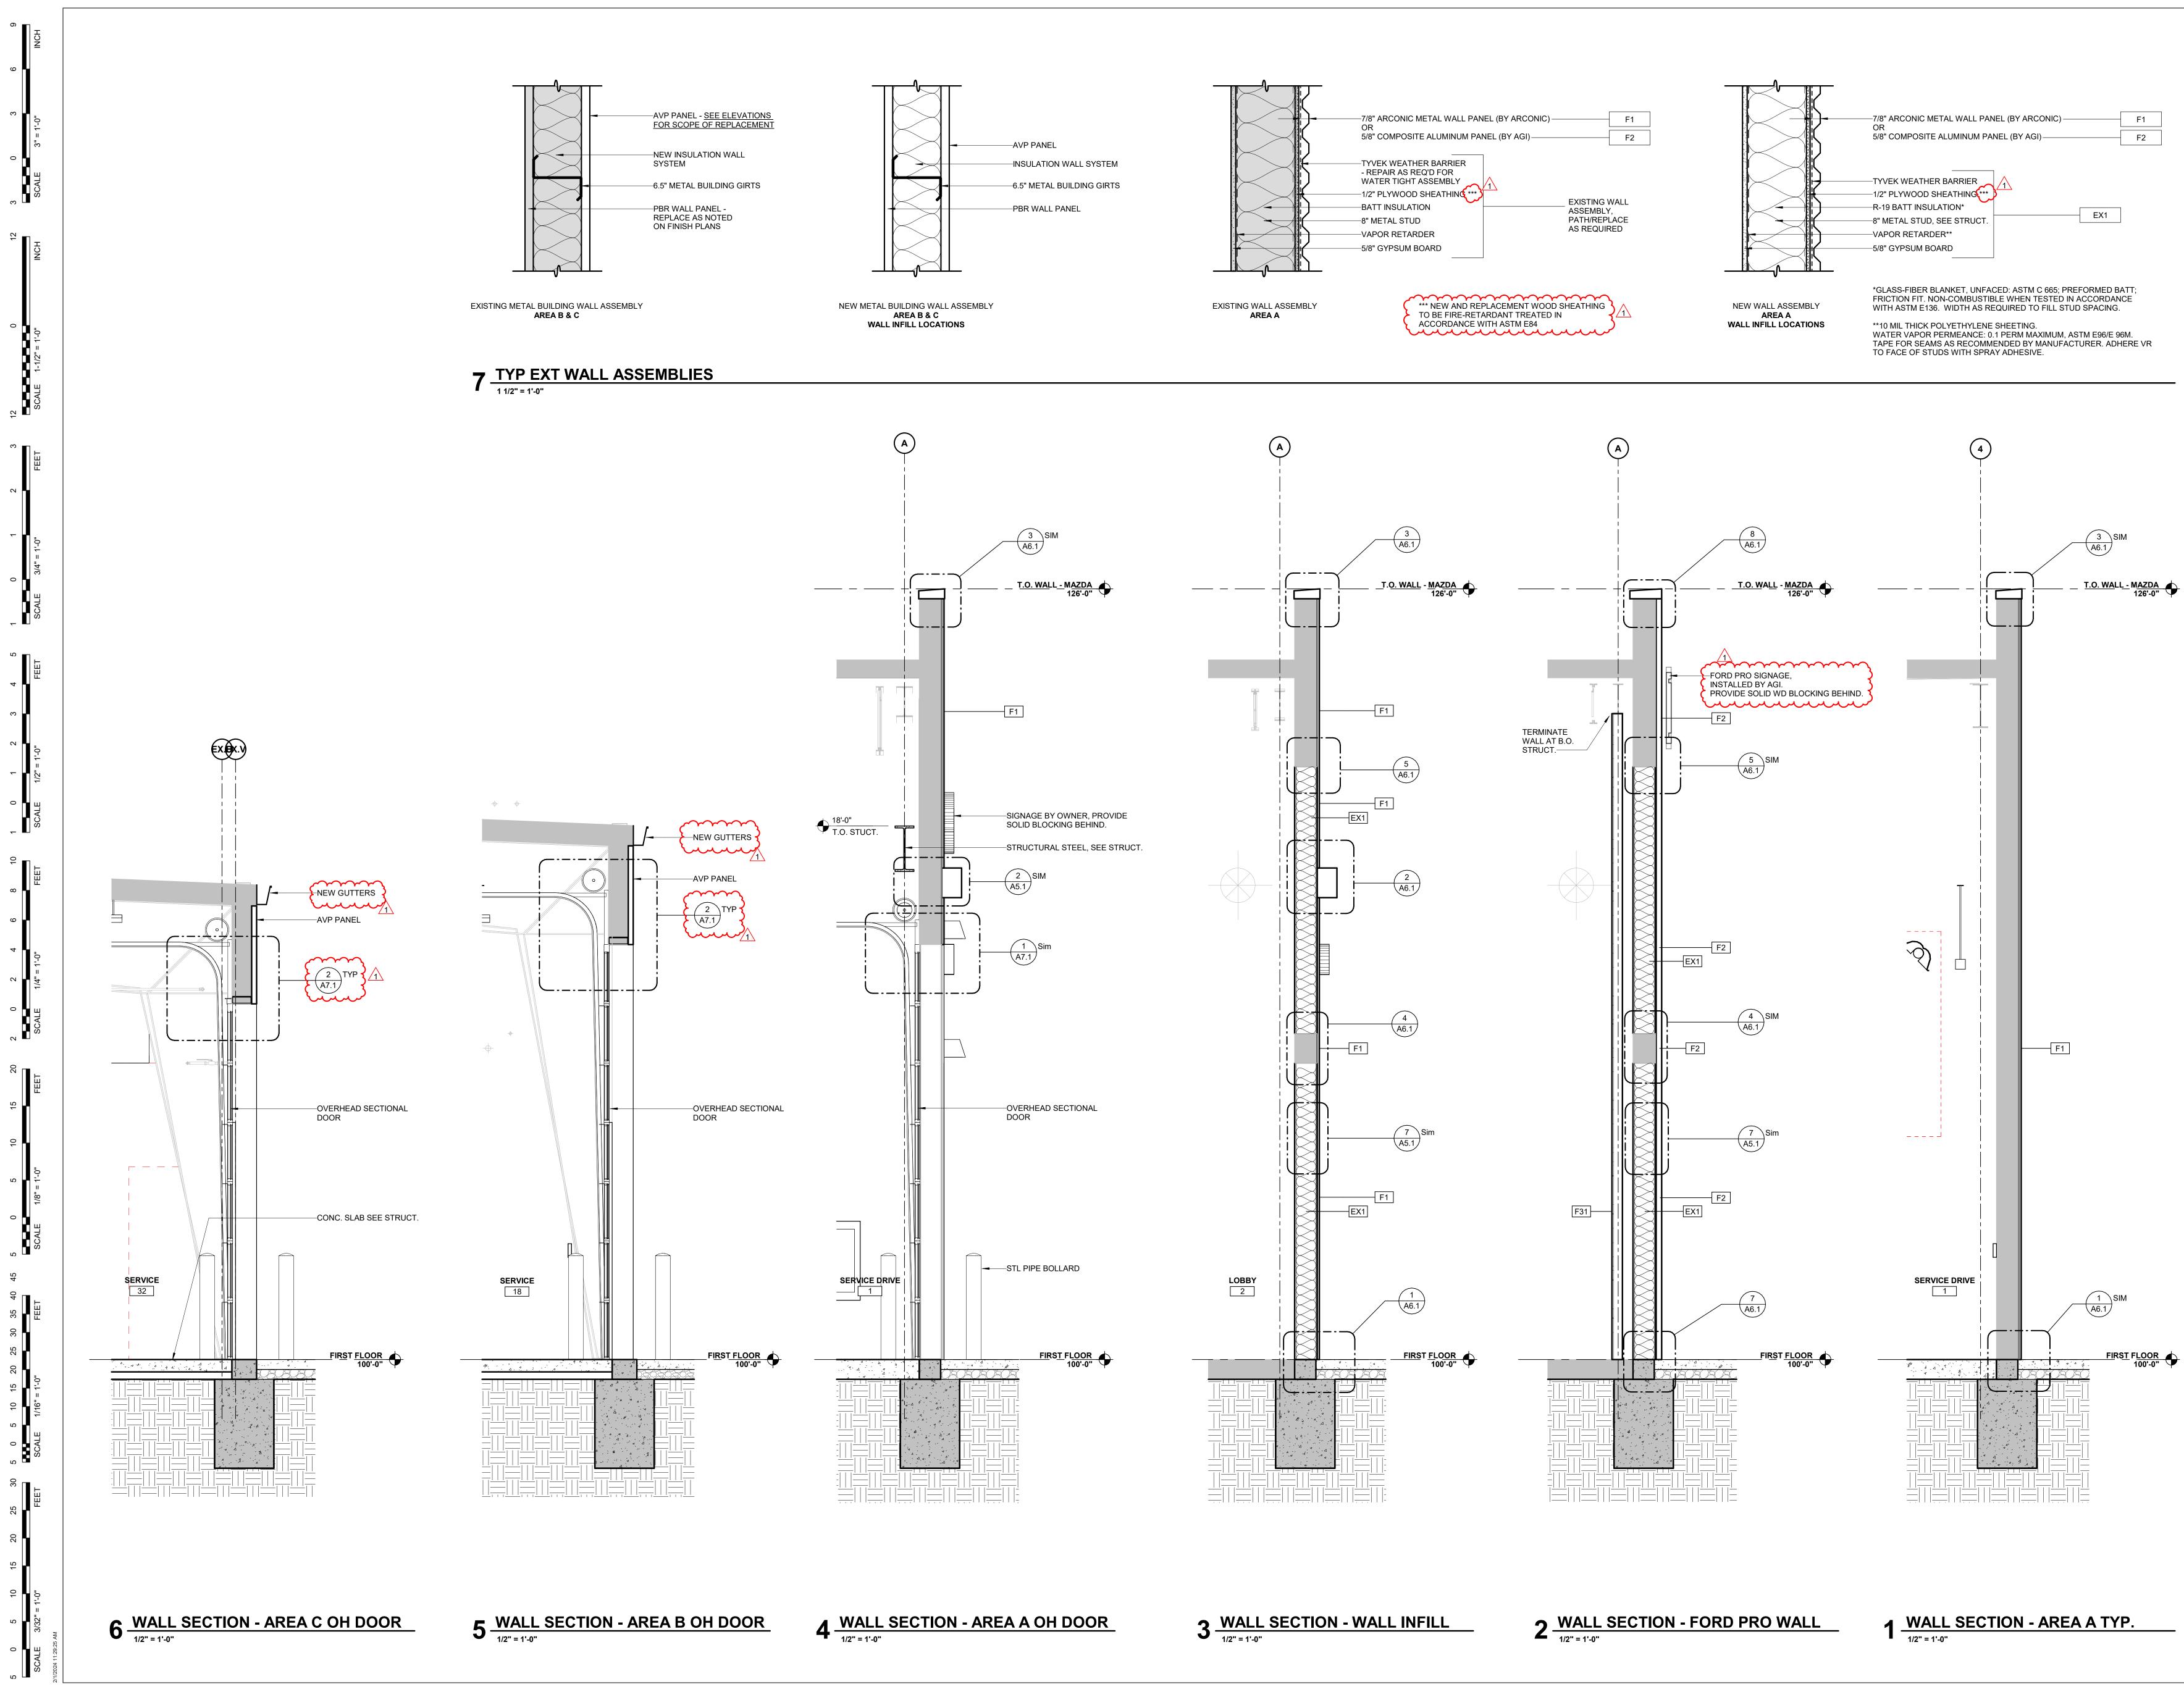




CIVIL ENGINEER LAMP RYNEARSON 14710 W DODGE RD #100 OMAHA, NE 68154 V 402 496 2498 Ira-inc.com

STRUCTURAL ENGINEER LANGE STRUCTURAL GROUP 1919 S 40TH STREET, SUITE 302 LINCOLN NE 68506 V 402 421 9540 langestructuralgroup.com

MEP ENGINEER MORRISSEY ENGINEERING 4940 N 118TH ST OMAHA, NE 68164 V 402 491 4144 morrisseyengineering.com

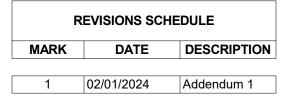




PROJECT: 23043 **DATE:** DEC 19, 2023 PROJECT STATUS: CD SUBMITTAL © COPYRIGHT BVH ARCHITECTURE





WALL SECTIONS




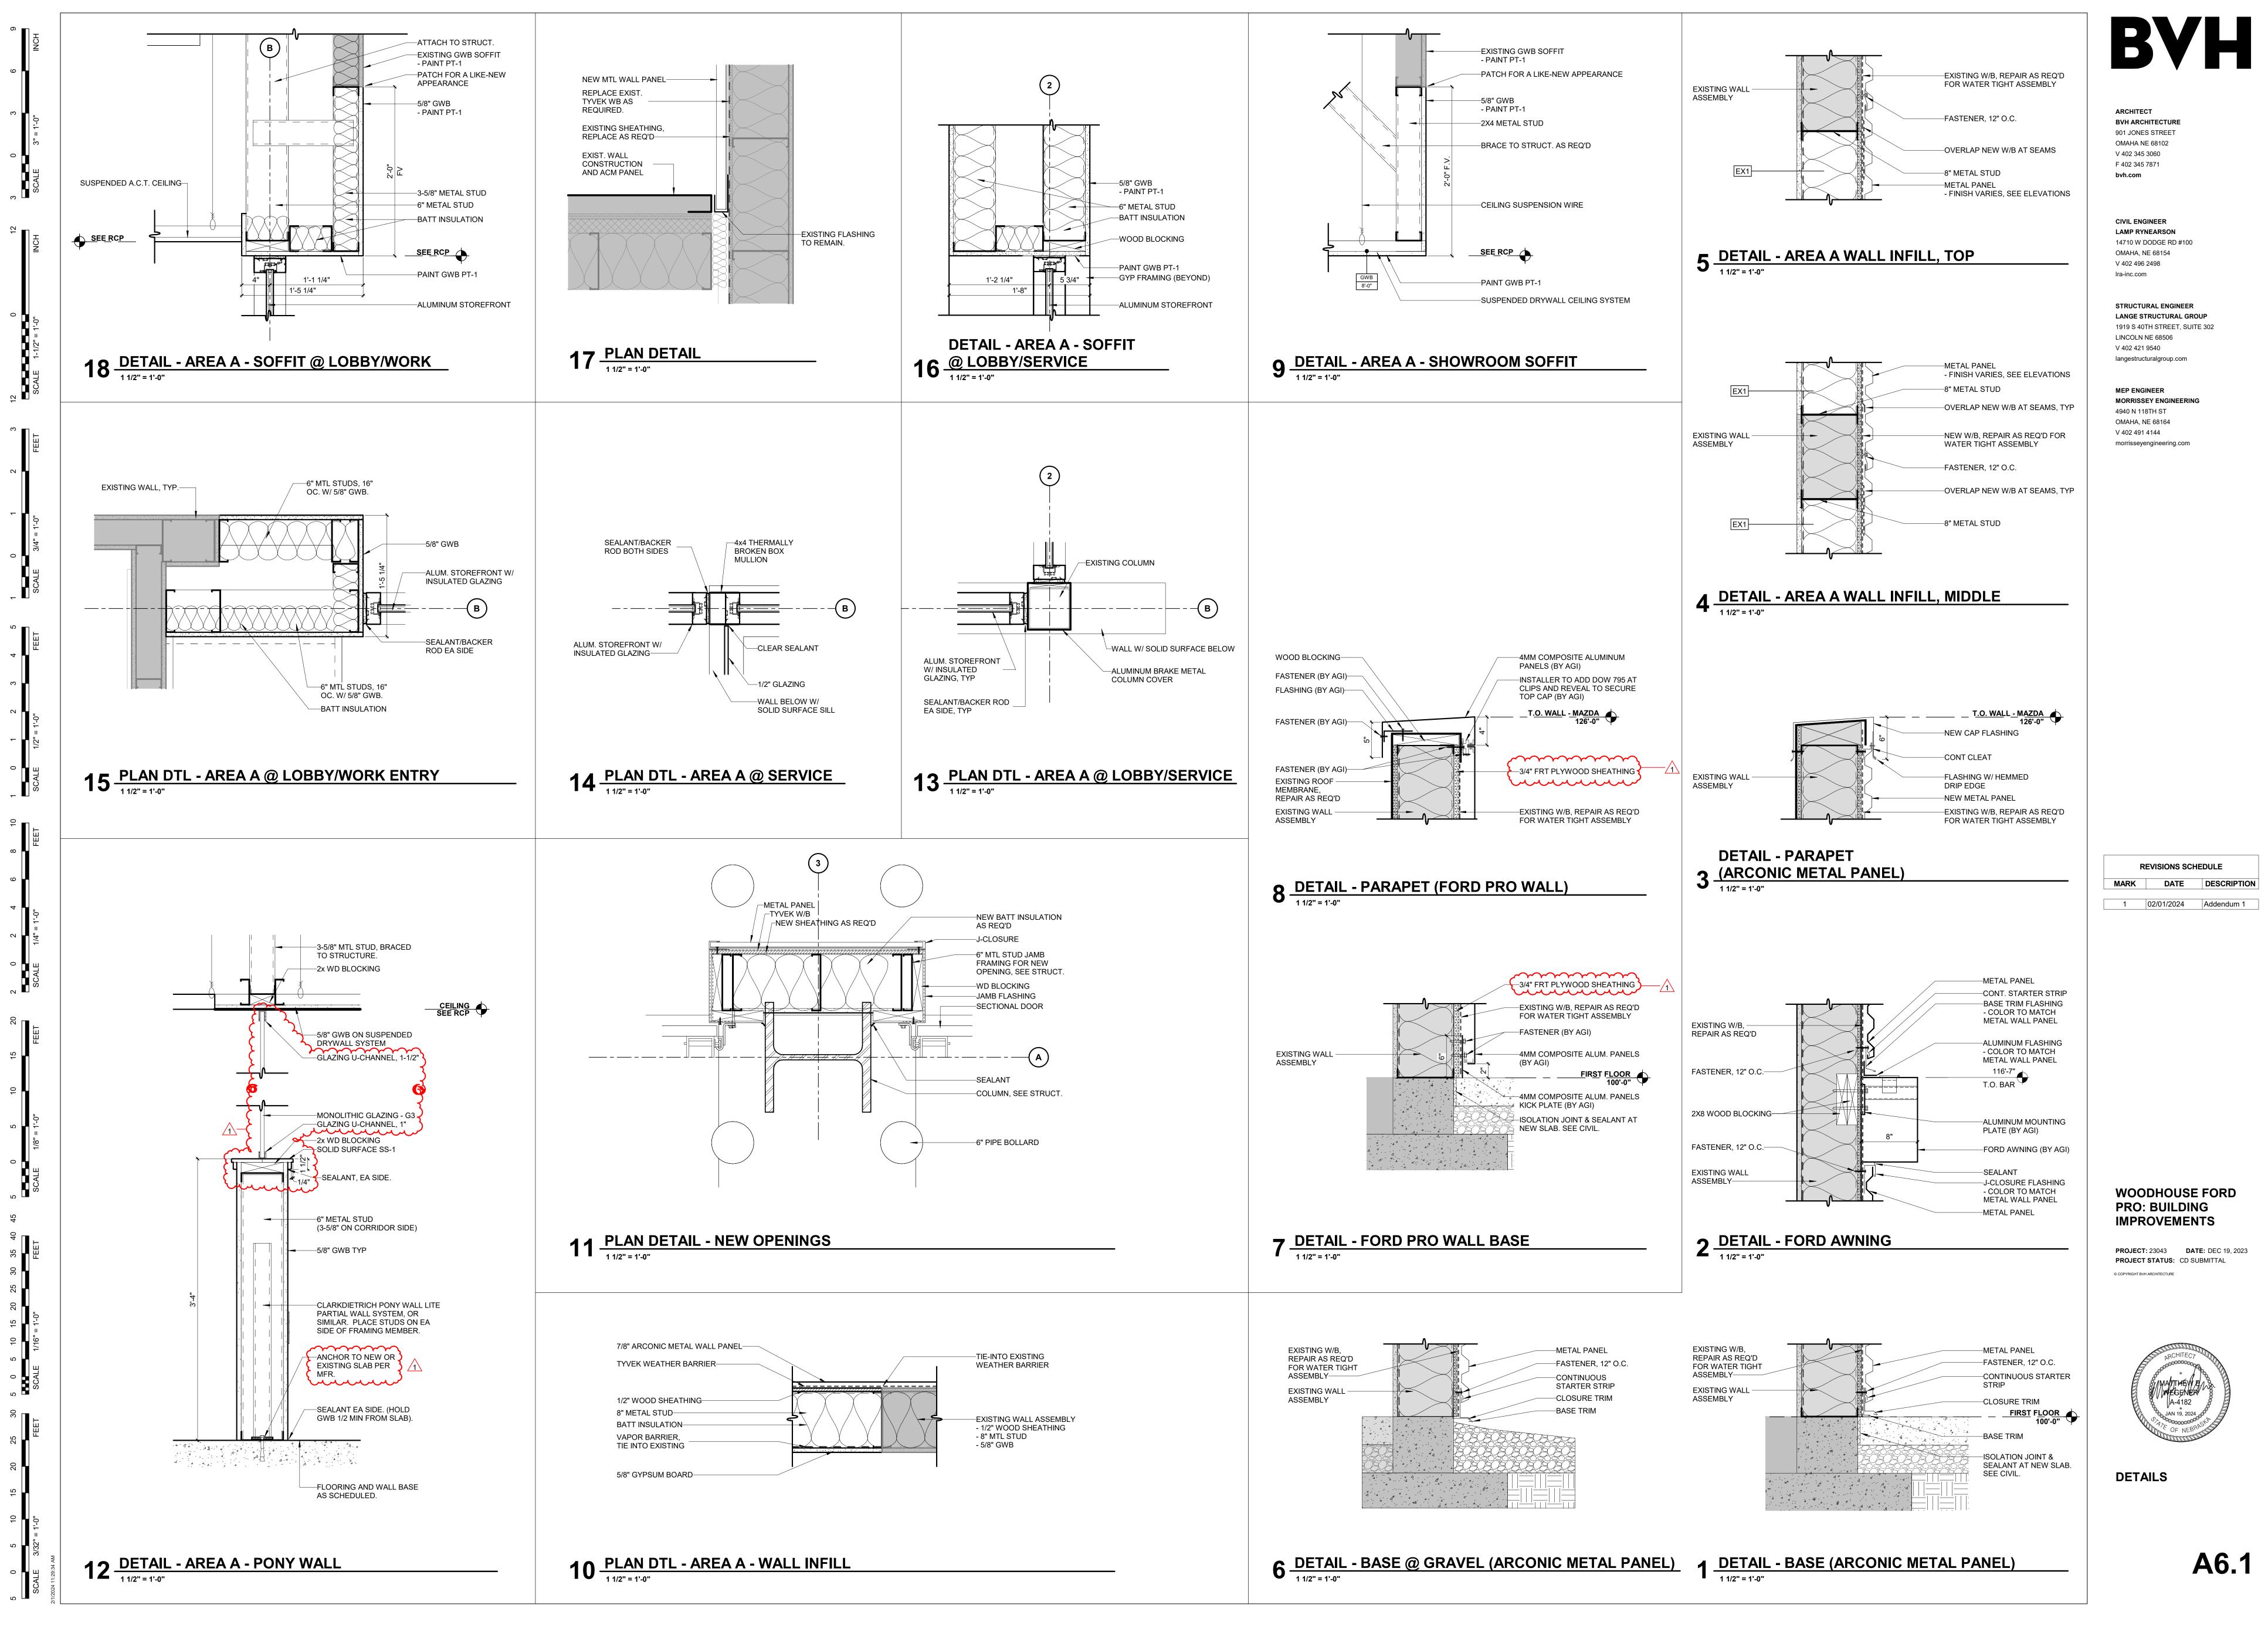

6 INCH				
ω				
) 3 3" = 1'-0"				
3 0 SCALE				
12 INCH				
0 1/2" = 1'-0"				
12 SCALE 1-1/2				
S EET				
~				
1 3/4" = 1'-0"				
SCALE				
ж 4				
1 2 1/2" = 1'-0"				
SCALE				
10 FEET				
20 20				
2 4 1/4" = 1'-0"				
2 0 SCALE				
20 FEET				
10 15				
5 1/8" = 1'-0"				
5 0 SCALE	E			
35 40 45		5/8" COMPOSITE ALUMINUM PANEL (BY AGI)—		
25 30		TYVEK WEATHER BARRIER 3/4" FIRE TREATED PLYWOOD SHEATHING		
10 15 20 1/16" = 1'-0"				8 1/2"
5 0 5 SCALE		EXISTING WALL ASSEMBLY FASTENER (BY AGI)		
25 30 FEET		SEALANT AND BACKER ROD		
15 20		ALUMINUM FLASHING - COLOR TO MATCH STOREFRONT EXISTING ALUMINUM STOREFRONT	V	
5 10 3/32" = 1'-0"			SIDE CORNER (FORD P	RO WALL)
5 0 SCALE 3/	۲ کر ا	1 1/2" = 1'-0"	······	······

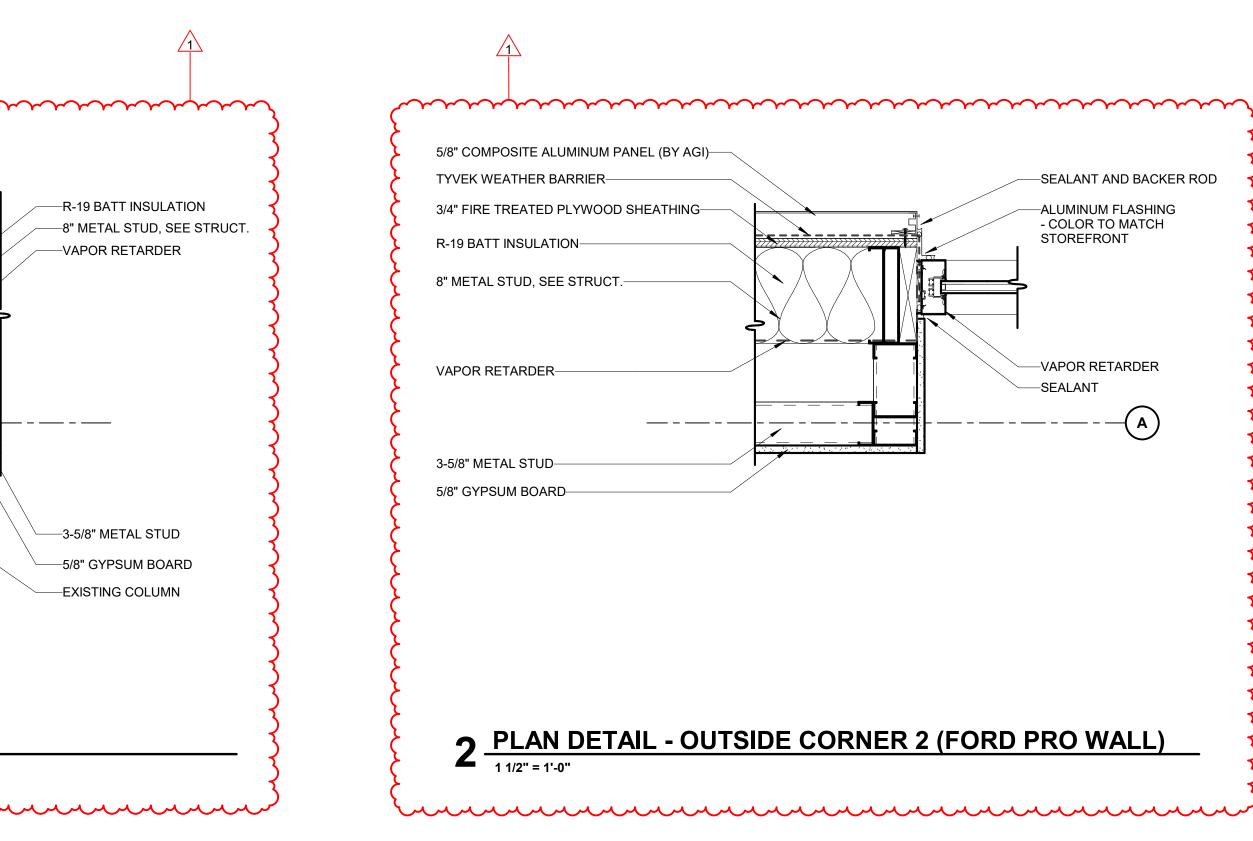

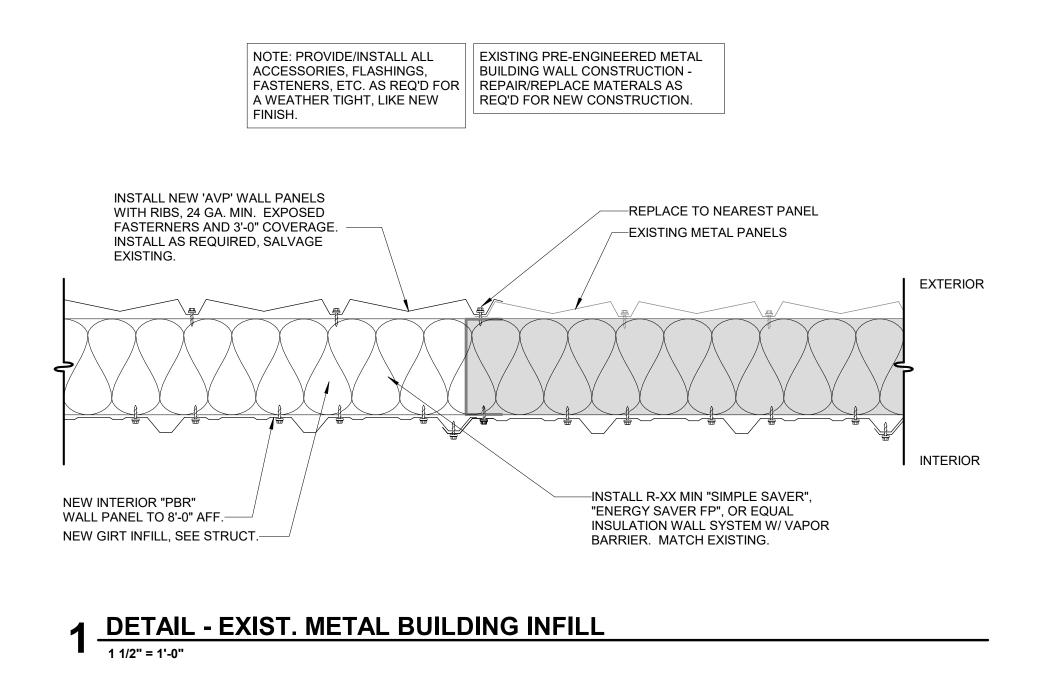

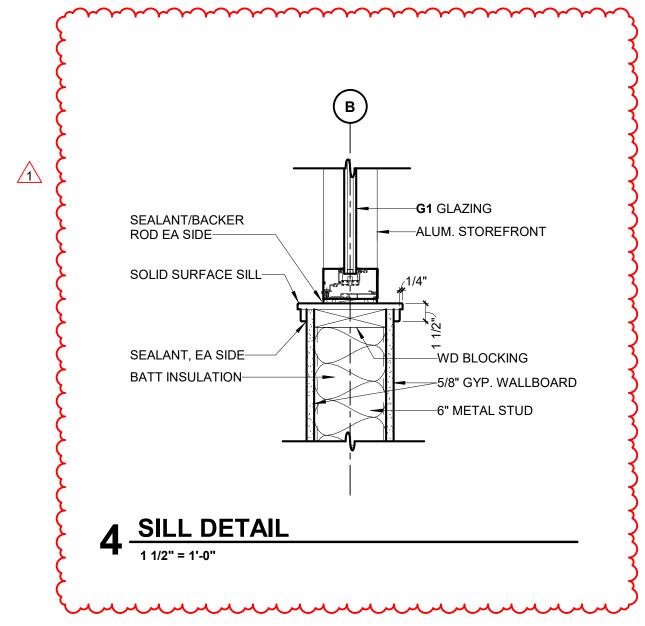




CIVIL ENGINEER LAMP RYNEARSON 14710 W DODGE RD #100 OMAHA, NE 68154 V 402 496 2498 Ira-inc.com

STRUCTURAL ENGINEER LANGE STRUCTURAL GROUP 1919 S 40TH STREET, SUITE 302 LINCOLN NE 68506 V 402 421 9540 langestructuralgroup.com

MEP ENGINEER MORRISSEY ENGINEERING 4940 N 118TH ST OMAHA, NE 68164 V 402 491 4144 morrisseyengineering.com

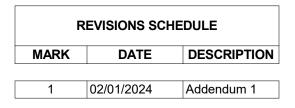




PROJECT: 23043 **DATE:** DEC 19, 2023 PROJECT STATUS: CD SUBMITTAL © COPYRIGHT BVH ARCHITECTURE



DETAILS



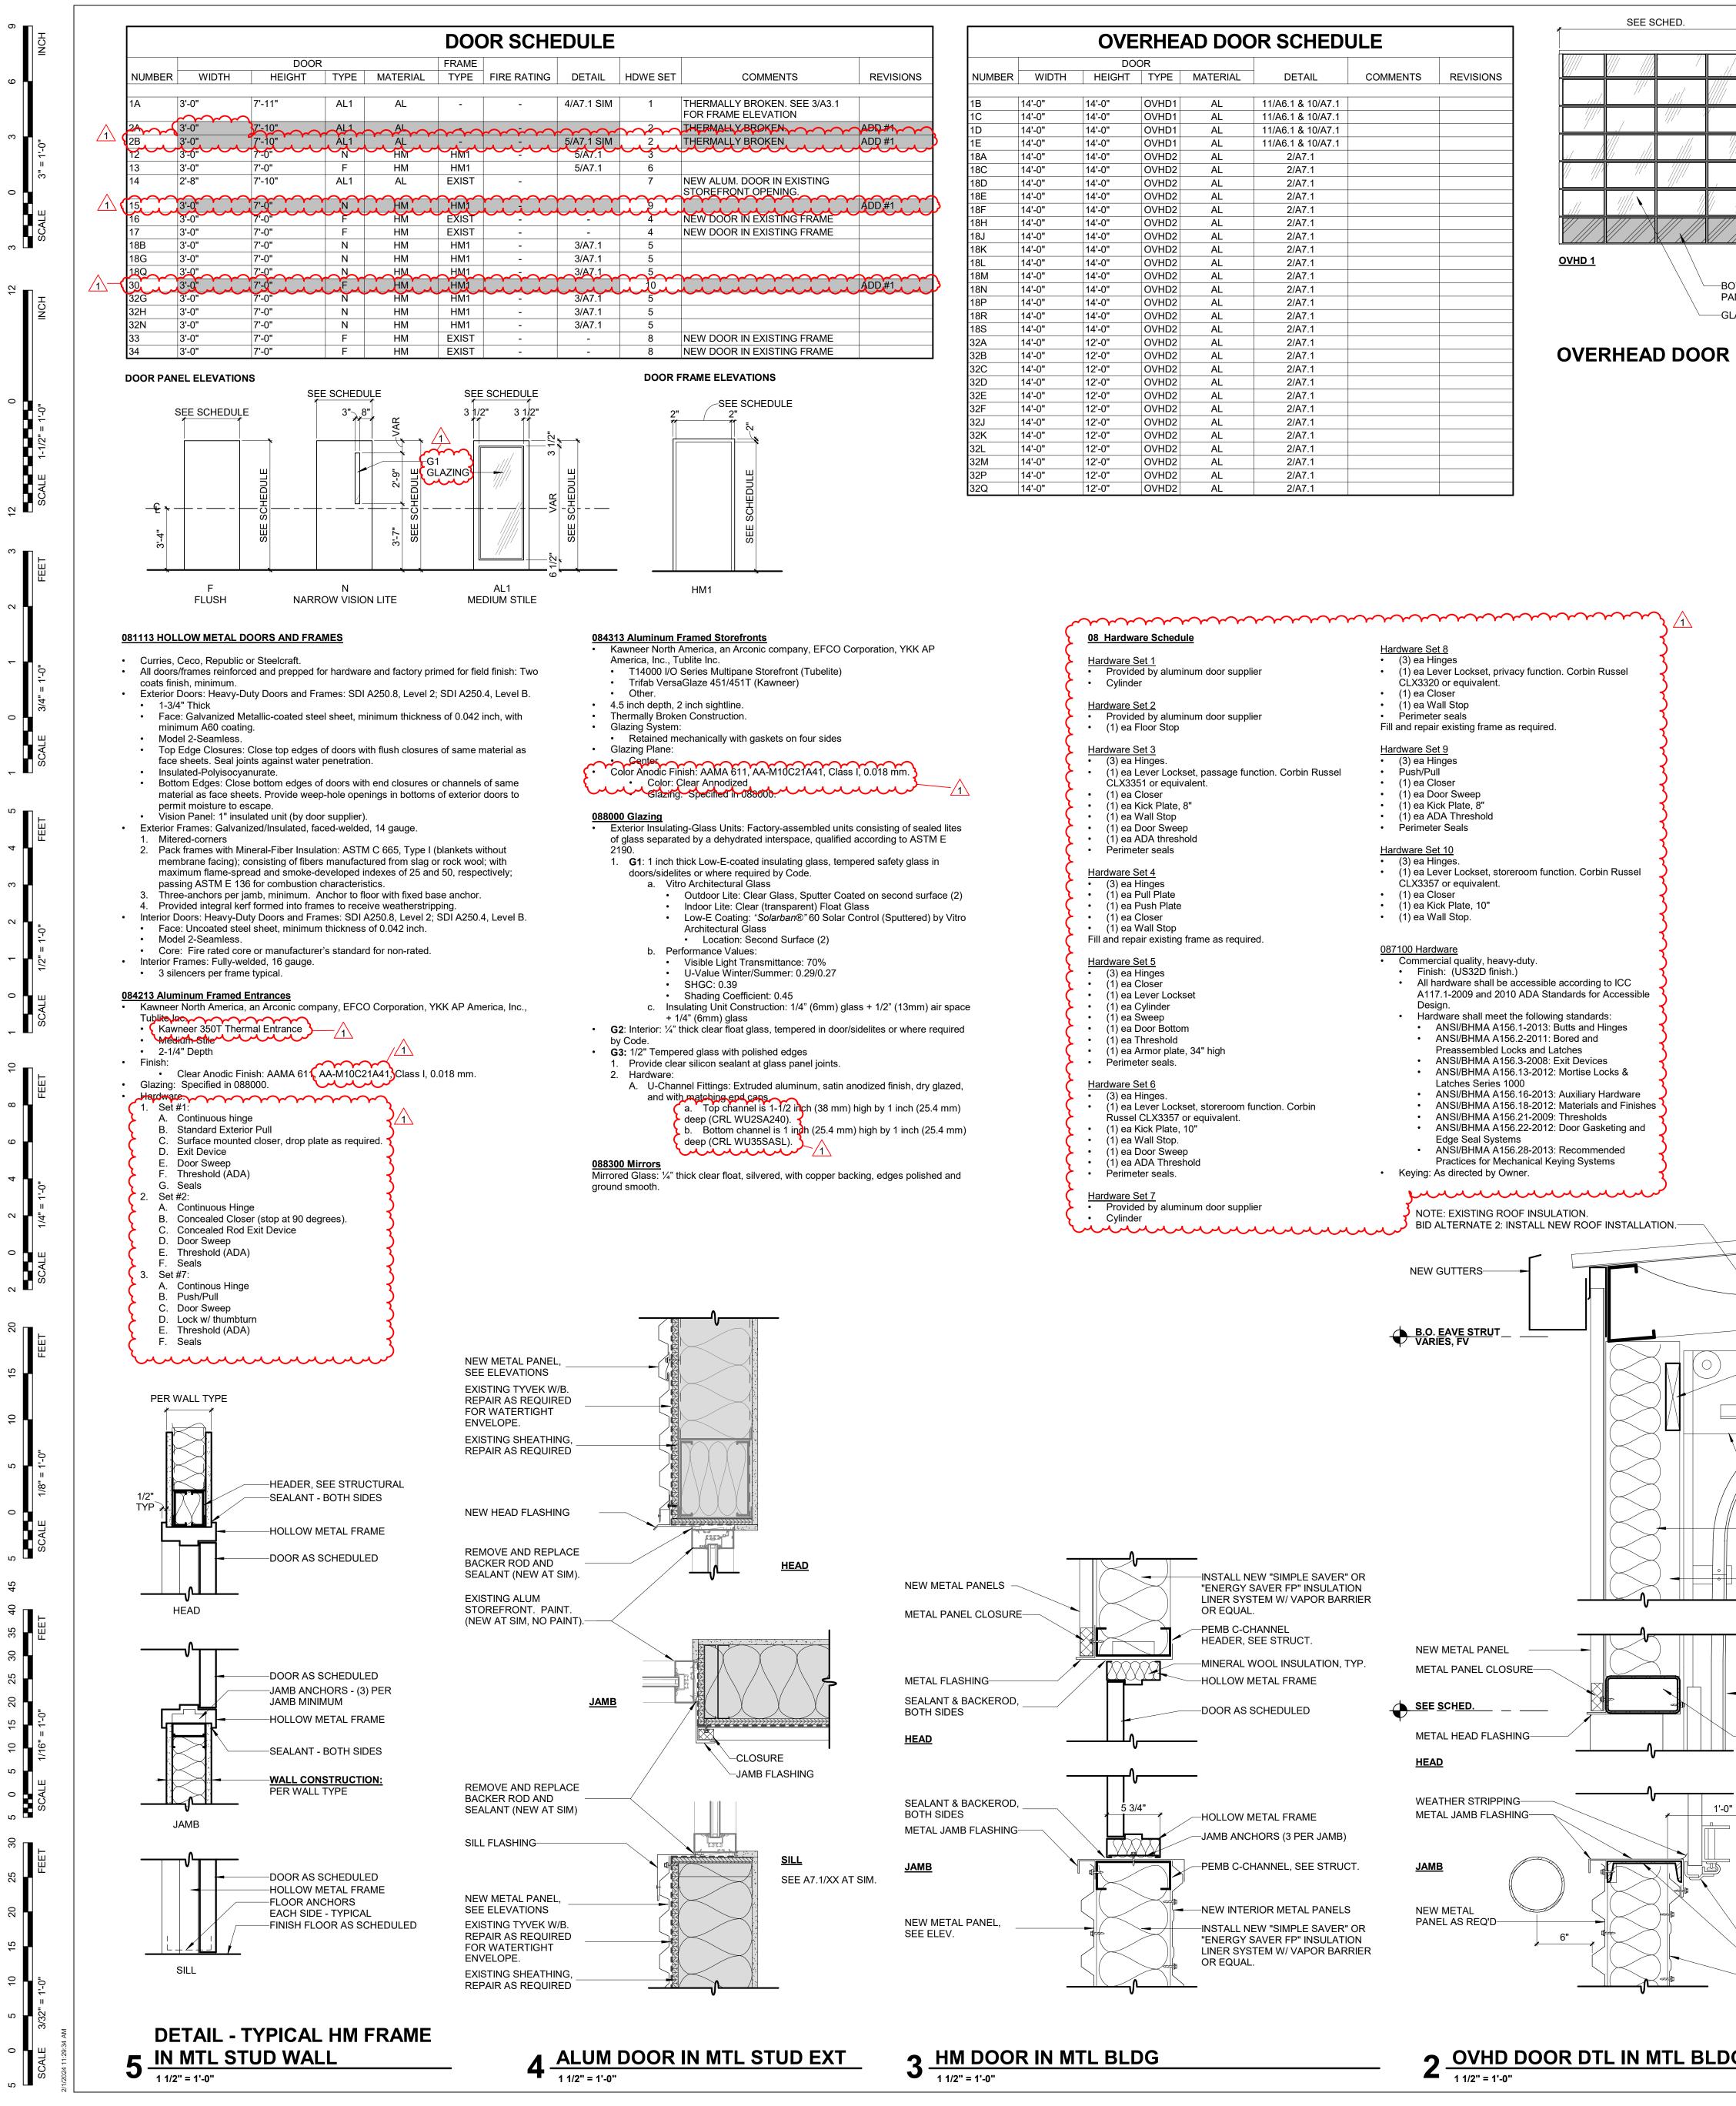


		OVE	RHE	AD DOC	OR SCHEDU	JLE	
		DO	OR				
NUMBER	WIDTH	HEIGHT	TYPE	MATERIAL	DETAIL	COMMENTS	REVISIONS
1B	14'-0"	14'-0"	OVHD1	AL	11/A6.1 & 10/A7.1		
1C	14'-0"	14'-0"	OVHD1	AL	11/A6.1 & 10/A7.1		
1D	14'-0"	14'-0"	OVHD1	AL	11/A6.1 & 10/A7.1		
1E	14'-0"	14'-0"	OVHD1	AL	11/A6.1 & 10/A7.1		
18A	14'-0"	14'-0"	OVHD2	AL	2/A7.1		
18C	14'-0"	14'-0"	OVHD2	AL	2/A7.1		
32A	14'-0"	12'-0"	OVHD2	AL	2/A7.1		
32B	14'-0"	12'-0"	OVHD2	AL	2/A7.1		
32C	14'-0"	12'-0"	OVHD2	AL	2/A7.1		
32D	14'-0"	12'-0"	OVHD2	AL	2/A7.1		
32E	14'-0"	12'-0"	OVHD2	AL	2/A7.1		
32F	14'-0"	12'-0"	OVHD2	AL	2/A7.1		
32J	14'-0"	12'-0"	OVHD2	AL	2/A7.1		
32K	14'-0"	12'-0"	OVHD2	AL	2/A7.1		
32L	14'-0"	12'-0"	OVHD2	AL	2/A7.1		
32M	14'-0"	12'-0"	OVHD2	AL	2/A7.1		
32P	14'-0"	12'-0"	OVHD2	AL	2/A7.1		
32Q	14'-0"	12'-0"	OVHD2	AL	2/A7.1		

	055.0		
	SEE S	CHED.	/
		, //	
	////`		
			/ 1
	////		
<u> </u>			

OVERHEAD DOOR ELEVATIONS


OVHD DOOR DTL IN MTL BLDG

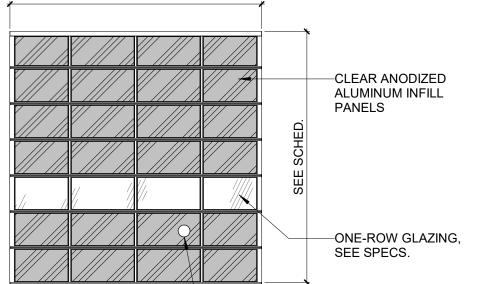

OVHD 2 OM ROW SOLID INFILL PANELS, CLEAR ANODIZED

—GLAZING, SEE SPECS

- Other acceptable manufacturers: CHI Overhead Doors, Clopay Corporation, Ceco/Windsor, Raynor, Wayne-Dalton. . Aluminum Doors: Stile and rail aluminum with solid and glazed panels; lift clearance operating style with track and hardware; complying with DASMA 102, Commercial application. • Coordinate Lift Clearance track configuration for highest possible lift allowed by structure and other equipment. Door Nominal Thickness: 2 inches thick.
- Door Stiles and Rails: Extruded aluminum stiles and rails; infill panels of glass and aluminum; stile and rail joints welded; rabbeted weather joints at meeting rails. Finish: Anodized Finish: Clear anodized
- Glazed Lights Infill Panels: Full panel width, as indicated on the Drawings; set in place with resilient glazing channel. Glass Type: 1/2 inch, Double Strength Insulated Glass. Aluminum Infill Panels: Solid sheet aluminum infill panels in lieu of glazing where indicated on the drawings. Finish to match stiles and rails.
- Provide exhaust port holes where indicated. Operation: Electric.
- Components: • Track: Rolled galvanized steel, 0.120 inch minimum thickness; 3 inch wide, continuous one piece per side; galvanized steel mounting brackets 1/4 inch thick. Hinge and Roller Assemblies: Heavy duty hinges and adjustable roller holders of galvanized steel; floating hardened steel
- bearing rollers, located at top and bottom of each panel, each side. • Lift Mechanism: Spring counterbalance, heavy duty, oil-tempered wire torsion springs on a continuous ball bearing cross head shaft, with galvanized aircraft type steel lifting cables with a minimum safety factor of 5:1. Provide high cycle (100,000 cycle) springs at all doors.
- Sill Weatherstripping: Resilient hollow rubber strip, one piece; fitted to bottom of door panel, full length contact. • Jamb Weatherstripping: Roll formed aluminum section full height of jamb, fitted with resilient weatherstripping, placed in moderate contact with door panels.
- Head Weatherstripping: EPDM rubber seal, one piece full length. • Panel Joint Weatherstripping: Neoprene foam seal, one piece full length.
- Lock: Omit Lock. 4. Electrical Operation
- Operation of the Sectional Doors is to be as follows: • Provide toggle switch at each door location with a 'Falcon' sensor to cut power to the controls when service is closed. • Provide one bank of controls that will operate all four doors - north and south sides of Service Drive 1 - for convenience purposes, as shown on the Drawings.
- Remote controls are acceptable only at the Service Drive 1 area. Each remote shall be 4-button to control all doors at the Service Drive. • Operator, Controls, Actuators, and Safeties: Comply with UL 325; provide products listed by a testing agency acceptable to authorities having jurisdiction. Electrical Characteristics:
- 1/2 hp, 120v, single phase; manually operable in case of power failure, transit speed of 12 inches per second. Wiring Terminations: Provide terminal lugs to match branch circuit conductor quantities, sizes, and materials indicated. Enclose terminal lugs in terminal box sized to NFPA 70. Disconnect Switch: Factory mount disconnect switch in control panel.
- Electric Operator: Side mounted on cross head shaft, adjustable safety friction clutch; brake system actuated by independent voltage solenoid controlled by motor starter; enclosed gear driven limit switch; enclosed magnetic cross line reversing starter; mounting brackets and hardware.
- Include manufacturers standard adjustable timer. • Safety Edge: At bottom of door panel, full width; electro-mechanical sensitized type, wired to stop door upon striking object; hollow neoprene covered to provide weatherstrip seal.
- Photocells: FOS-1, NEMA 4, Exterior Through-Beam Photocell. Provide at all doors.
- Motion Detector: Falcon Motion Detector. Wall mounted per manufactures recommendation
- Provide at openings 1B, and 1C. • Provide Toggle-switch to disconnect Motion Detectors; Coordinate with Electrical:
- Toggle-switch Location 1: Disconnects doors 1B and 1C at the Service Drive. • Control Station: Standard three button (open-close-stop) momentary type control for each electric operator.
- 24 volt circuit. Surface mounted.
- Locate where indicated on the Drawings. Hand Held Transmitter: Manufacturers Standard Digital control, resettable. Provide (1) set for each service advisor for doors 1B, 1C, 1D, and 1E.

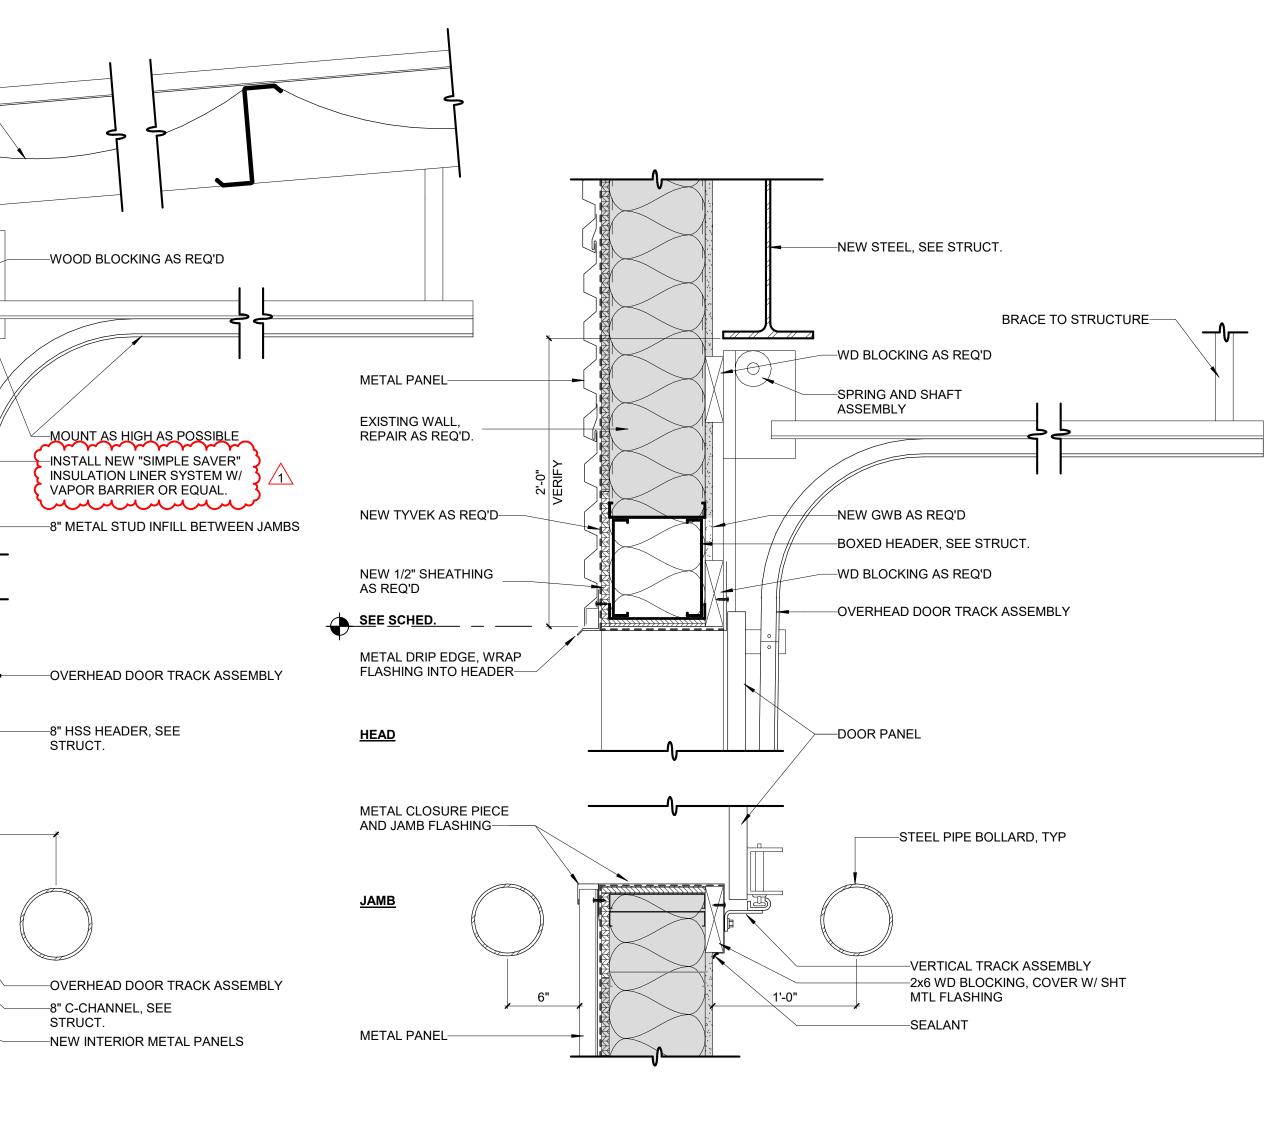

OVHD DOOR DTL 1 1/2" = 1'-0"




ARCHITECT **BVH ARCHITECTURE** 901 JONES STREET OMAHA NE 68102 V 402 345 3060 F 402 345 7871 bvh.com

CIVIL ENGINEER LAMP RYNEARSON 14710 W DODGE RD #100 OMAHA, NE 68154 V 402 496 2498 Ira-inc.com

STRUCTURAL ENGINEER LANGE STRUCTURAL GROUP 1919 S 40TH STREET, SUITE 302 LINCOLN NE 68506 V 402 421 9540 langestructuralgroup.com

MEP ENGINEER MORRISSEY ENGINEERING 4940 N 118TH ST OMAHA, NE 68164 V 402 491 4144 morrisseyengineering.com

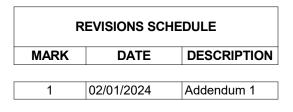




PROJECT: 23043 **DATE:** DEC 19, 2023 PROJECT STATUS: CD SUBMITTAL © COPYRIGHT BVH ARCHITECTURE





A7.1

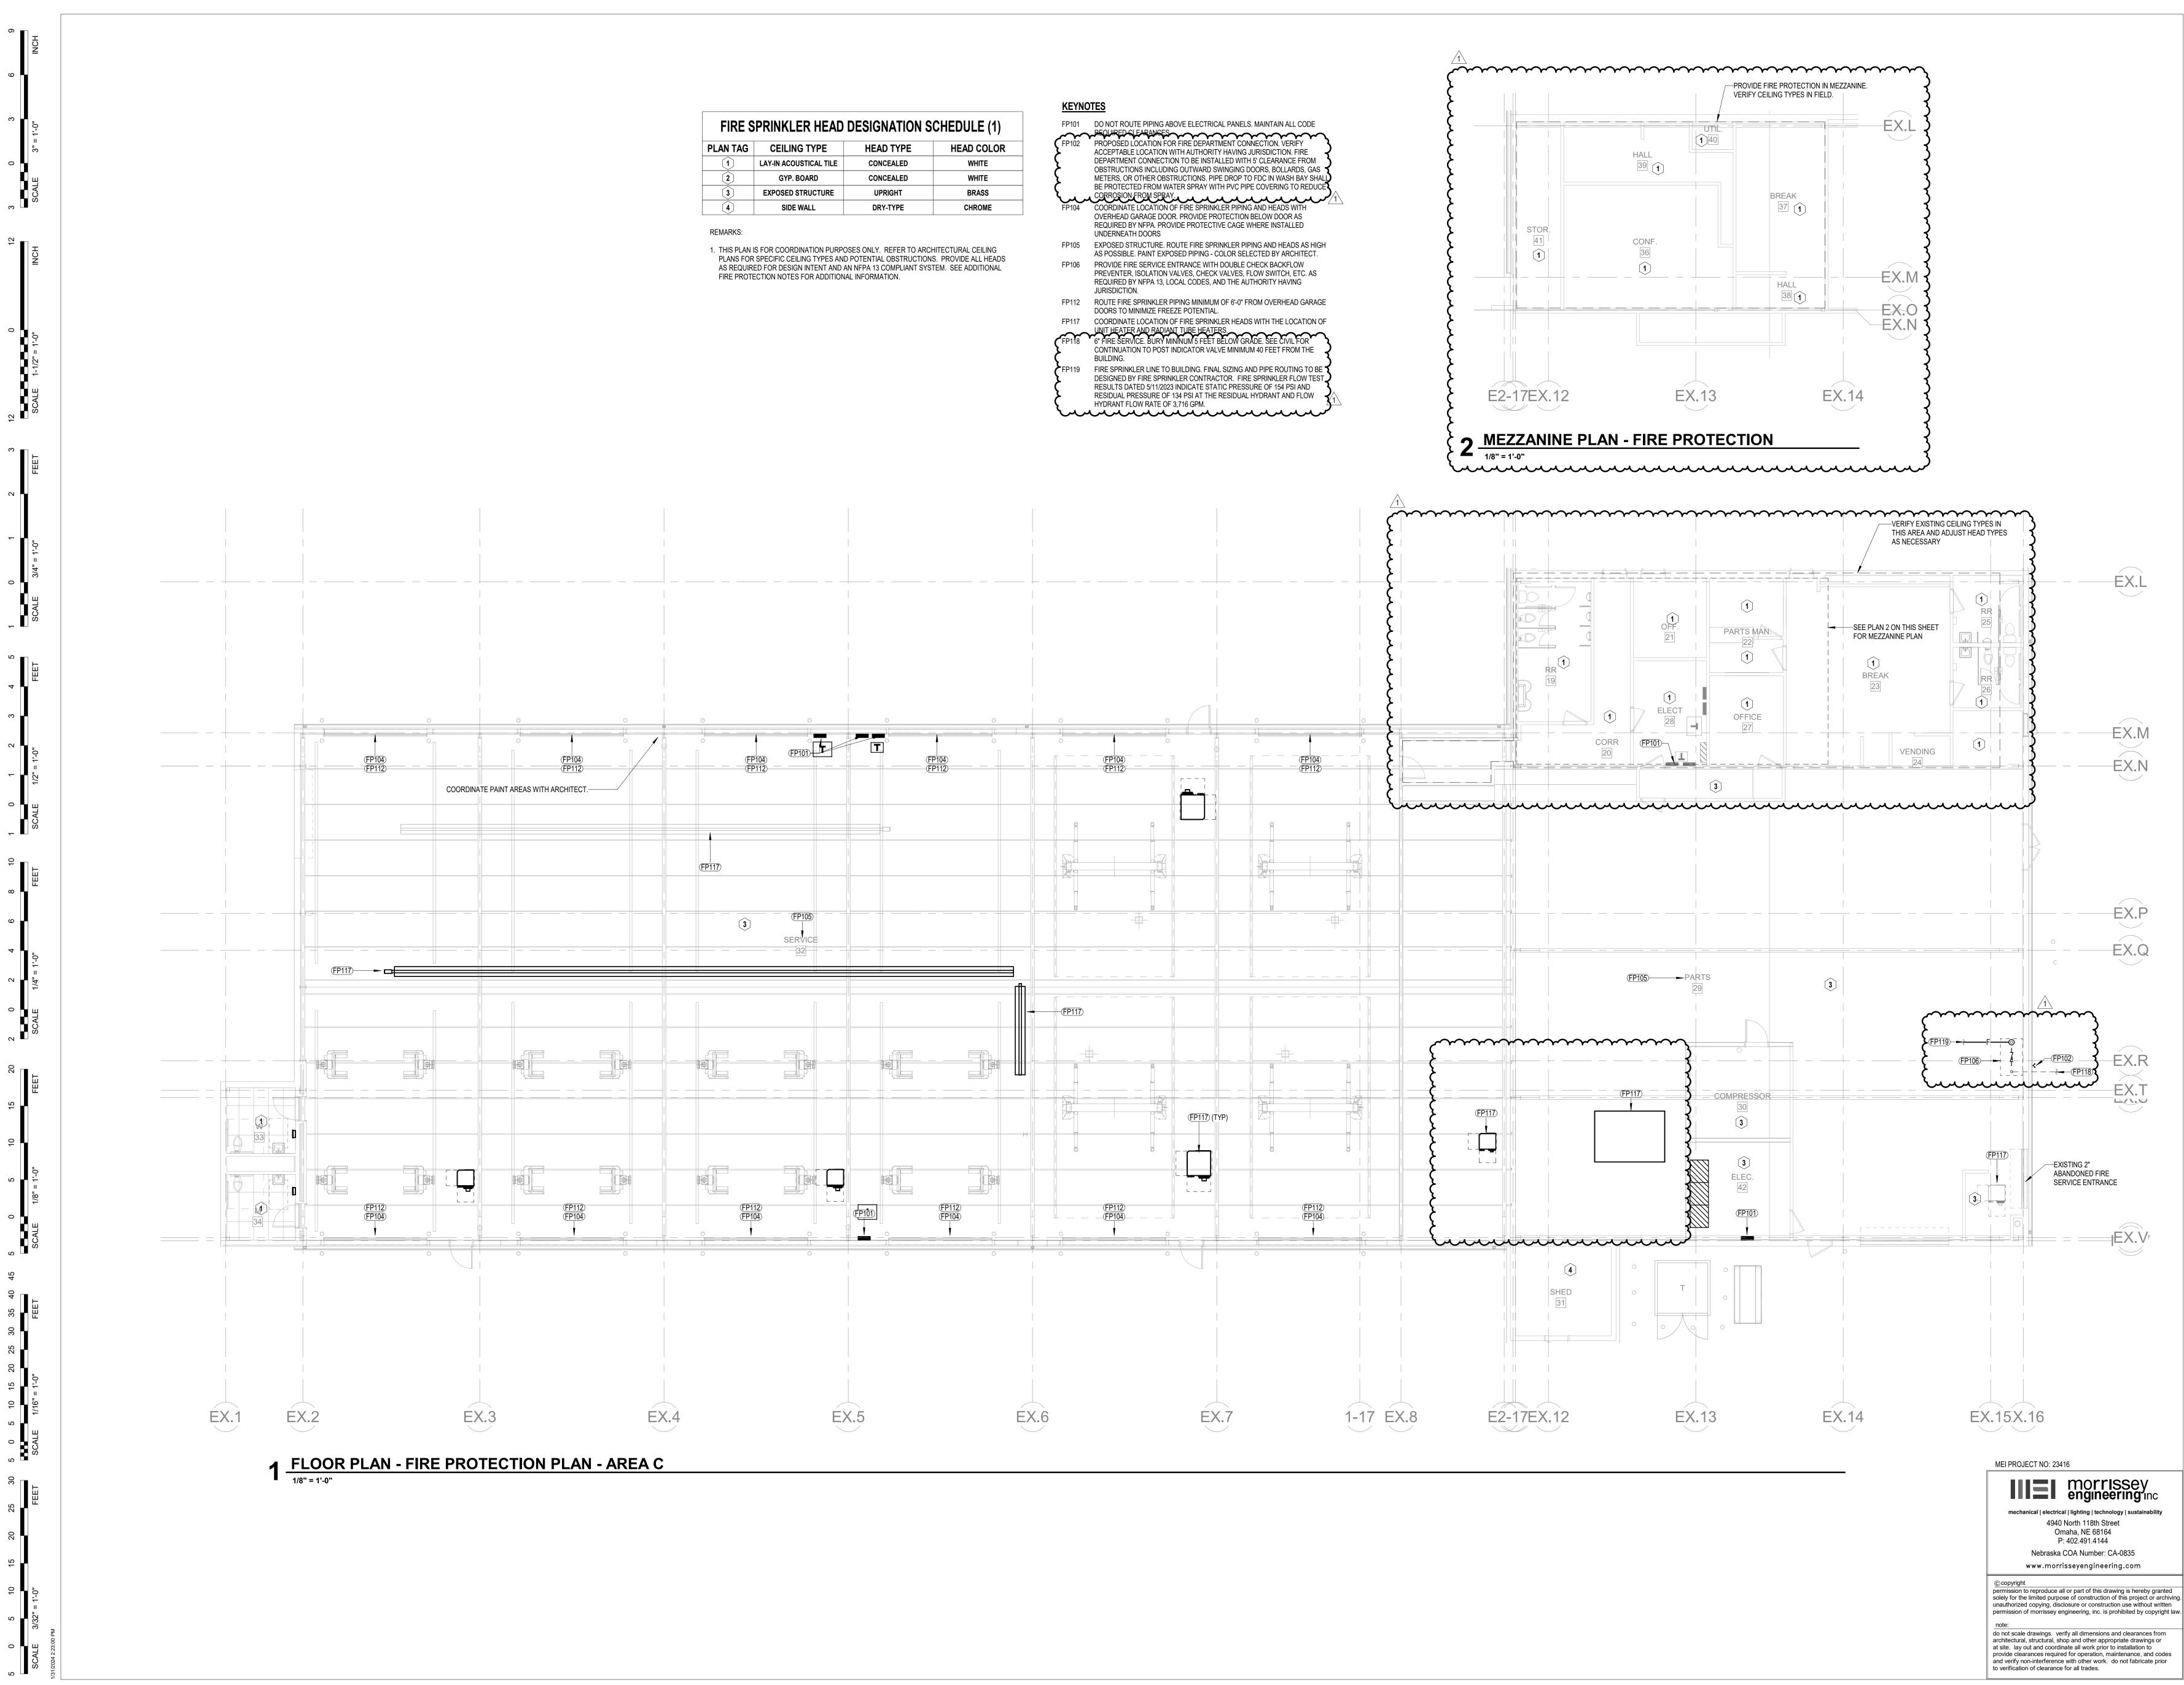

PLAN TAG	CEILING TYPE	HEAD TYPE	HEAD COLOR
1	LAY-IN ACOUSTICAL TILE	CONCEALED	WHITE
2	GYP. BOARD	CONCEALED	WHITE
3	EXPOSED STRUCTURE	UPRIGHT	BRASS
4	SIDE WALL	DRY-TYPE	CHROME







CIVIL ENGINEER LAMP RYNEARSON 14710 W DODGE RD #100 OMAHA, NE 68154 V 402 496 2498 Ira-inc.com

STRUCTURAL ENGINEER LANGE STRUCTURAL GROUP 1919 S 40TH STREET, SUITE 302 LINCOLN NE 68506 V 402 421 9540 langestructuralgroup.com

MEP ENGINEER MORRISSEY ENGINEERING 4940 N 118TH ST OMAHA, NE 68164 V 402 491 4144 morrisseyengineering.com

CONSTRUCTION MANAGER MCL CONSTRUCTION 14124 INDUSTRIAL RD OMAHA, NE 68144 V 402 339 2221 mclconstruction.com

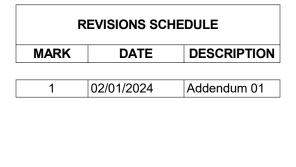

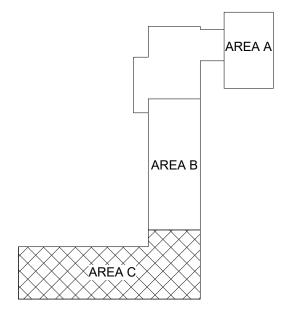


WOODHOUSE FORD PRO: BUILDING IMPROVEMENTS

PROJECT: 23043 **DATE:** JANUARY 19, 2024 PROJECT STATUS: CONSTRUCTION © COPYRIGHT BVH ARCHITECTURE







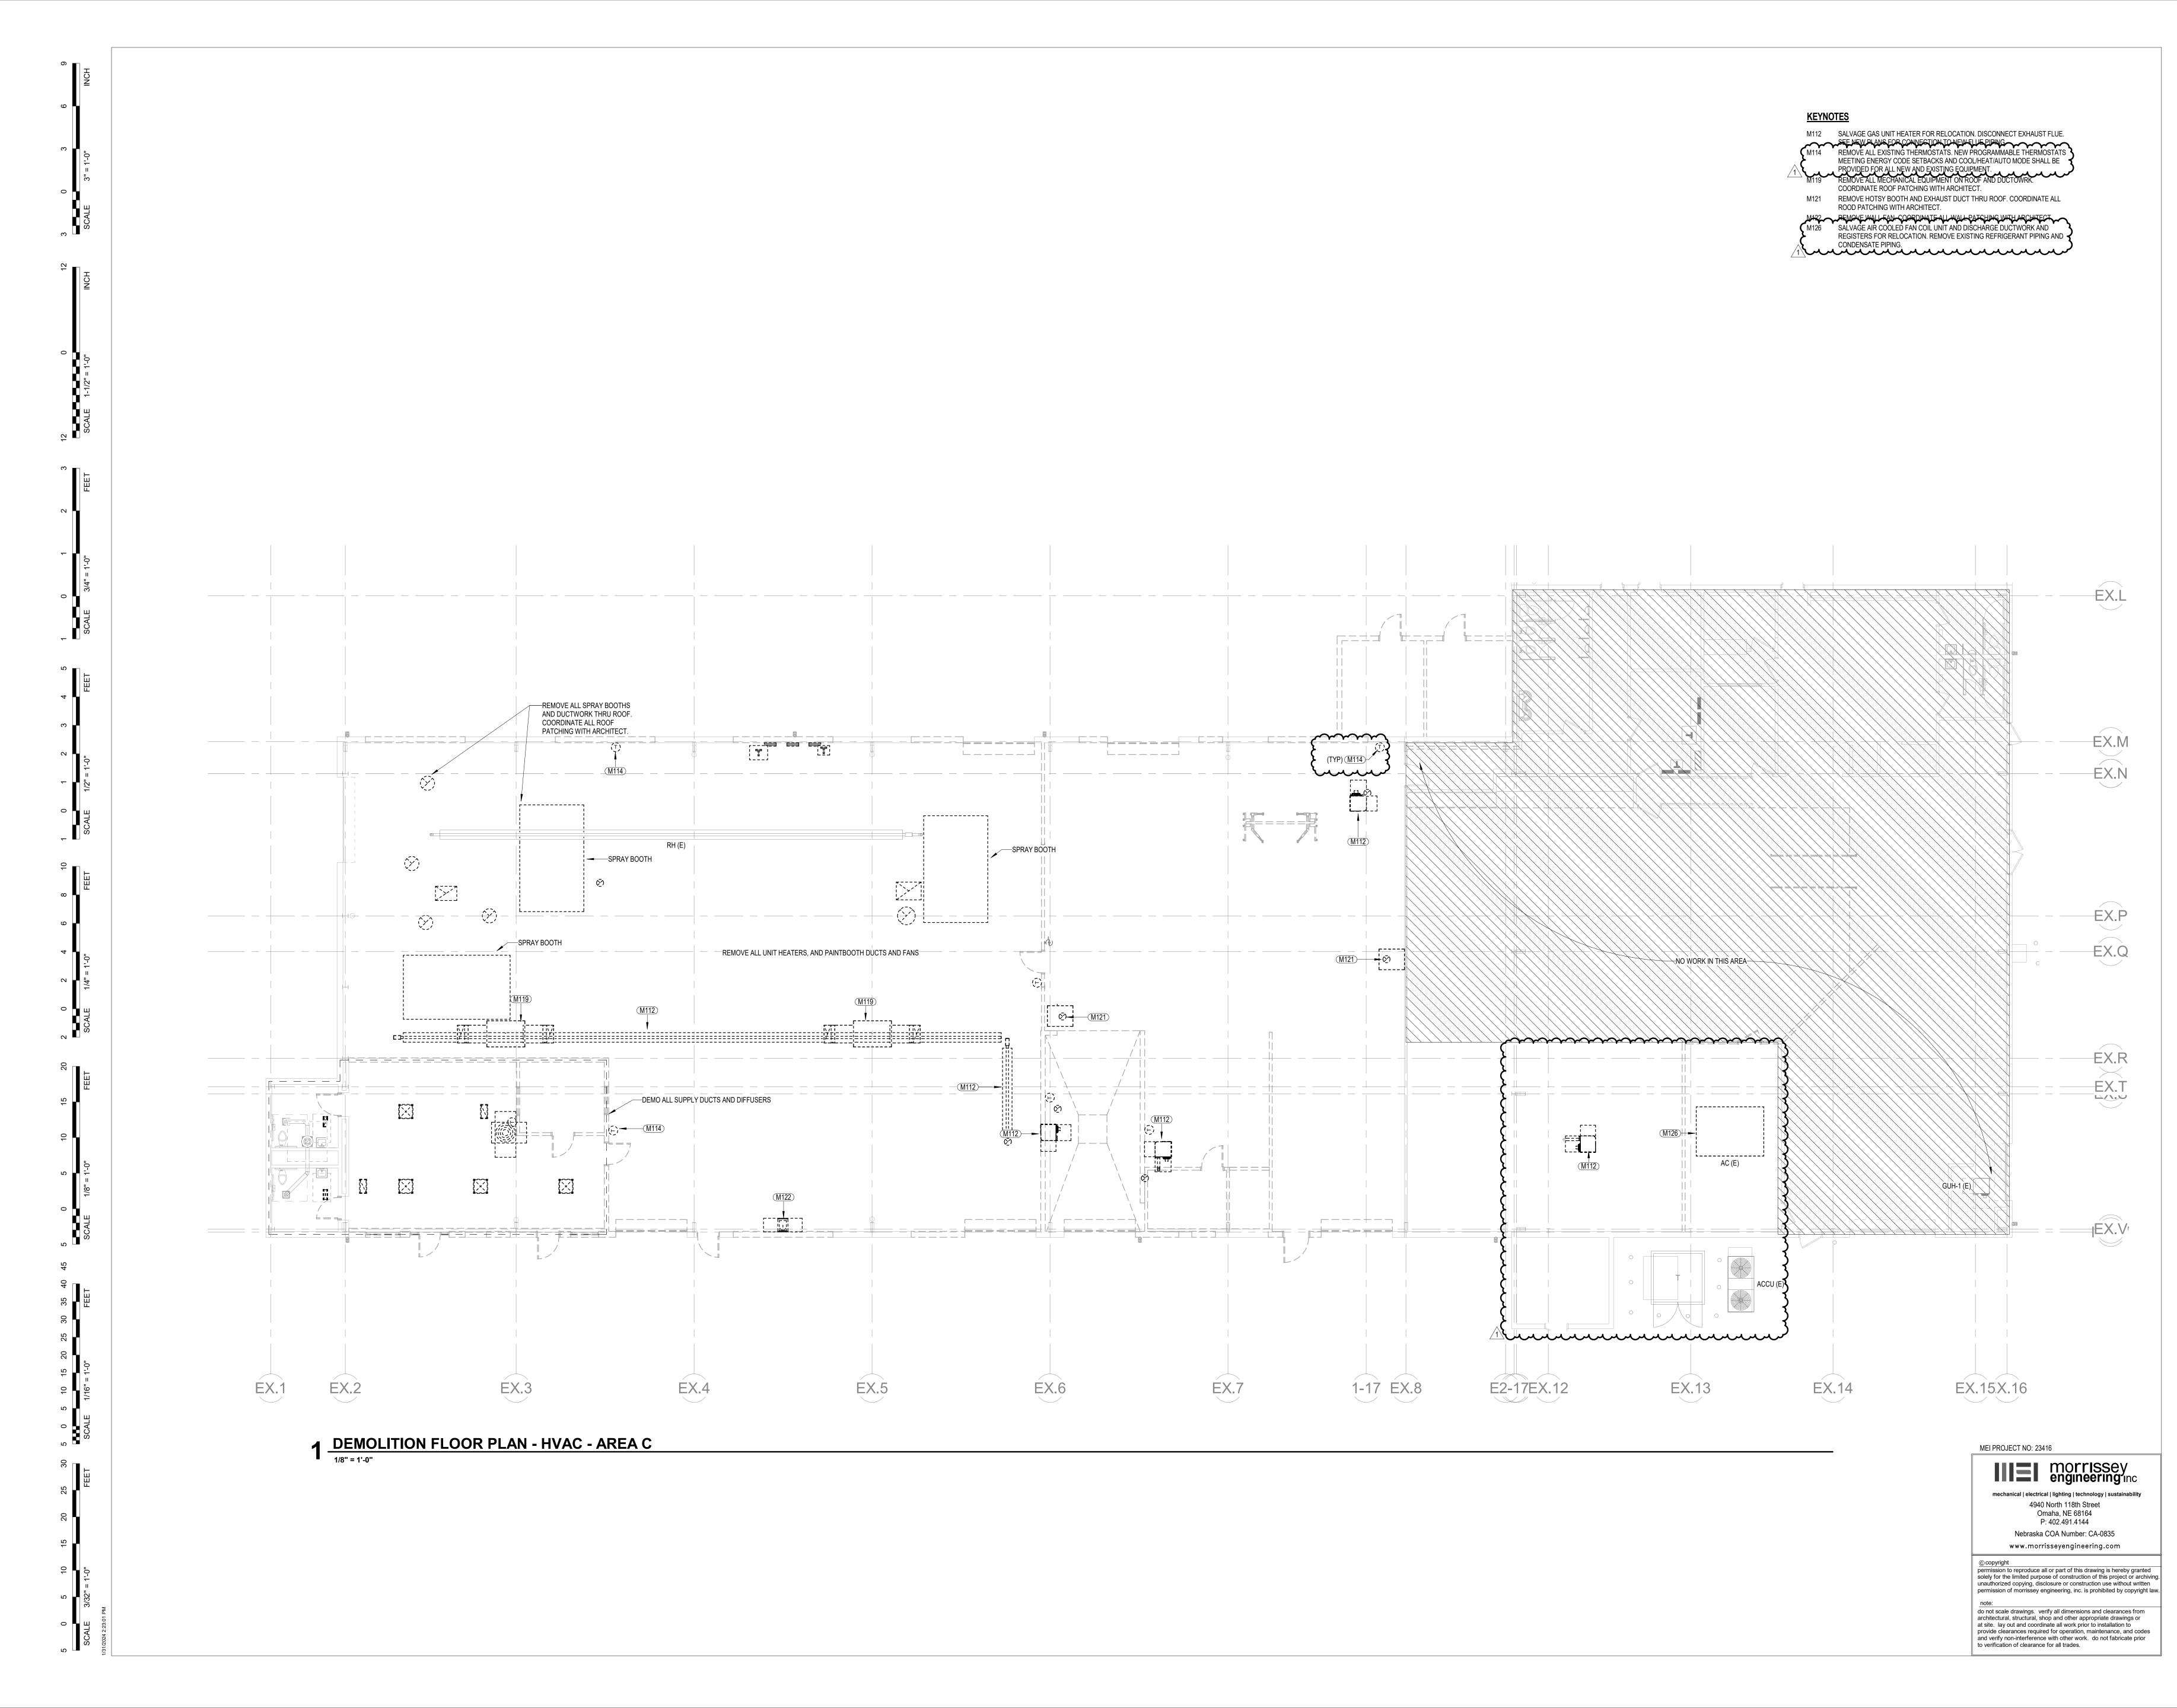





CIVIL ENGINEER LAMP RYNEARSON 14710 W DODGE RD #100 OMAHA, NE 68154 V 402 496 2498 Ira-inc.com

STRUCTURAL ENGINEER LANGE STRUCTURAL GROUP 1919 S 40TH STREET, SUITE 302 LINCOLN NE 68506 V 402 421 9540 langestructuralgroup.com

MEP ENGINEER MORRISSEY ENGINEERING 4940 N 118TH ST OMAHA, NE 68164 V 402 491 4144 morrisseyengineering.com

CONSTRUCTION MANAGER MCL CONSTRUCTION 14124 INDUSTRIAL RD OMAHA, NE 68144 V 402 339 2221 mclconstruction.com

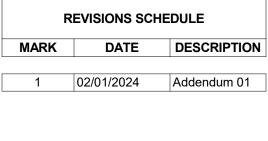

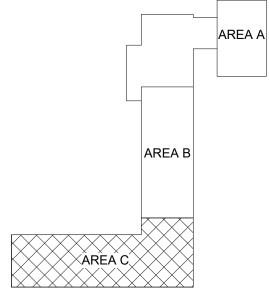

WOODHOUSE FORD PRO: BUILDING IMPROVEMENTS

 PROJECT: 23043
 DATE: JANUARY 19, 2024


 PROJECT STATUS:
 CONSTRUCTION DOCUMENTS

 © COPYRIGHT BVH ARCHITECTURE
 DOCUMENTS







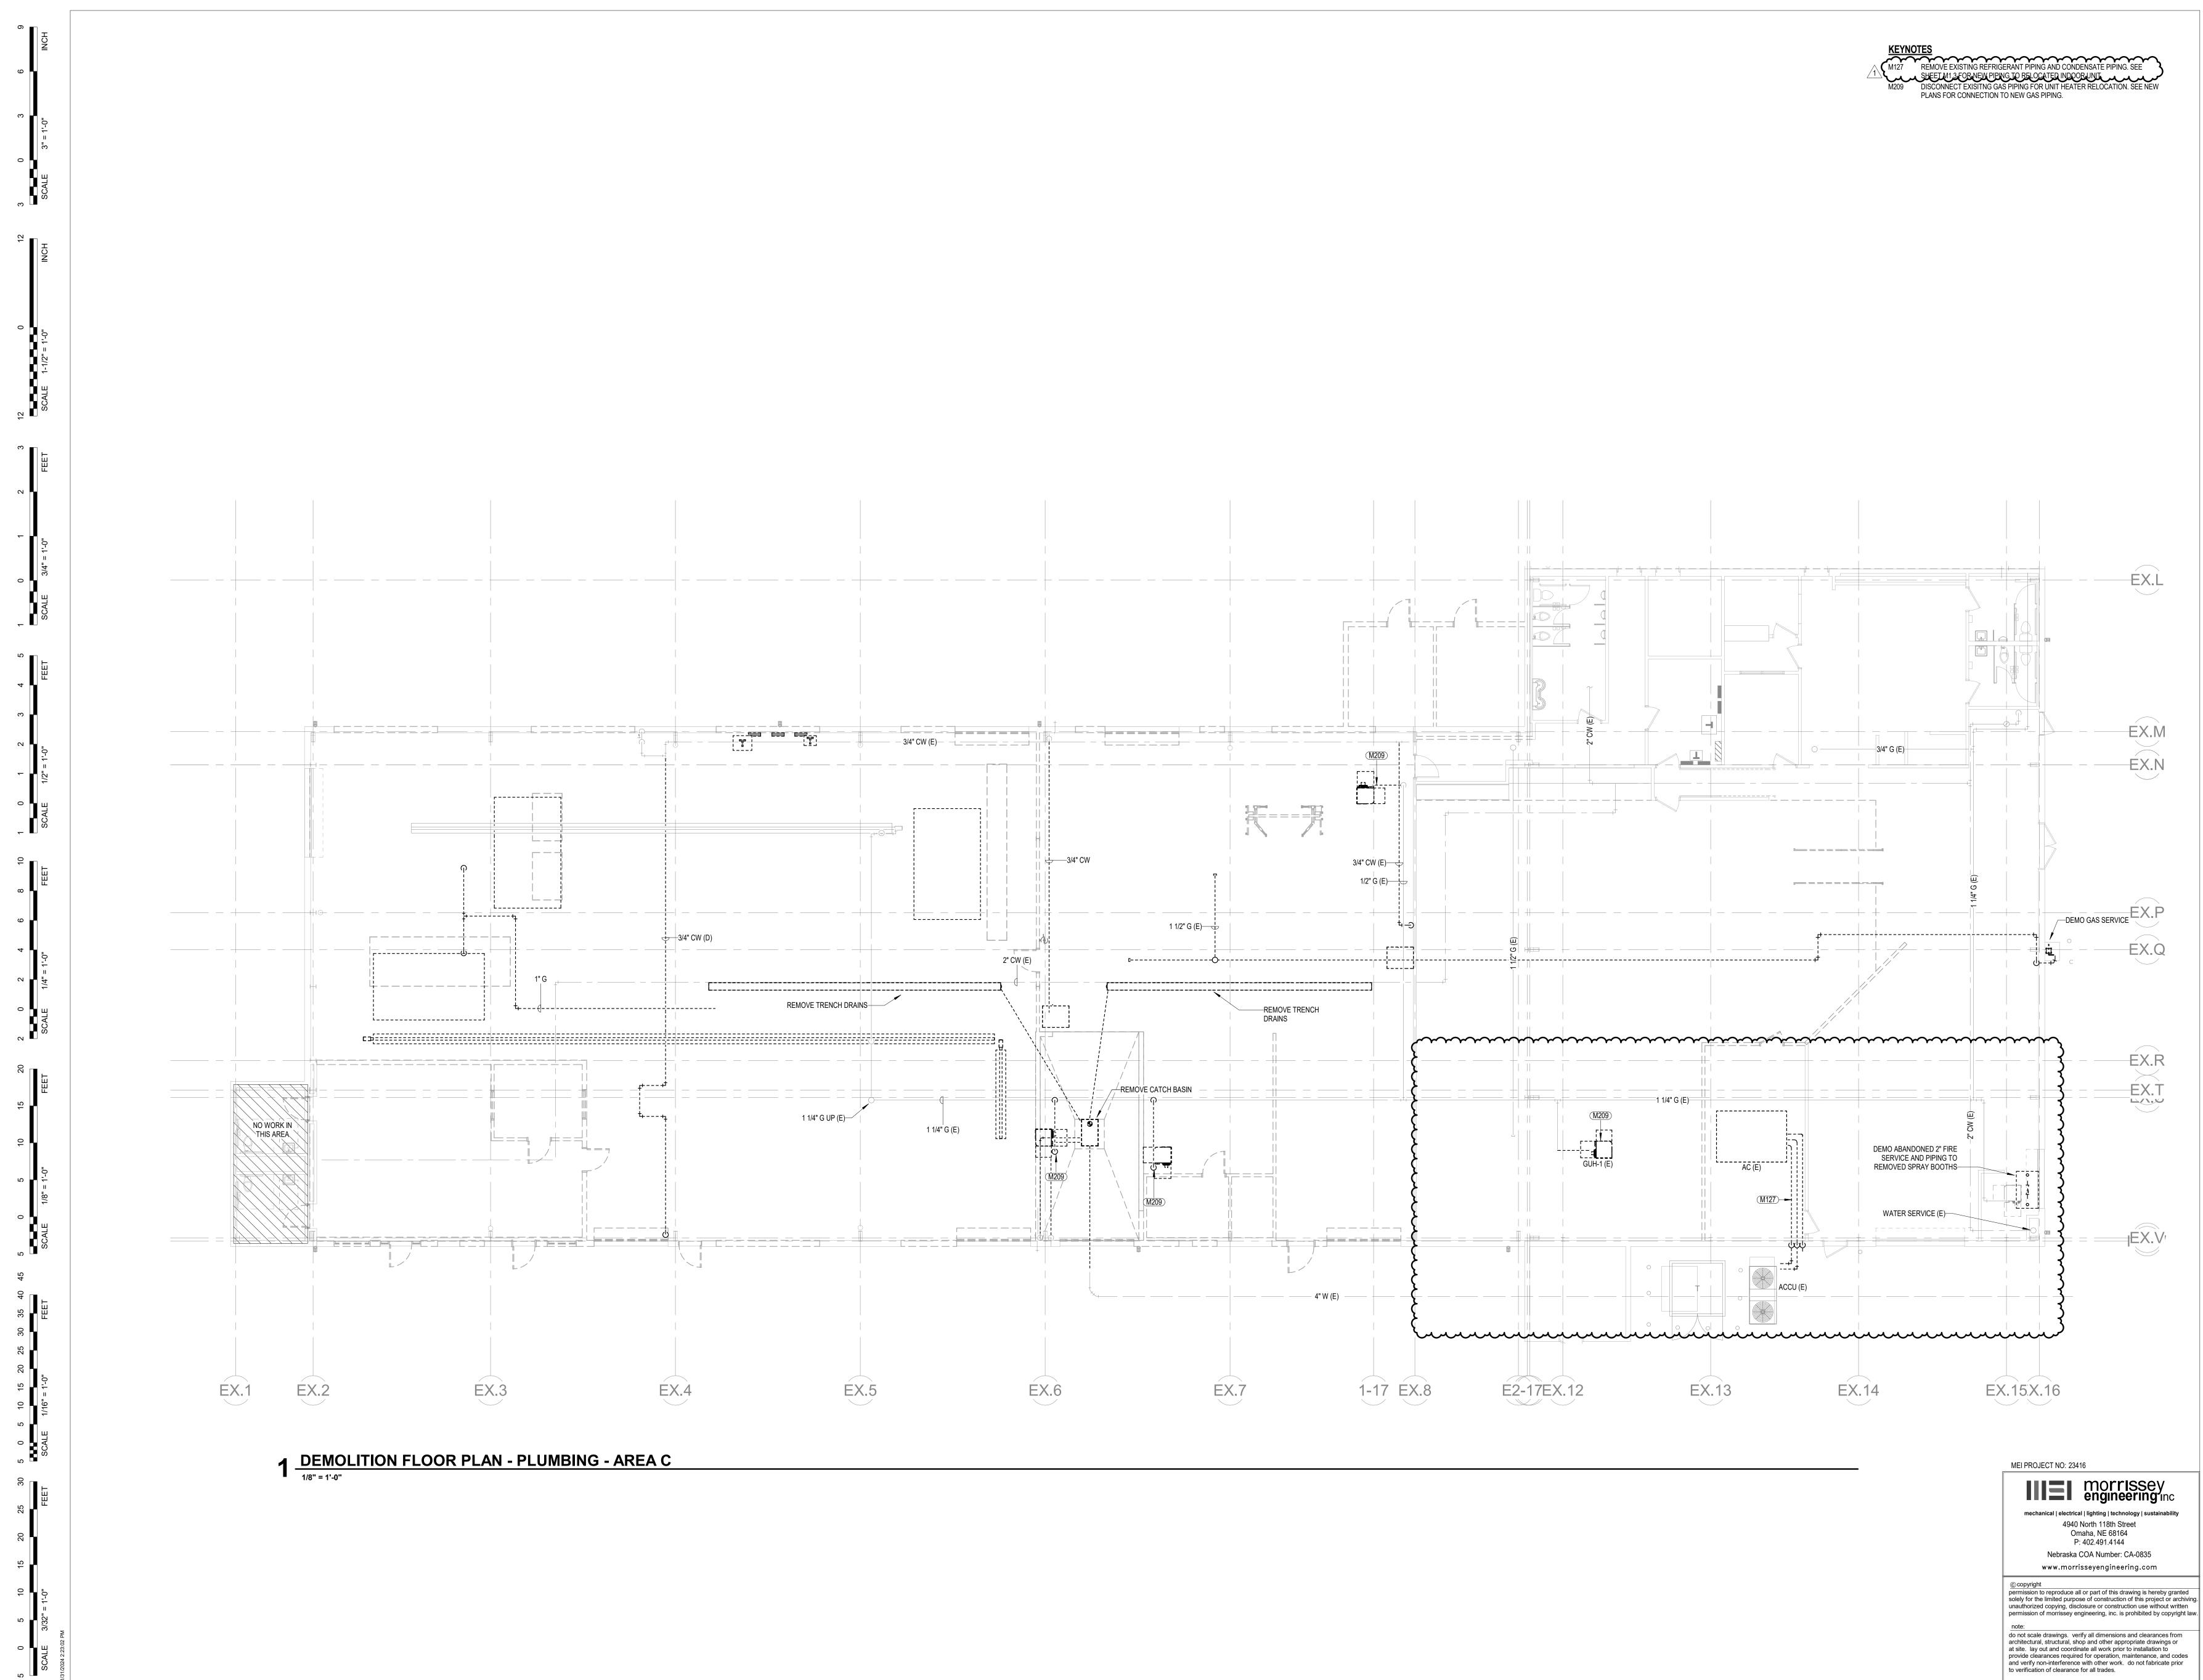

mechanical | electrical | lighting | technology | sustainability permission to reproduce all or part of this drawing is hereby granted




ARCHITECT **BVH ARCHITECTURE** 901 JONES STREET OMAHA NE 68102 V 402 345 3060 F 402 345 7871 bvh.com


CIVIL ENGINEER LAMP RYNEARSON 14710 W DODGE RD #100 OMAHA, NE 68154 V 402 496 2498 Ira-inc.com

STRUCTURAL ENGINEER LANGE STRUCTURAL GROUP 1919 S 40TH STREET, SUITE 302 LINCOLN NE 68506 V 402 421 9540 langestructuralgroup.com

MEP ENGINEER MORRISSEY ENGINEERING 4940 N 118TH ST OMAHA, NE 68164 V 402 491 4144 morrisseyengineering.com

CONSTRUCTION MANAGER MCL CONSTRUCTION 14124 INDUSTRIAL RD OMAHA, NE 68144 V 402 339 2221 mclconstruction.com

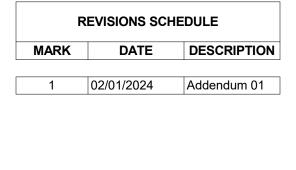

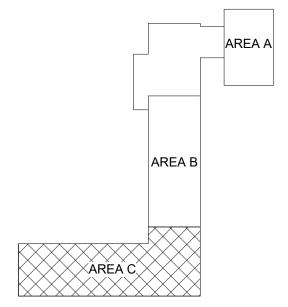


WOODHOUSE FORD PRO: BUILDING IMPROVEMENTS


PROJECT: 23043 **DATE:** JANUARY 19, 2024 PROJECT STATUS: CONSTRUCTION © COPYRIGHT BVH ARCHITECTURE









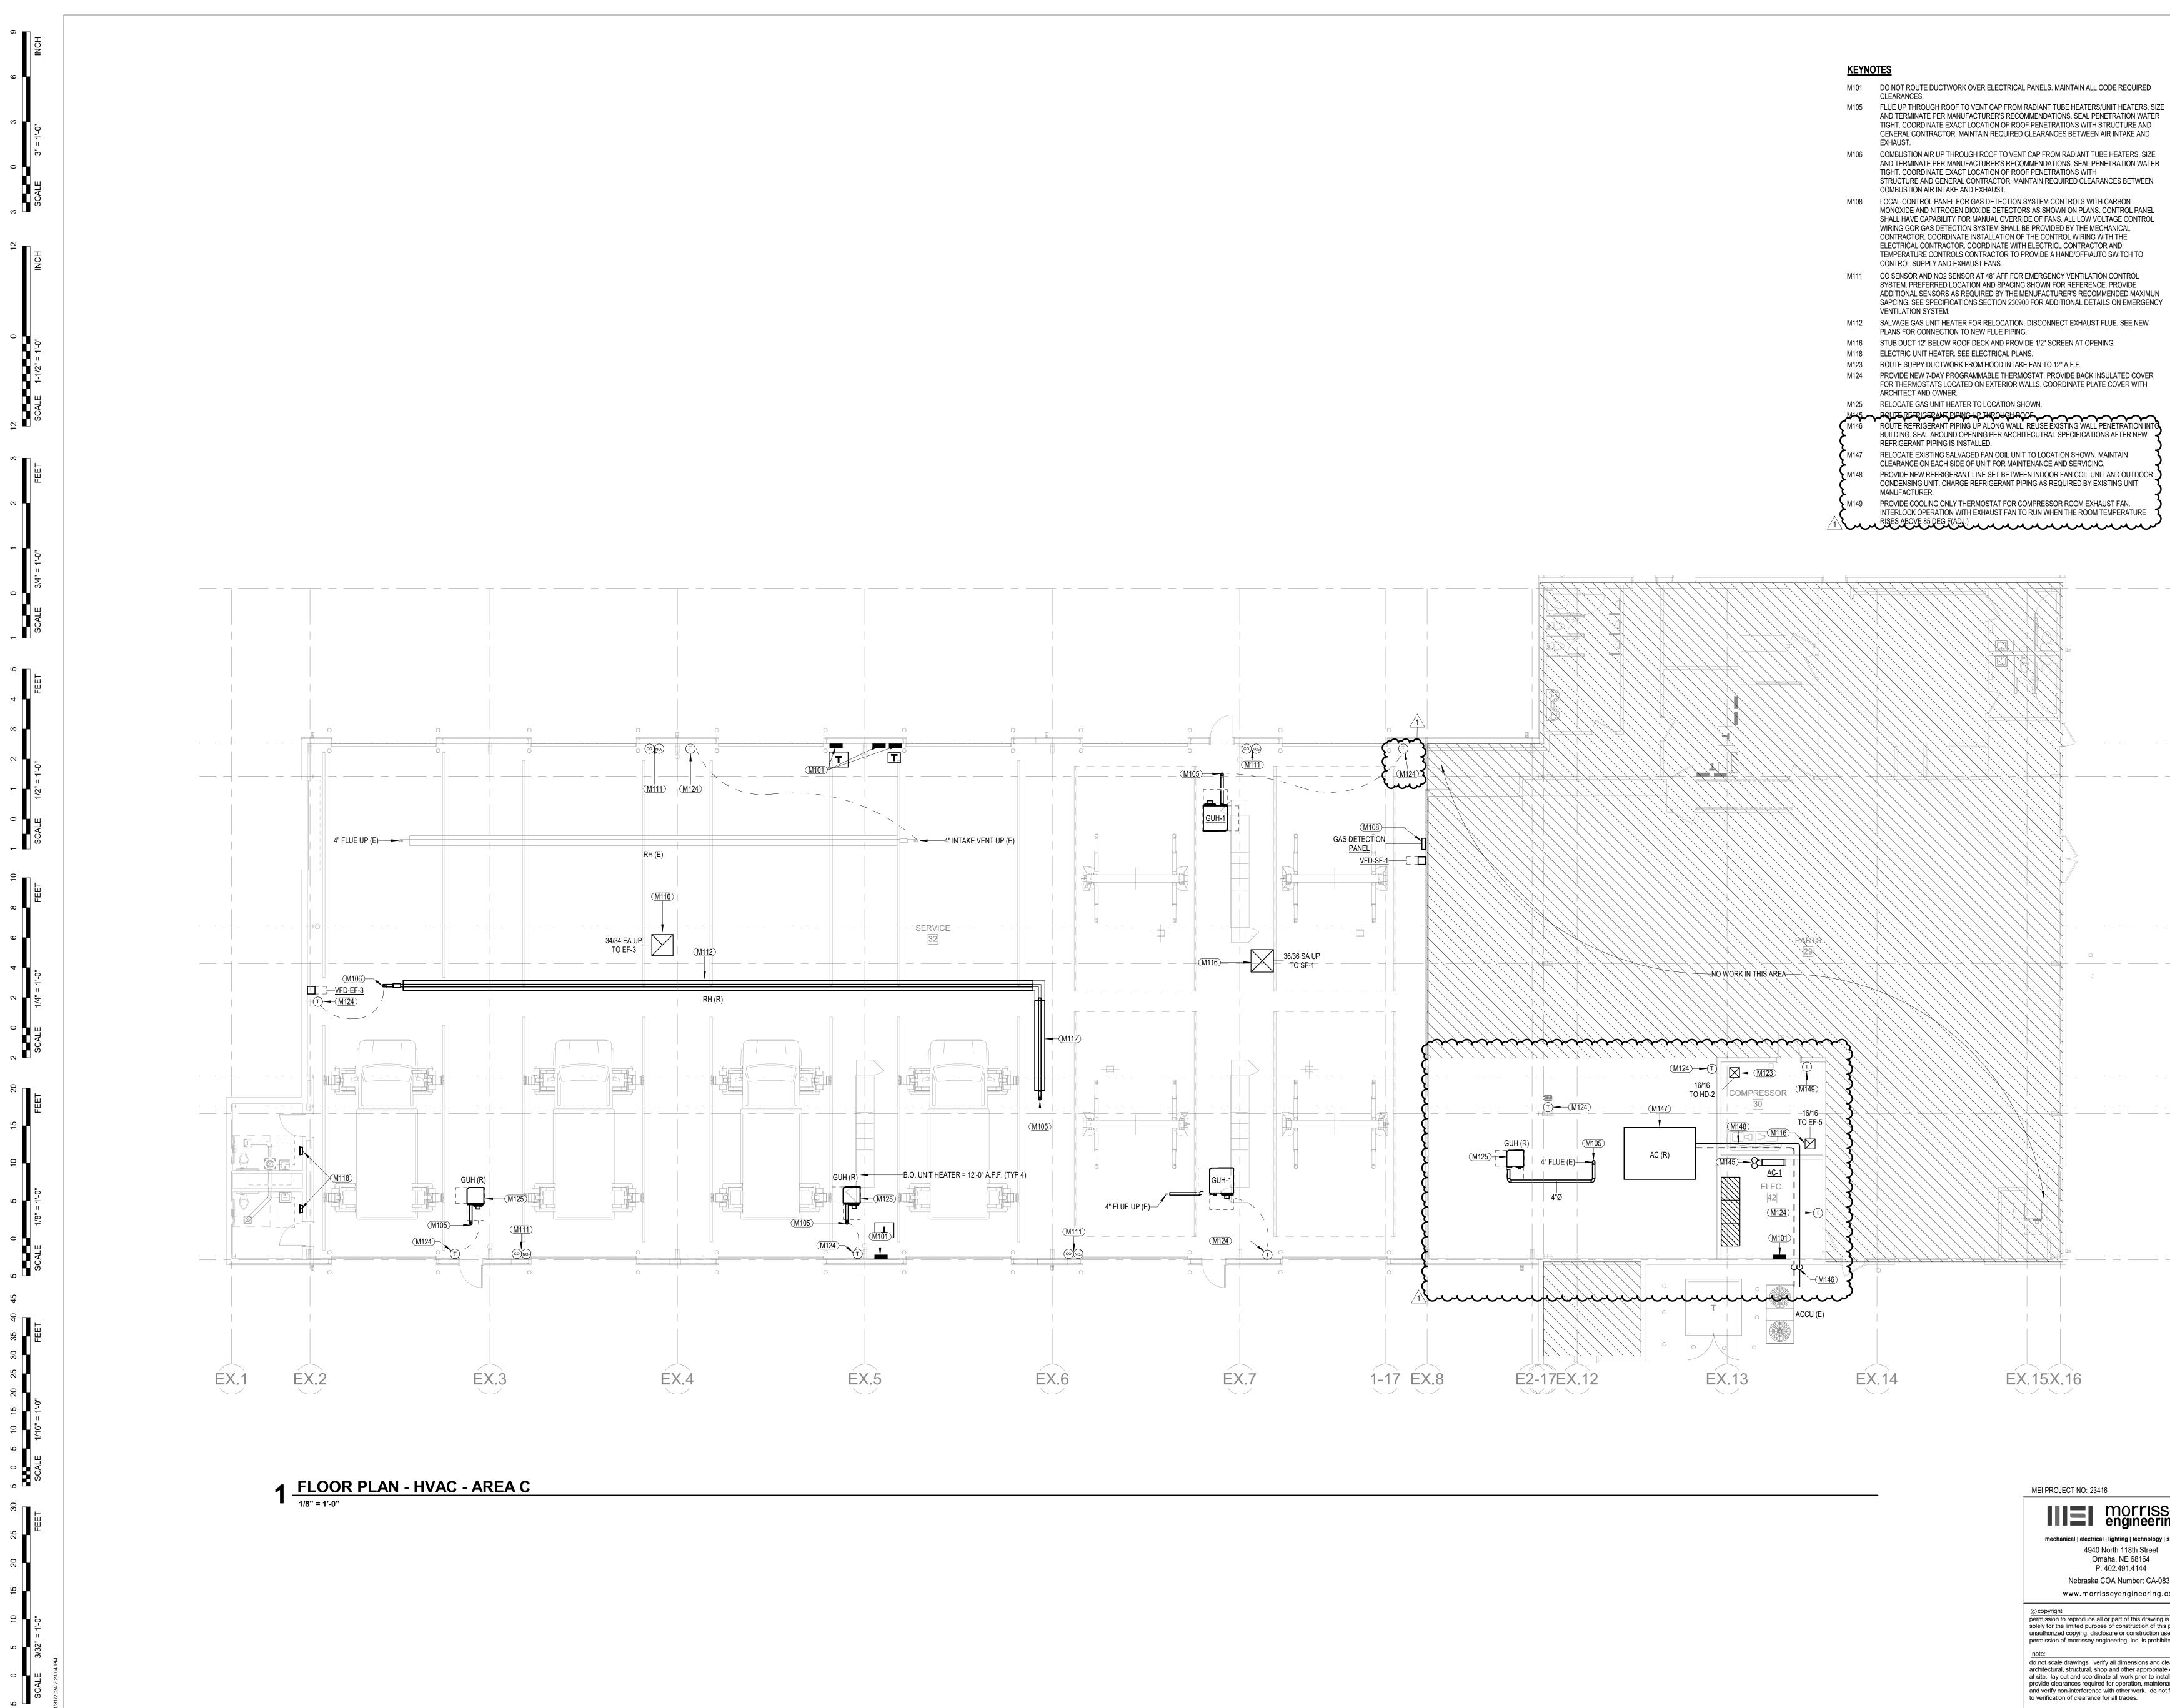


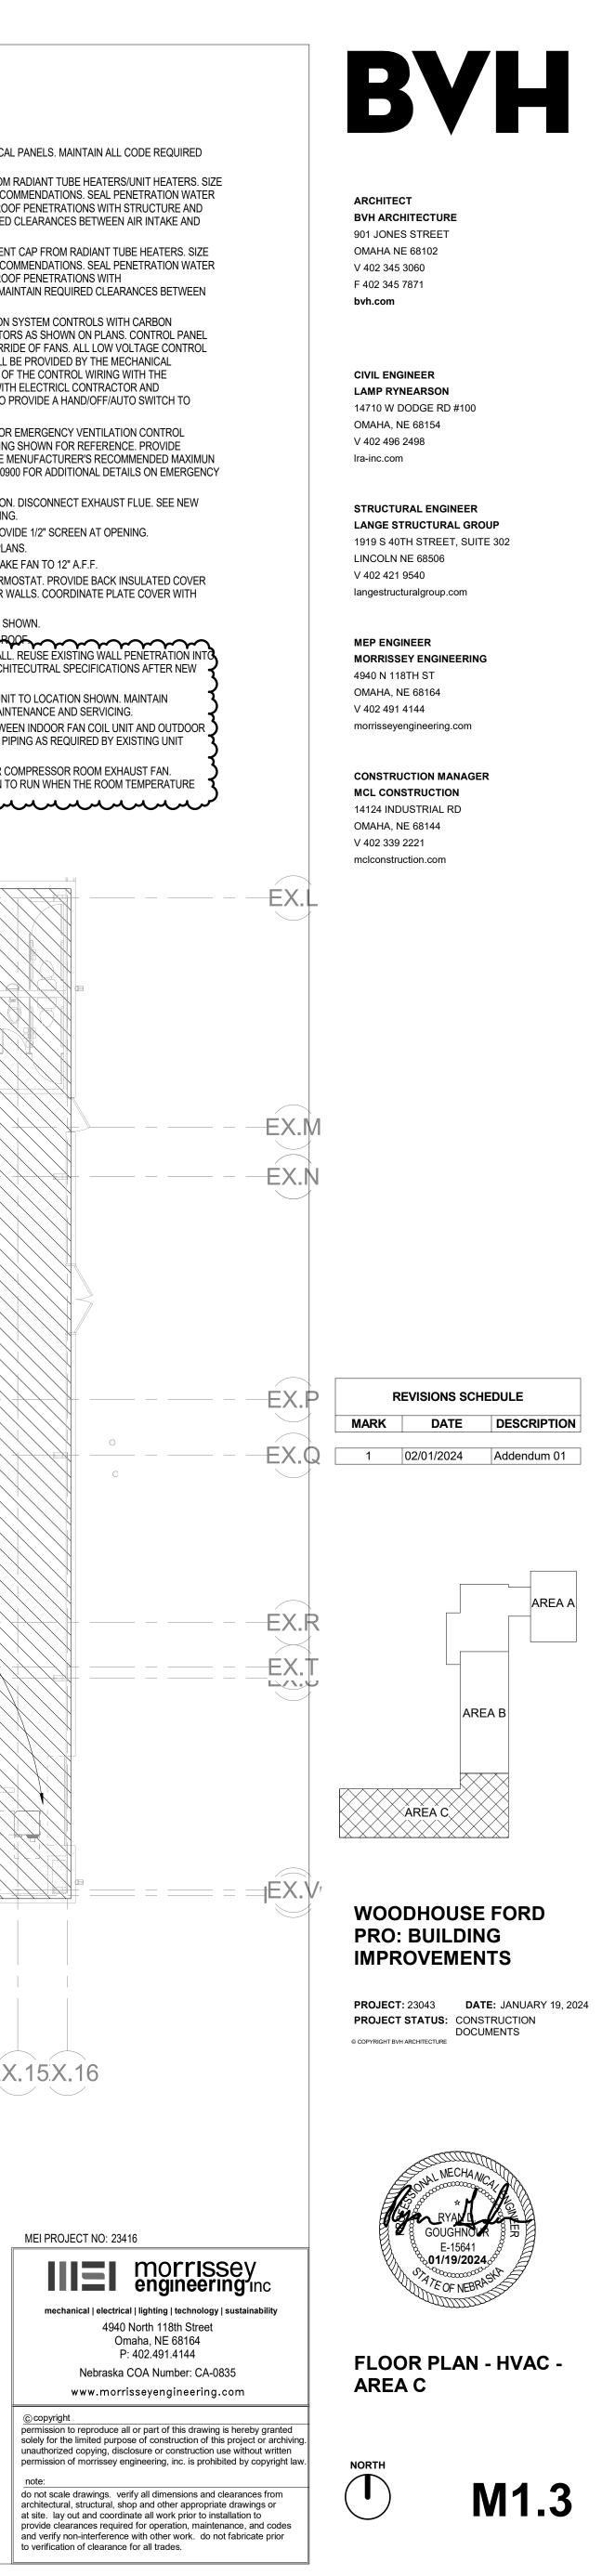

KEYN	
M101	DO NOT ROUTE DUCTWORK OVER ELECTRICAL PANELS. MAINTAIN ALL CODE REQUIRED CLEARANCES.
M105	FLUE UP THROUGH ROOF TO VENT CAP FROM RADIANT TUBE HEATERS/UNIT HEATERS. SIZE AND TERMINATE PER MANUFACTURER'S RECOMMENDATIONS. SEAL PENETRATION WATER TIGHT. COORDINATE EXACT LOCATION OF ROOF PENETRATIONS WITH STRUCTURE AND GENERAL CONTRACTOR. MAINTAIN REQUIRED CLEARANCES BETWEEN AIR INTAKE AND EXHAUST.
M106	COMBUSTION AIR UP THROUGH ROOF TO VENT CAP FROM RADIANT TUBE HEATERS. SIZE AND TERMINATE PER MANUFACTURER'S RECOMMENDATIONS. SEAL PENETRATION WATER TIGHT. COORDINATE EXACT LOCATION OF ROOF PENETRATIONS WITH STRUCTURE AND GENERAL CONTRACTOR. MAINTAIN REQUIRED CLEARANCES BETWEEN COMBUSTION AIR INTAKE AND EXHAUST.
M108	LOCAL CONTROL PANEL FOR GAS DETECTION SYSTEM CONTROLS WITH CARBON MONOXIDE AND NITROGEN DIOXIDE DETECTORS AS SHOWN ON PLANS. CONTROL PANEL SHALL HAVE CAPABILITY FOR MANUAL OVERRIDE OF FANS. ALL LOW VOLTAGE CONTROL WIRING GOR GAS DETECTION SYSTEM SHALL BE PROVIDED BY THE MECHANICAL CONTRACTOR. COORDINATE INSTALLATION OF THE CONTROL WIRING WITH THE ELECTRICAL CONTRACTOR. COORDINATE WITH ELECTRICL CONTRACTOR AND TEMPERATURE CONTROLS CONTRACTOR TO PROVIDE A HAND/OFF/AUTO SWITCH TO CONTROL SUPPLY AND EXHAUST FANS.
M111	CO SENSOR AND NO2 SENSOR AT 48" AFF FOR EMERGENCY VENTILATION CONTROL SYSTEM. PREFERRED LOCATION AND SPACING SHOWN FOR REFERENCE. PROVIDE ADDITIONAL SENSORS AS REQUIRED BY THE MENUFACTURER'S RECOMMENDED MAXIMUN SAPCING. SEE SPECIFICATIONS SECTION 230900 FOR ADDITIONAL DETAILS ON EMERGENCY VENTILATION SYSTEM.
M112	SALVAGE GAS UNIT HEATER FOR RELOCATION. DISCONNECT EXHAUST FLUE. SEE NEW PLANS FOR CONNECTION TO NEW FLUE PIPING.
M116	STUB DUCT 12" BELOW ROOF DECK AND PROVIDE 1/2" SCREEN AT OPENING.
M118	ELECTRIC UNIT HEATER. SEE ELECTRICAL PLANS.
M123	ROUTE SUPPY DUCTWORK FROM HOOD INTAKE FAN TO 12" A.F.F.
M124	PROVIDE NEW 7-DAY PROGRAMMABLE THERMOSTAT. PROVIDE BACK INSULATED COVER FOR THERMOSTATS LOCATED ON EXTERIOR WALLS. COORDINATE PLATE COVER WITH ARCHITECT AND OWNER.
M125	RELOCATE GAS UNIT HEATER TO LOCATION SHOWN.
M145	
M146	ROUTE REFRIGERANT PIPING UP ALONG WALL. REUSE EXISTING WALL PENETRATION INTO BUILDING. SEAL AROUND OPENING PER ARCHITECUTRAL SPECIFICATIONS AFTER NEW REFRIGERANT PIPING IS INSTALLED.
M147	RELOCATE EXISTING SALVAGED FAN COIL UNIT TO LOCATION SHOWN. MAINTAIN CLEARANCE ON EACH SIDE OF UNIT FOR MAINTENANCE AND SERVICING.
M148	PROVIDE NEW REFRIGERANT LINE SET BETWEEN INDOOR FAN COIL UNIT AND OUTDOOR CONDENSING UNIT. CHARGE REFRIGERANT PIPING AS REQUIRED BY EXISTING UNIT MANUFACTURER.
M149	PROVIDE COOLING ONLY THERMOSTAT FOR COMPRESSOR ROOM EXHAUST FAN.

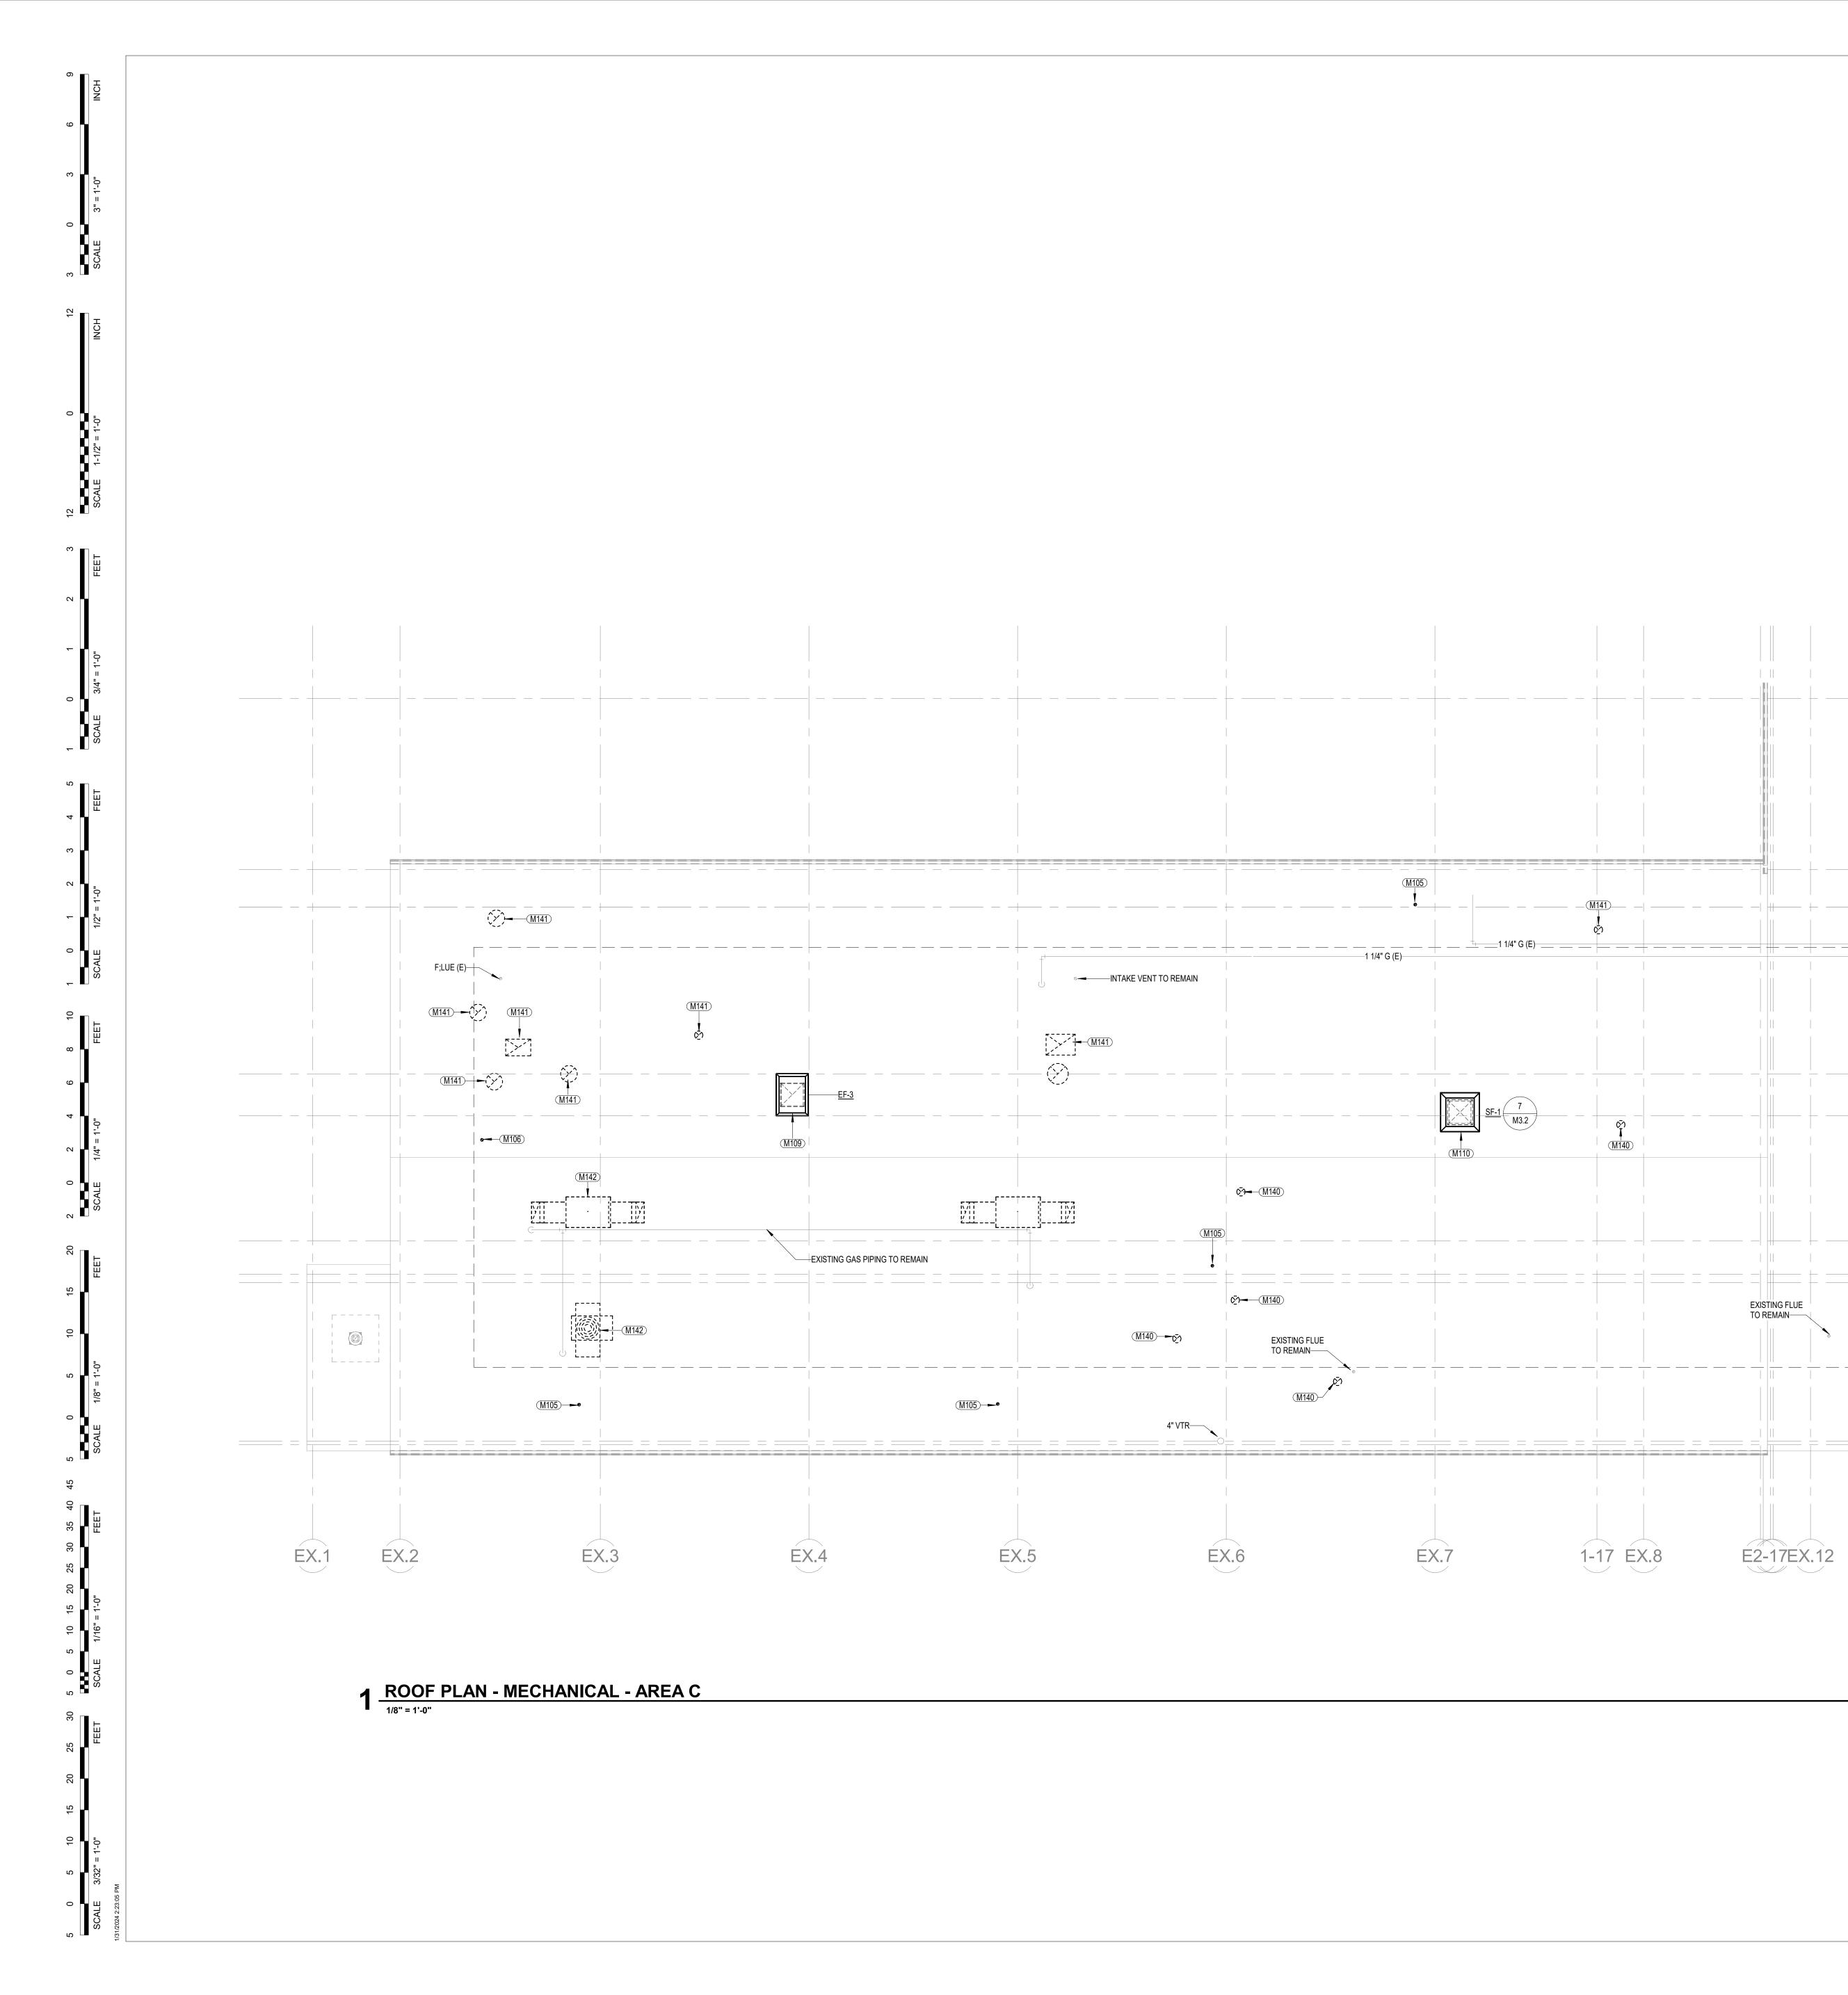

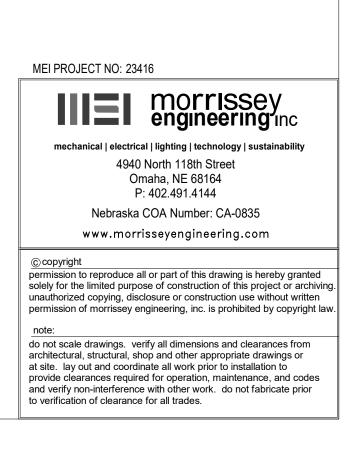

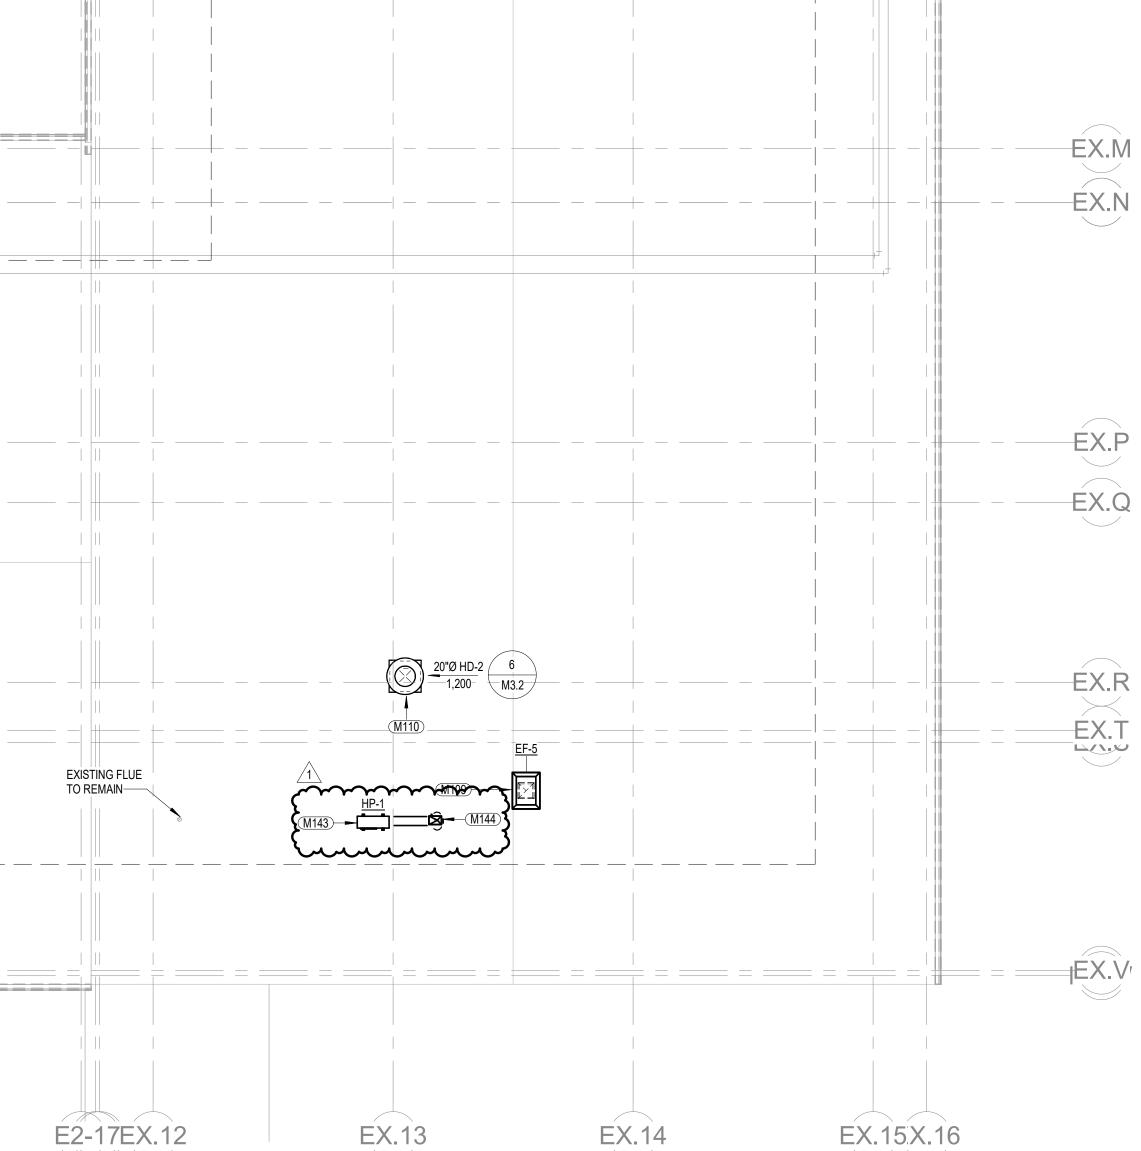

KEYNO	<u>TES</u>
M105	FLUE UP THROUGH ROOF TO VENT CAP FROM RADIANT TUBE HEATERS/UNIT HEATERS. SIZE AND TERMINATE PER MANUFACTURER'S RECOMMENDATIONS. SEAL PENETRATION WATER TIGHT. COORDINATE EXACT LOCATION OF ROOF PENETRATIONS WITH STRUCTURE AND GENERAL CONTRACTOR. MAINTAIN REQUIRED CLEARANCES BETWEEN AIR INTAKE AND EXHAUST.
M106	COMBUSTION AIR UP THROUGH ROOF TO VENT CAP FROM RADIANT TUBE HEATERS. SIZE AND TERMINATE PER MANUFACTURER'S RECOMMENDATIONS. SEAL PENETRATION WATER TIGHT. COORDINATE EXACT LOCATION OF ROOF PENETRATIONS WITH STRUCTURE AND GENERAL CONTRACTOR. MAINTAIN REQUIRED CLEARANCES BETWEEN COMBUSTION AIR INTAKE AND EXHAUST.
M109	INSTALL ROOF EXHAUST PER MANUFACTURER'S RECOMMENDATIONS. MINIMUM 10'-0" CLEARANCE REQUIRED BETWEEN ANY POINT OF BUILDING EXHAUST AND BUILDING AIR INTAKE. COORDINATE EXACT LOCATION OF ROOF PENETRATION WITH STRUCTURE AND GENERAL CONTRACTOR.
M110	INSTALL ROOF INTAKE HOOD PER MANUFACTURER'S RECOMMENDATIONS. COORDINATE EXACT LOCATION OF ROOF PENETRATION WITH STRUCTURE AND GENERAL CONTRACTOR.
M140	DEMO EXHAUST FLUE AND REPAIR ROOF OPENING. COORDINATE ROOF REPAIR WITH ARCHITECTURAL.
M141	REMOVE SPRAY BOOTH EXHAUST AND INTAKE DUCTWORK ON ROOF COMPLETE. COORDINATE ROOF REPAIRS WITH ARCHITECT.
M142	REMOVE ROOFTOP EQUIPMENT AND DUCTWORK SHOWN DASHED.
M 143	SET AIR COOLED CONDENSING UNIT ON ROOF ON DURABLOCK (OR EQUIVALENT) ROOF SUPPORTS. LOCATE UNIT TO MAINTAIN ALL MANUFACTURER'S RECOMMENDED CLEARANCES. ROUTE REFRIGERANT PIPING ON PIPE STANDS ON ROOF TO REFRIGERANT ROOF PENETRATION.
М 144	ROUTE REFRIGERANT PIPING DOWN THROUGH ROOF. PROVIDE PENETRATION BOOT COMPLIANT WITH ROOFING MANUFACTURER'S WARRANTY. SIZE REFRIGERANT PIPING PER MANUFACTURER'S RECOMMENDATIONS.



ARCHITECT **BVH ARCHITECTURE** 901 JONES STREET OMAHA NE 68102 V 402 345 3060 F 402 345 7871 bvh.com


CIVIL ENGINEER LAMP RYNEARSON 14710 W DODGE RD #100 OMAHA, NE 68154 V 402 496 2498 Ira-inc.com


STRUCTURAL ENGINEER LANGE STRUCTURAL GROUP 1919 S 40TH STREET, SUITE 302 LINCOLN NE 68506 V 402 421 9540 langestructuralgroup.com

MEP ENGINEER MORRISSEY ENGINEERING 4940 N 118TH ST OMAHA, NE 68164 V 402 491 4144 morrisseyengineering.com

CONSTRUCTION MANAGER MCL CONSTRUCTION 14124 INDUSTRIAL RD OMAHA, NE 68144 V 402 339 2221 mclconstruction.com

-ÉX.L

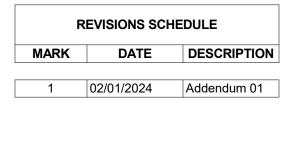

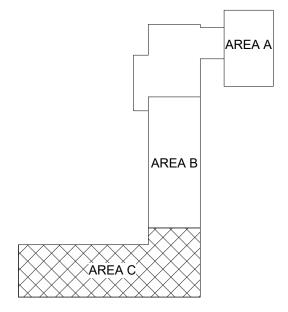


WOODHOUSE FORD PRO: BUILDING IMPROVEMENTS


PROJECT: 23043 **DATE:** JANUARY 19, 2024 PROJECT STATUS: CONSTRUCTION DOCUMENTS © COPYRIGHT BVH ARCHITECTURE







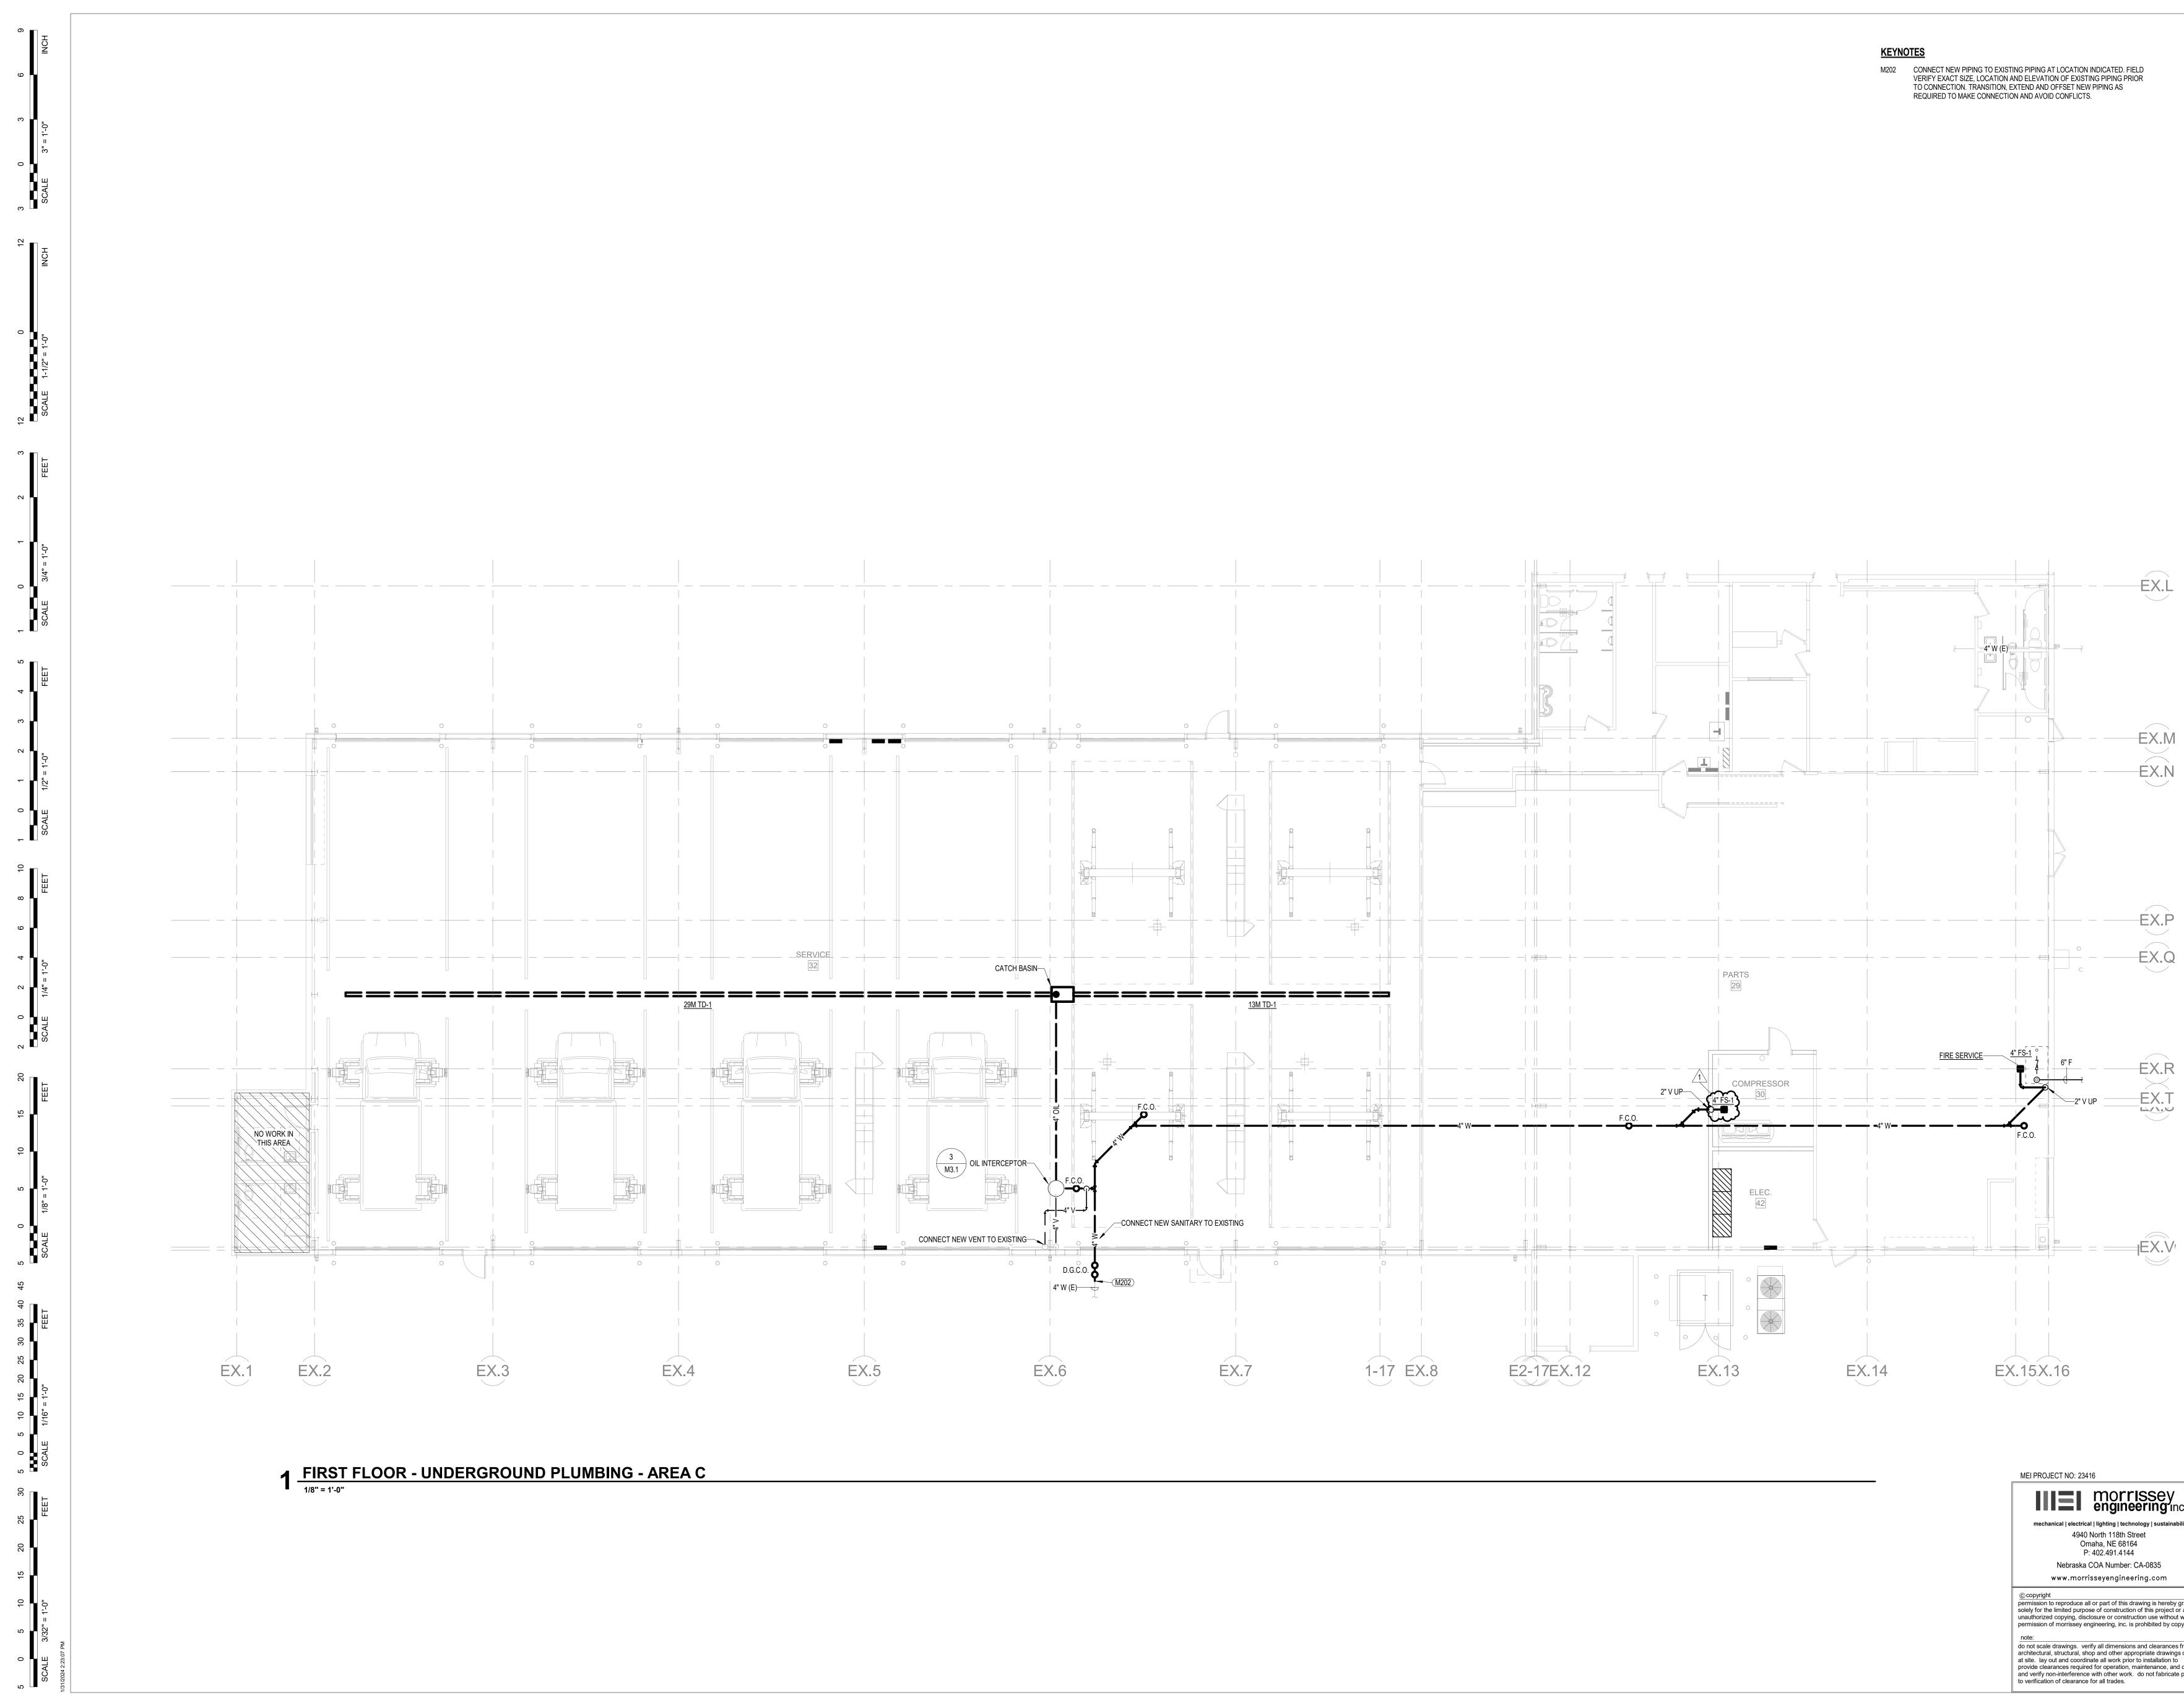

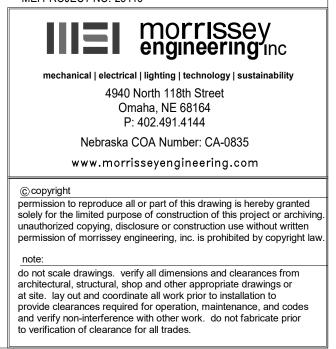





CIVIL ENGINEER LAMP RYNEARSON 14710 W DODGE RD #100 OMAHA, NE 68154 V 402 496 2498 Ira-inc.com

STRUCTURAL ENGINEER LANGE STRUCTURAL GROUP 1919 S 40TH STREET, SUITE 302 LINCOLN NE 68506 V 402 421 9540 langestructuralgroup.com

MEP ENGINEER MORRISSEY ENGINEERING 4940 N 118TH ST OMAHA, NE 68164 V 402 491 4144 morrisseyengineering.com

CONSTRUCTION MANAGER MCL CONSTRUCTION 14124 INDUSTRIAL RD OMAHA, NE 68144 V 402 339 2221 mclconstruction.com

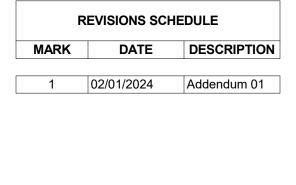

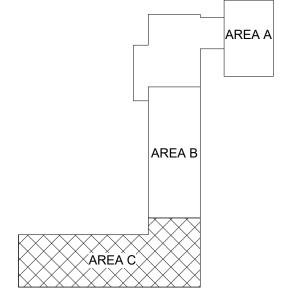


WOODHOUSE FORD PRO: BUILDING IMPROVEMENTS


PROJECT: 23043 **DATE:** JANUARY 19, 2024 PROJECT STATUS: CONSTRUCTION DOCUMENTS © COPYRIGHT BYH ARCHITECTURE








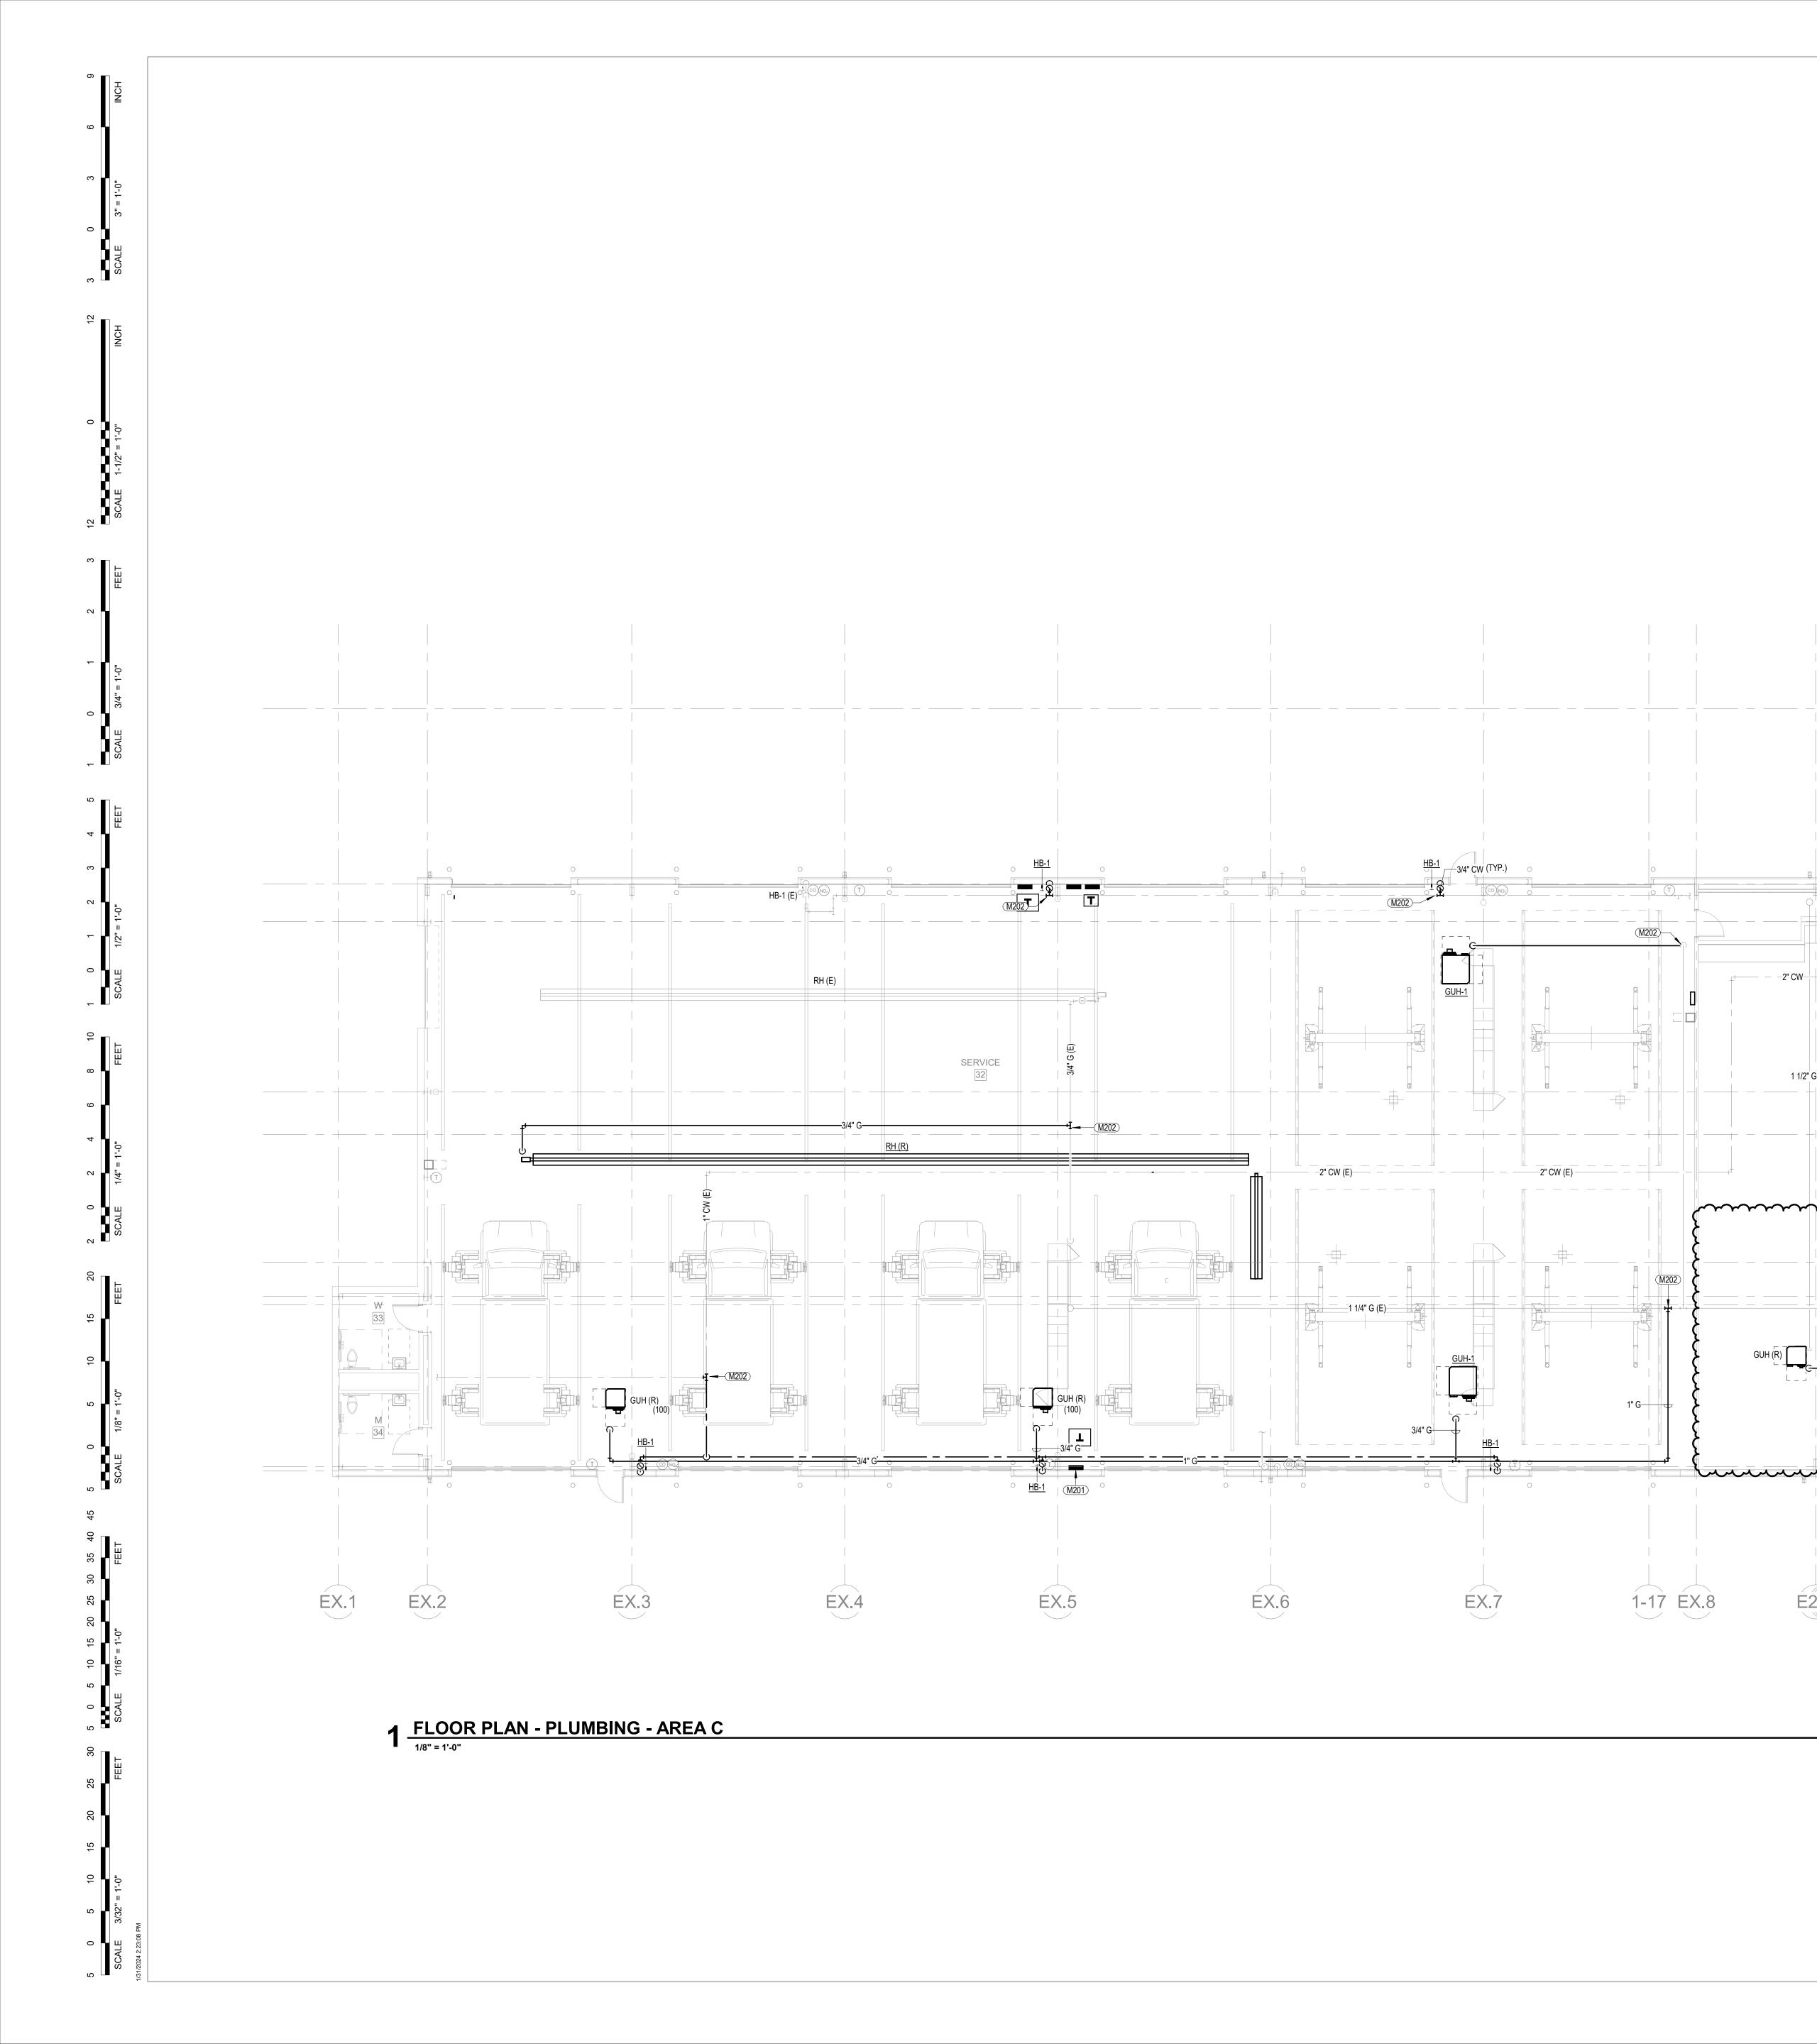

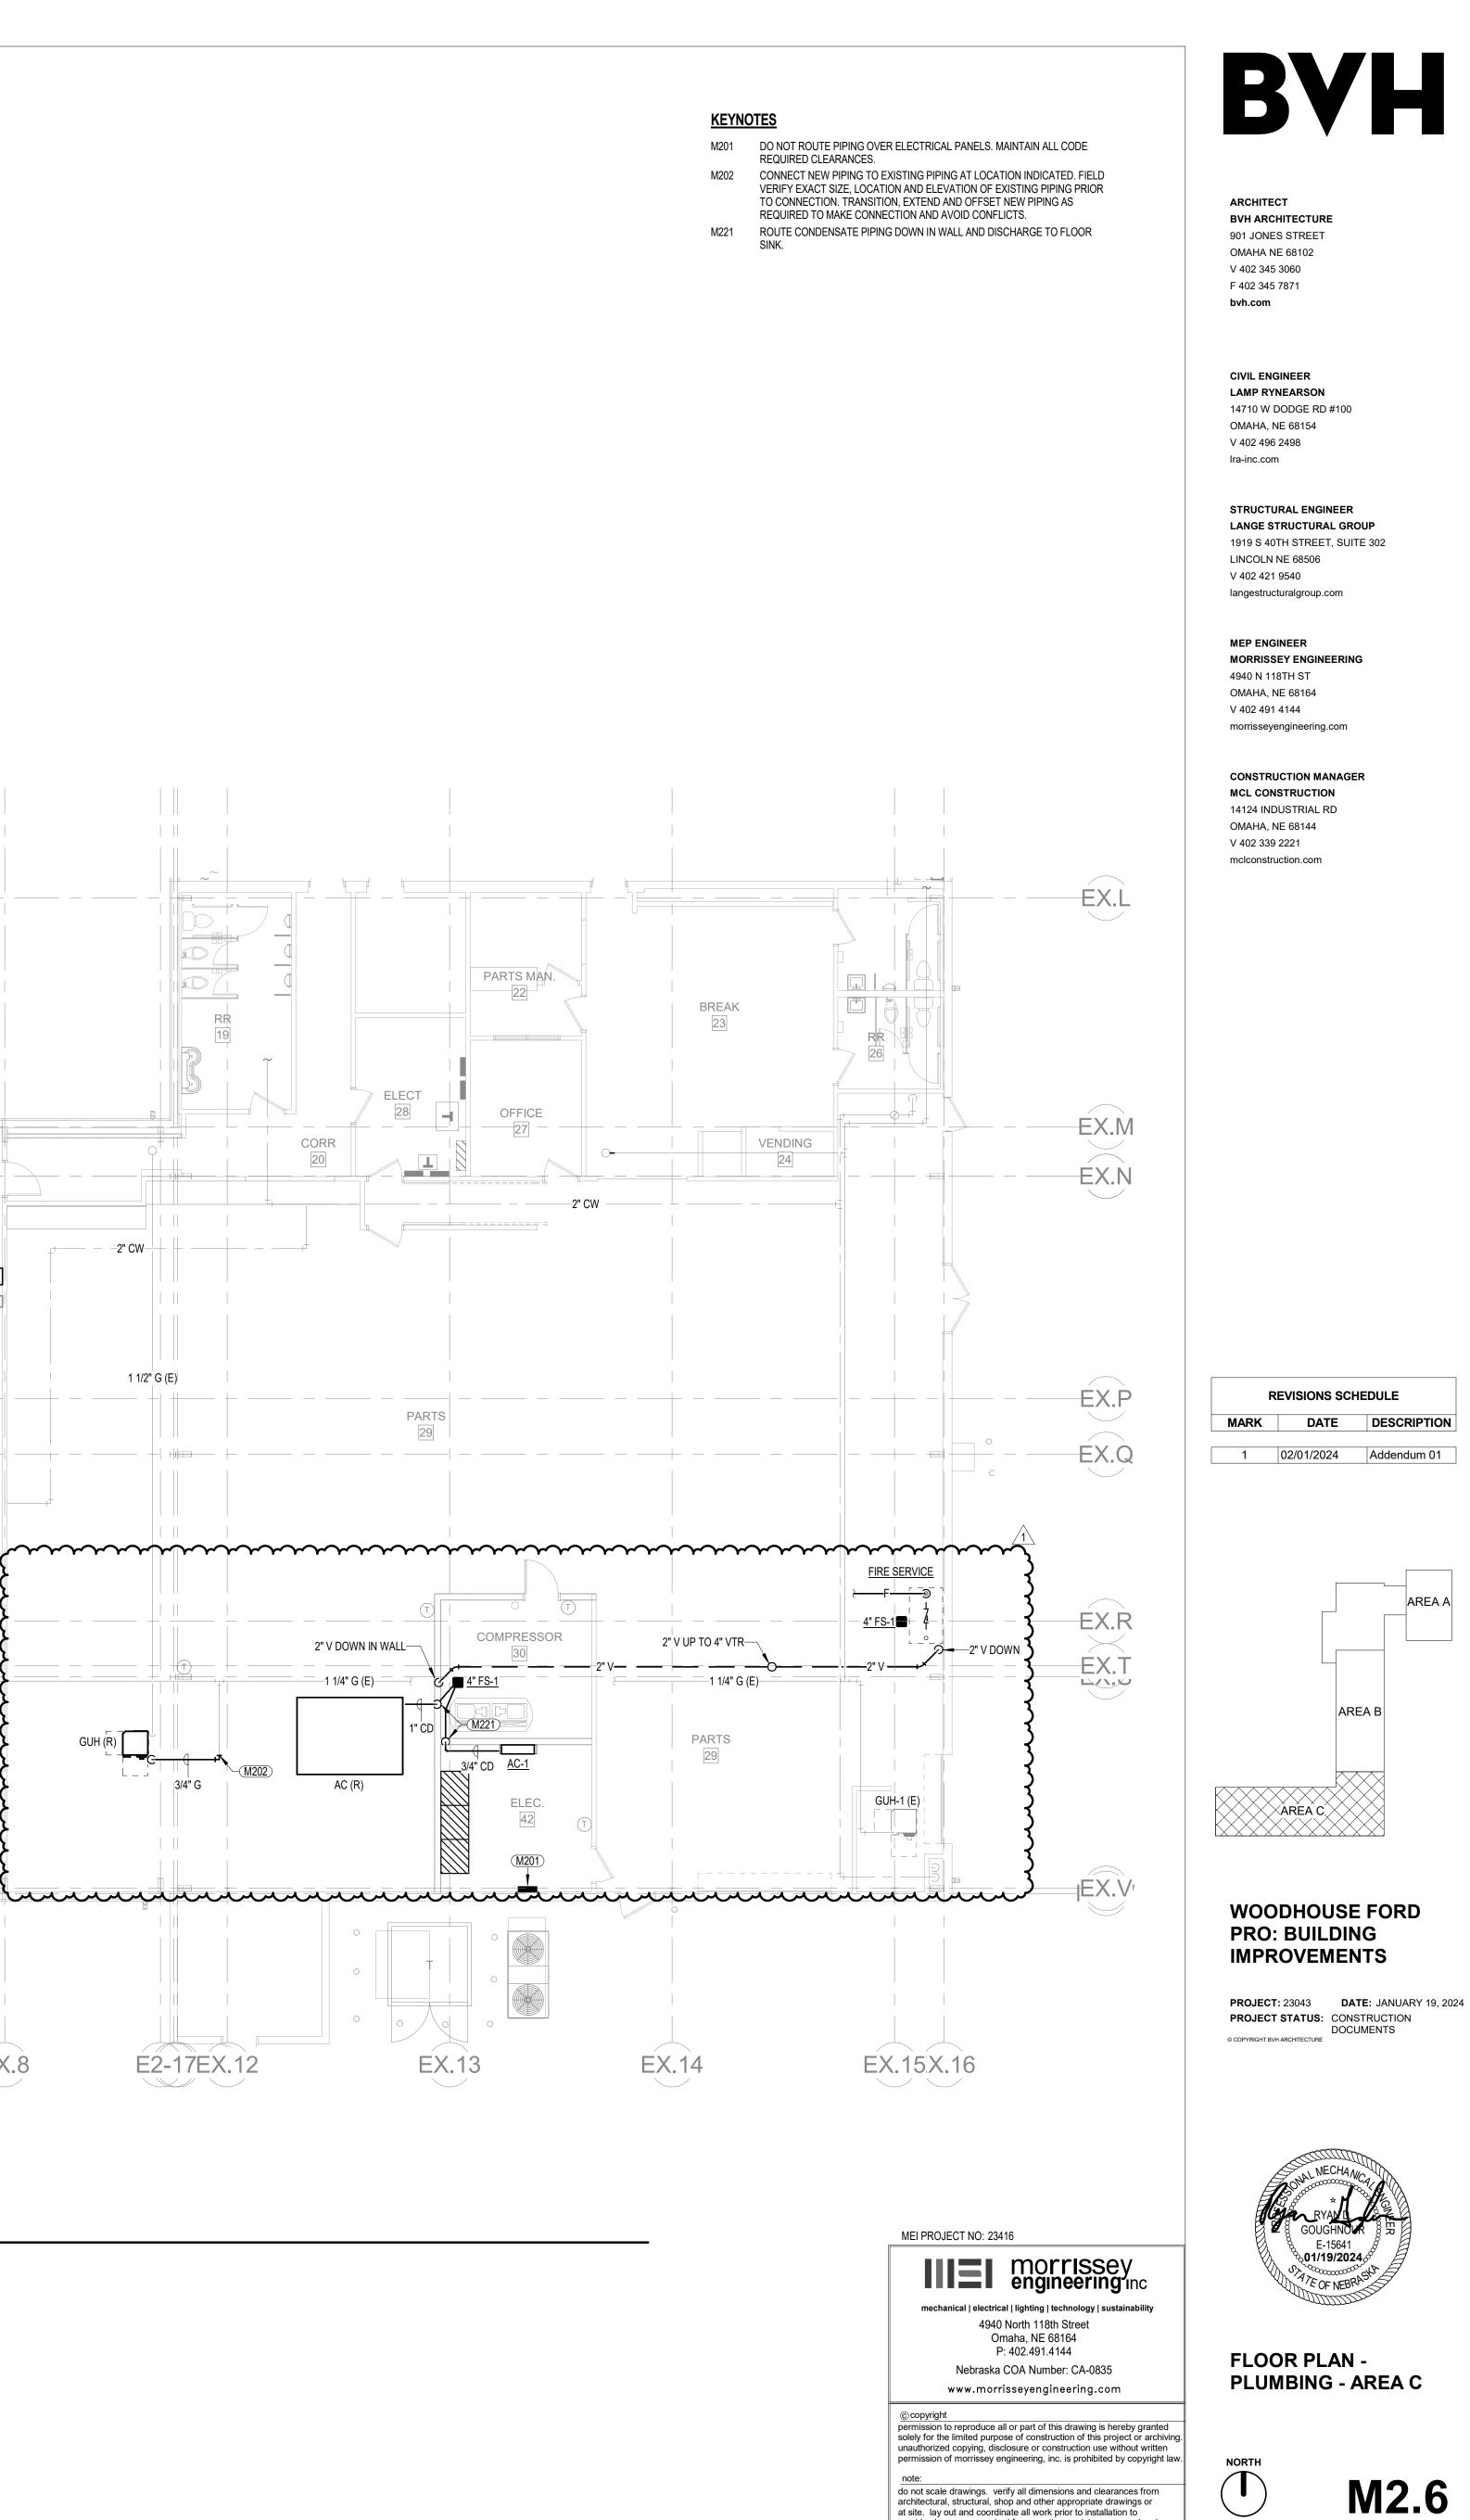

at site. lay out and coordinate all work prior to installation to provide clearances required for operation, maintenance, and codes and verify non-interference with other work. do not fabricate prior to verification of clearance for all trades.

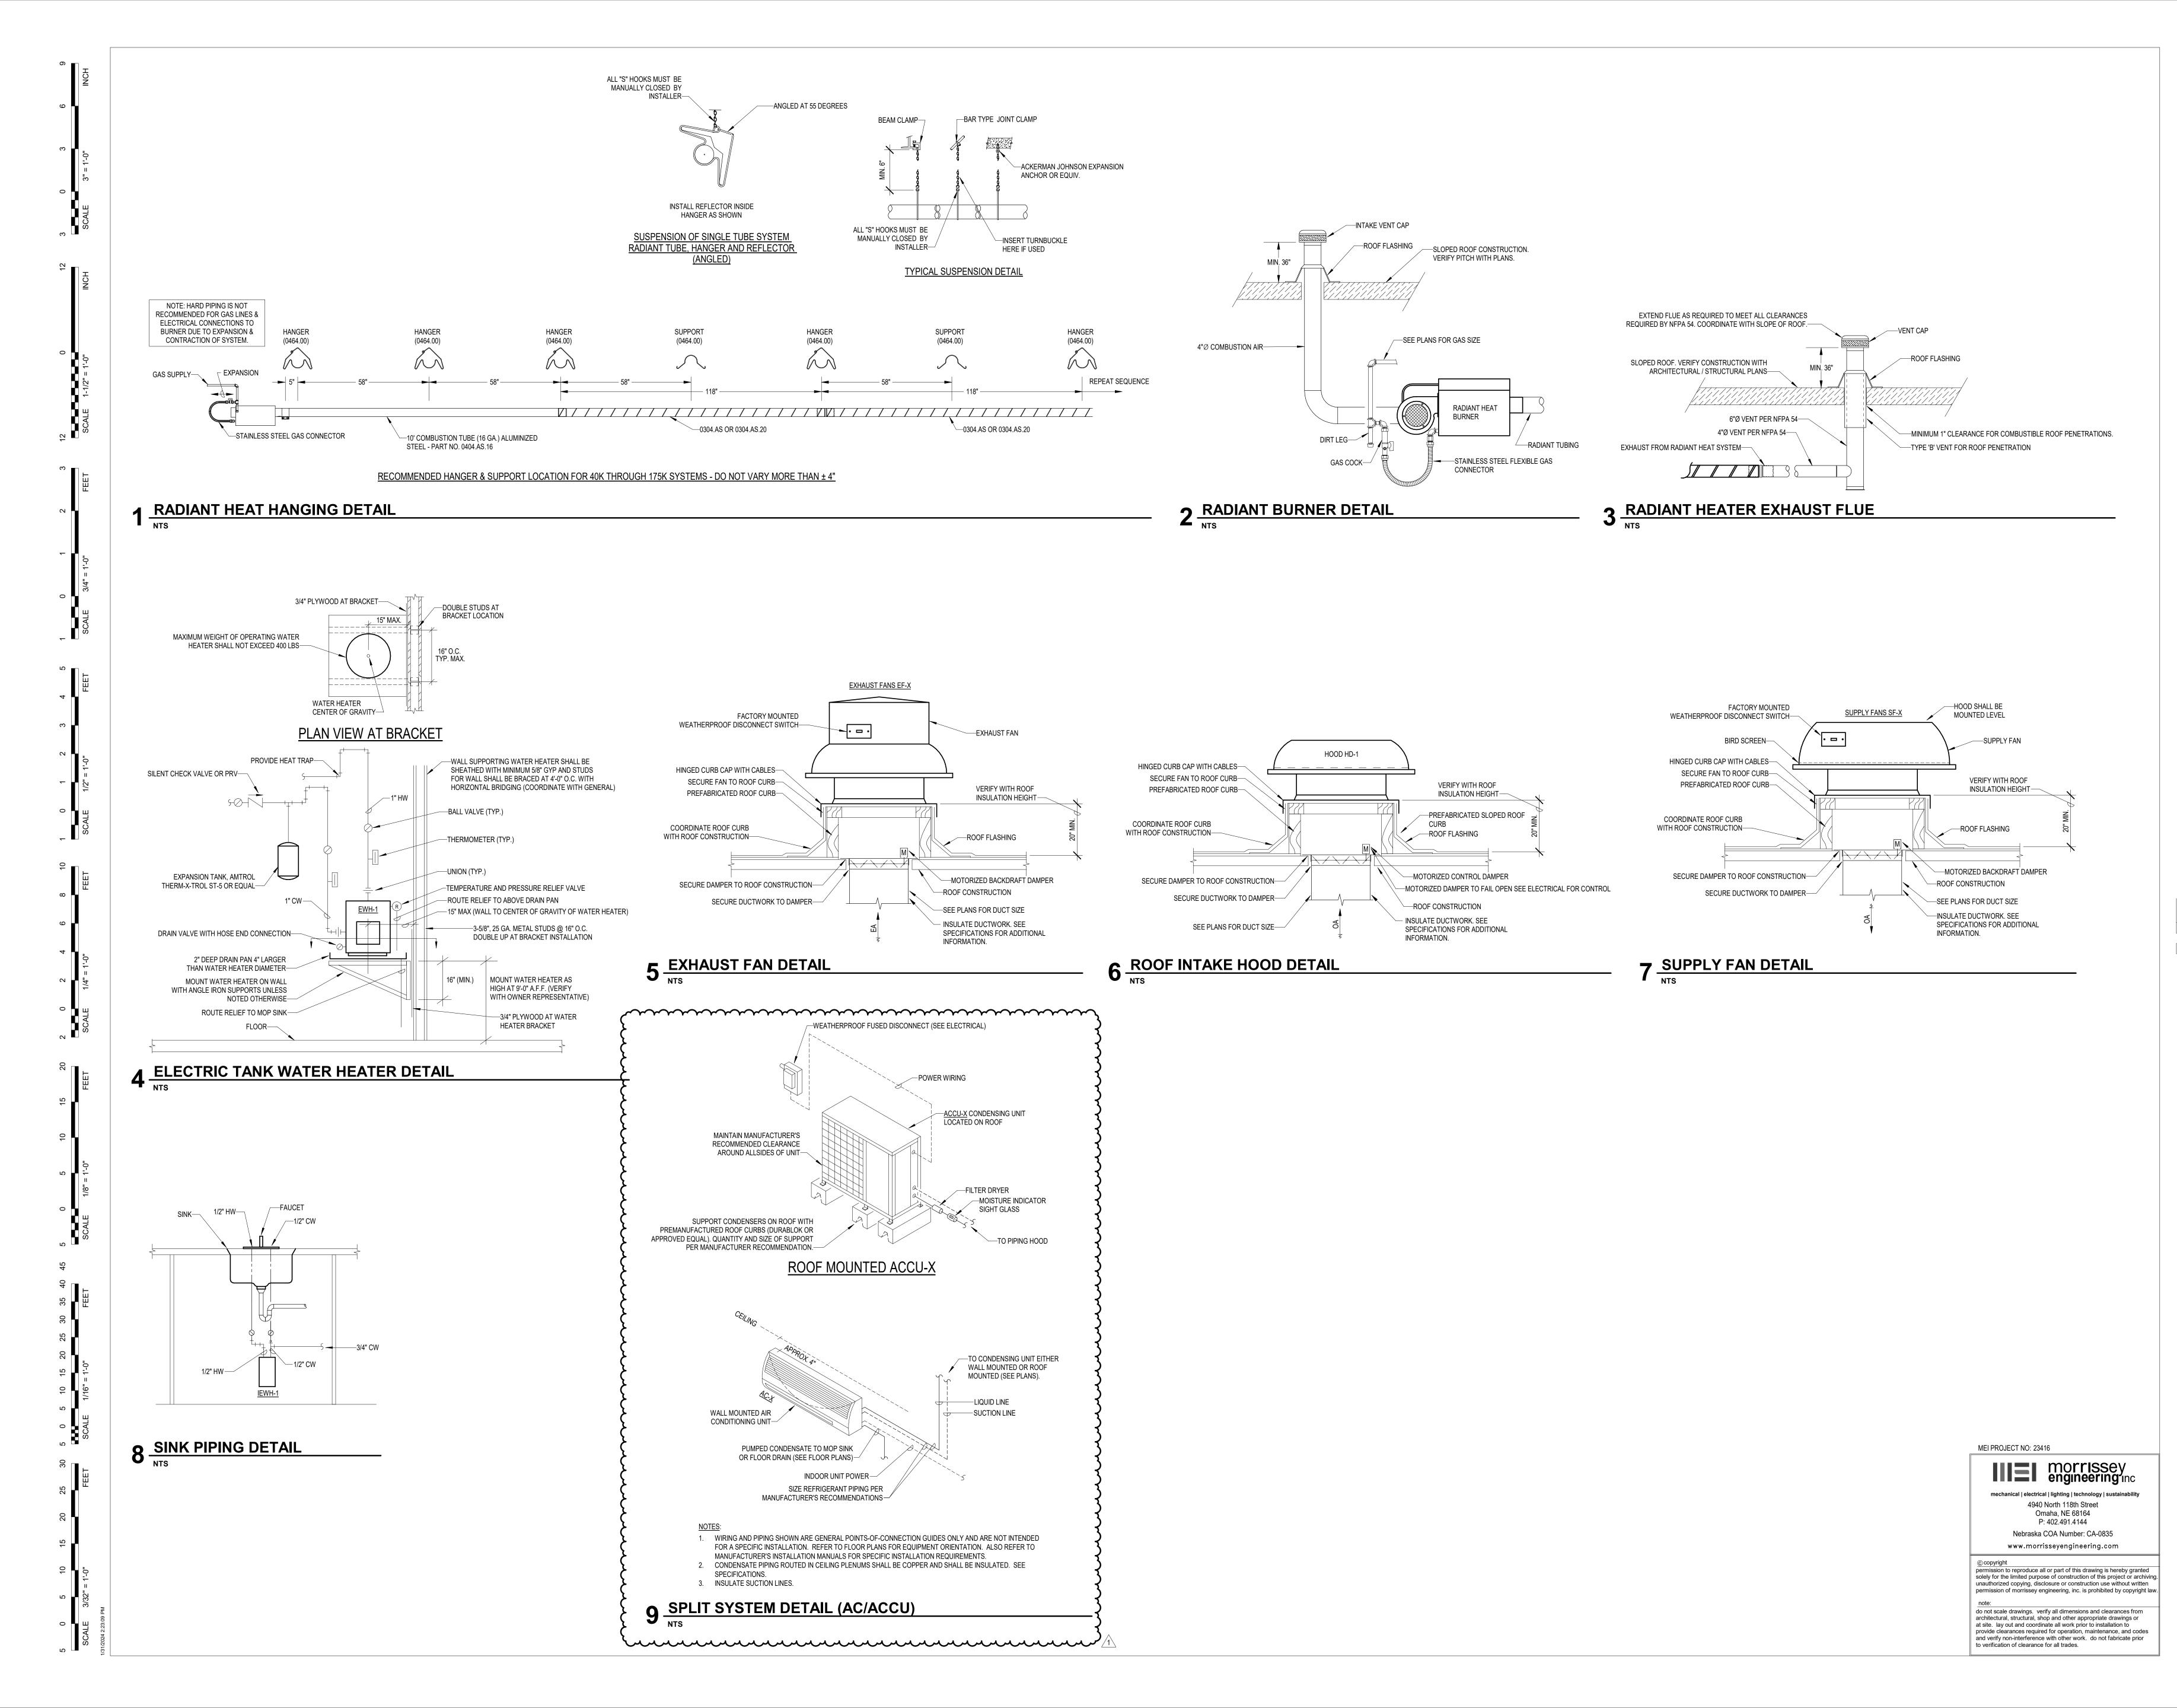




CIVIL ENGINEER LAMP RYNEARSON 14710 W DODGE RD #100 OMAHA, NE 68154 V 402 496 2498 Ira-inc.com

STRUCTURAL ENGINEER LANGE STRUCTURAL GROUP 1919 S 40TH STREET, SUITE 302 LINCOLN NE 68506 V 402 421 9540 langestructuralgroup.com

MEP ENGINEER MORRISSEY ENGINEERING 4940 N 118TH ST OMAHA, NE 68164 V 402 491 4144 morrisseyengineering.com

CONSTRUCTION MANAGER MCL CONSTRUCTION 14124 INDUSTRIAL RD OMAHA, NE 68144 V 402 339 2221 mclconstruction.com

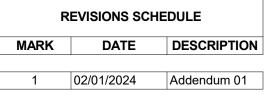



 PROJECT: 23043
 DATE: JANUARY 19, 2024

 PROJECT STATUS:
 CONSTRUCTION DOCUMENTS


 © COPYRIGHT BVH ARCHITECTURE
 CONSTRUCTION DOCUMENTS








0 3 6 9 3" = 1'-0" INCH				1 2 3 4 5	2. PROVIDE WITH 3. Electrical [4. Single Elect 5. See plans fo	I PRESSURE / TEMPERA DISCONNECT BY ELECTF RIC HEATING ELEMENT DR FIXTURES SERVED.	RICAL CONTRACTOR. SEE EL
3 SCALE				9). ELECTRICAL [10. PROVIDE WI]	NSCONNECT BY ELECT H THERMOSTATIC CON H 0.2 GPM TURN ON FLO	RICAL CONTRACTOR. SEE ELI TROLS.
12 NCH				-	PLAN TAG EWH-1 IEWH-1	GENERAL MANUFACTURER A.O. SMITH EEMAX	MODEL SERVES DEL-20 DOM. HW SPEX80T (5)
Ξ				L			
. 1-0							
E 1-1/2" =						SERVICE SUPPLY AIR	DUCTWORK ROUND
12 SCALE						SUPPLY AIR SUPPLY AIR RETURN AIR	RECTANGULAR ROUND RECTANGULAR
β FEET						OUTSIDE AIR EXHAUST AIR	FROM FAN / HOOD FROM FAN / HOOD
7						SEE SPECIFI	TYPE AND THICKNESS SHAL CATION SECTION 23 07 00 FO PERFORATED SHEET META JCTWORK SHALL BE PRIMEE
0 LE 3/4" =							SERVICE
1 SCALE						DOMESTIC HC	TIC COLD WATER (CW) T WATER (WITHOUT RECIRC
FEET 5						REF RE	VENTS (24" BELOW ROOF) RIGERANT SUCTION FRIGERANT LIQUID
ę						REMARKS: 1. SEE PIPING INS 2. INSULATION TY	PE AND THICKNESS SHALL
1 2 2" = 1'-0"						3. SEE SPECIFICA	TION SECTIONS 22 07 20 & 2.
0 1 SCALE 1/2"							
- 1 10 20 20 20 20 20 20 20 20 20 20 20 20 20							
8 FEET							
С							
2 4 1/4" = 1'-0"							
0 SCALE							
15 20 FEET							
6							
5 1/8" = 1'-0"							
0 SCALE							
45							
30 35 40 FEET							
20 25							
10 15 1/16" = 1'-0"							REMARKS: 1. HIGH-WALL D 2. PROVIDE WIT 3. CONDENSING
5 0 5 SCALE							5. PROVIDE COL 6. PROVIDE COL
30 EET							7. ELECTRICAL 8. SUBJECT TO
20 25 F							K INDOOR PLAN TAG AC-1
15							·····
5 10 3/32" = 1'-0"							
5 0 SCALE (1/31/2024 2:23:12 PM							
1/3							

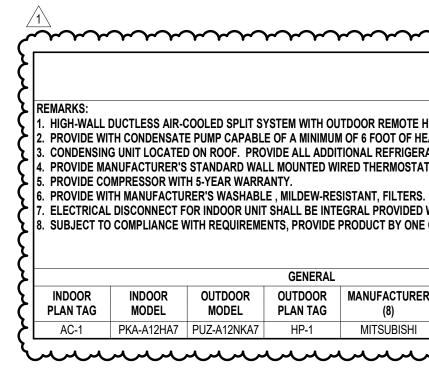

SUPPLY AIR RECTANGULA SUPPLY AIR ROUND **RETURN AIR** RECTANGULA FROM FAN / HO OUTSIDE AIR FROM FAN / HO EXHAUST AIR REMARKS: 1. INSULATION TYPE AND THICKNESS SHALL MEET ALL REQUIREMENTS OF 2018 IECC. 2. SEE SPECIFICATION SECTION 23 07 00 FOR ADDITIONAL INFORMATION. 3. INNER DUCT PERFORATED SHEET METAL WITH 1" INTERSTITIAL INSULATION AND OUTER DUCT SPIRAL DUCT MATCHING DUCT PRESSURE CLASS. 4. EXPOSED DUCTWORK SHALL BE PRIMED FOR FIELD PAINTING. PIPING INSULATION SCHEDULE (1) (2) (3) SERVICE

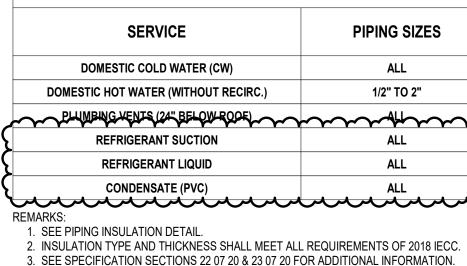

ELECTRIC WATER HEATER SCHEDULE

DISCONNECT BY ELECTRICAL CONTRACTOR. SEE ELECTRICAL DRAWINGS. COORDINATE ELECTRICAL REQUIREMENTS WITH SUPPLIED UNIT AND WITH ELECTRICAL CONTRACTOR.

DUS (TANKLESS) POINT OF USE ELECTRIC WATER HEATER.

DISCONNECT BY ELECTRICAL CONTRACTOR. SEE ELECTRICAL DRAWINGS. COORDINATE ELECTRICAL REQUIREMENTS WITH SUPPLIED UNIT AND WITH ELECTRICAL CONTRACTOR.

 GENERAL			-	TANK	DOME	STIC HOT WATE	R	ELECTR	CAL		ELECTR	IC HEAT		
MANUFACTURER	MODEL	SERVES	STORAGE CAPACITY	DIMENSIONS (DIA. Ø x H)	RECOVERY	DISCHARGE TEMP.	TEMP. RISE	VOLTAGE / PHASE	FLA	CAPACITY (kW)	kW / STAGE	# OF ELEMENTS	# OF STAGES	REMARKS
A.O. SMITH	DEL-20	DOM. HW	20	22"Ø x 23"	15 GPH	120 °F	80 °F	277 V / 1	10.8 A	3.0 kW	3.0 kW	1	1	(1) (2) (3) (4)
EEMAX	SPEX80T	(5)	-	-	(6)	103 °F	55 °F	277 V / 1	28.9 A	8.0 kW	8.0 kW	1	1	(7) (8) (9) (10) (11)

DUCTWORK INSULATION SCHEDULE (1) (2)

DUCTWORK	APPLICATION	INSULATION TYPE	INSULATION THICKNESS	MINIMUM R-VALUE	VAPOR RETARDER	REMARKS
ROUND	ABOVE CEILING	MINERAL FIBER BLANKET	2-3/16"	R-6	YES	-
RECTANGULAR	ALL	DUCT LINER	1-1/2"	R-6	YES	-
ROUND	EXPOSED DOUBLE WALL SPIRAL	DUCT LINER	1"	R-3	YES	(3) (4)
RECTANGULAR	RTU DUCT DROP	DUCT LINER	1-1/2"	R-6	YES	-
FROM FAN / HOOD	BACK 36" INTO BUILDING	MINERAL FIBER BLANKET	2-3/16"	R-6	YES	-
FROM FAN / HOOD	BACK 36" INTO BUILDING	MINERAL FIBER BLANKET	2-3/16"	R-6	YES	-

	PIPING SIZES	INSULATION TYPE	INSULATION THICKNESS	VAPOR RETARDER	REMARKS
)	ALL	MINERAL FIBER	1/2"	YES	-
ECIRC.)	1/2" TO 2"	MINERAL FIBER	1/2"	NO	-
		MINERALEUBER	~~~ ^{1/2} ~~~~	~~~~~¥E\$~~~~~	\sim
	ALL	MINERAL FIBER	1/2"	YES	-
	ALL	NONE	-	-	-
	ALL	NONE	-	-	-

3. SEE SPECIFICATION SECTIONS 22 07 20 & 23 07 20 FOR ADDITIONAL INFORMATION.

NATURAL	GAS USA	GE TABLE
METER	PLAN TAG	GAS LOAD (BTU/h)
#1	RTU-5T (E)	150,000
#1	RH-1	100,000
#1	RH-1	100,000
#1	GUH (E)	100,000
#1	RH-1	100,000
#1	RH-1	100,000
#1	GUH-1 (E)	60,000
#1	RH (E)	150,000
#1	GUH (R)	100,000
#1	GUH (R)	100,000
#1	GUH-1	150,000
#1	RH (R)	150,000
#1	GUH (R)	100,000
#1	GUH (R)	100,000
#1	GUH (R)	150,000
#1	GUH (R)	150,000
#1	GUH-1	150,000
#1	GUH (R)	100,000
#1	GUH (R)	100,000
#1	GUH-1	150,000
#1	RTU-10T (E)	200,000
#1	RTU-7.5T (E)	200,000
#1	(R)	30,000
Grand total: 23		2,790,000

2. PROVIDE WITH ROOF SLOPE SO 3. CONTROLLED 4. FANS SHALL B 5. CONTROLLED 6. ROOF MOUNTE	D, DIRECT DRIVE, CEI 18" INSULATED ROOF THAT THE FANS SIT LI BY TIMECLOCK. FAN S E STARTED AUTOMAT BY COOLING ONLY TH D, BELT DRIVE, CENT D, HOODED PROPELL	CURB COMPA EVEL AND PLU SHALL RUN DU ICALLY BY RE IERMOSTAT. S RIFUGAL DOW
		(
PLAN TAG	MANUFACTURER	MODEL
PLAN TAG EF-1	MANUFACTURER GREENHECK	
		MODEL
EF-1	GREENHECK	MODEL G-180-VG
EF-1 EF-2	GREENHECK GREENHECK	MODEL G-180-VG GB-300
EF-1 EF-2 EF-3	GREENHECK GREENHECK GREENHECK	MODEL G-180-VG GB-300 GB-300
EF-1 EF-2 EF-3 EF-4	GREENHECK GREENHECK GREENHECK GREENHECK	MODEL G-180-VG GB-300 GB-300 G-097-VG

1. GAS FIRED, POWER-VENTED, LOW-STATIC, AXIAL FAN UNIT HEATER. 2. PROVIDE WITH DISCHARGE LOUVERS, FAN GUARDS, AND FACTORY MOUNT DISCONNECT SWITCH. 3. PROVIDE WITH FLUE EXHAUST PIPE AND ROOF TERMINATION. SIZE PER MANUFACTURER'S RECOMMENDATIONS. 5. STANDARD COLOR SELECTED BY ARCHITECT

		GENERA	L			PHYSICAL SIZE		FAN		N	IOTOR		ELEC	TRICAL	-			GAS	FIRED HEATIN	NG				REMARKS
PLAN TA	MANUFACTURER	MODEL	SERVES	FINISH	CONFIG.	WEIGHT	QTY.	AIRFLOW	HP	RPM	TYPE	CONTROL DEVICE	VOLTAGE / PHASE	FLA	MOCP	GA: FUEL	S LOAD	OUTPUT	# OF STAGES	EFF.	CONN GAS	EXH.	REMARKS	REMARNO
GUH	REZNOR	UDX-030	-	-	(1)	80	1	384 CFM	0.06 hp	1550	T.E.F.M.	(4)	120 V / 1	1.9 A	15.0 A	NATURAL GAS	30,000	24,900	1	83%	1/2"	4"	(3)	(2) (4)
GUH-1	REZNOR	UDX-150	SEE PLANS	(5)	(1)	200	1	1921 CFM	0.25 hp	1050	T.E.F.M.	(4)	120 V / 1	3.8 A	15.0 A	NATURAL GAS	150,000	124,500	1	83%	1/2"	5"	(3)	(2) (4)

SPLIT SYSTEM AIR CONDITIONER SCHEDULE

1. HIGH-WALL DUCTLESS AIR-COOLED SPLIT SYSTEM WITH OUTDOOR REMOTE HEAT PUMP. PLAN TAG ON SCHEDULE CORRESPONDS WITH INDOOR UNIT. ALL UNITS HAVE OUTDOOR UNIT WITH MATCHING NUMERAL. 2. PROVIDE WITH CONDENSATE PUMP CAPABLE OF A MINIMUM OF 6 FOOT OF HEAD. PUMP RESERVE SHALL HAVE HIGH LEVEL ALARM.

3. CONDENSING UNIT LOCATED ON ROOF. PROVIDE ALL ADDITIONAL REFRIGERANT PIPING ACCESSORIES AS REQUIRED TO ACCOMMODATE REFRIGERANT LINE LENGTH AND CONDENSING UNIT ELEVATION (SEE PLANS). 4. PROVIDE MANUFACTURER'S STANDARD WALL MOUNTED WIRED THERMOSTAT (PAC). 5. PROVIDE COMPRESSOR WITH 5-YEAR WARRANTY.

7. ELECTRICAL DISCONNECT FOR INDOOR UNIT SHALL BE INTEGRAL PROVIDED WITH EQUIPMENT. ELECTRICAL DISCONNECT FOR OUTDOOR UNIT BY ELECTRICAL CONTRACTOR. SEE ELECTRICAL DRAWINGS. 8. SUBJECT TO COMPLIANCE WITH REQUIREMENTS, PROVIDE PRODUCT BY ONE OF THE FOLLOWING MANUFACTURERS: LENNOX, MITSUBISHI, YORK, TRANE, CARRIER

			GENERAL				P	HYSICAL SIZE				ELECTRICAL		REFRIG.		
DOOR	INDOOR	OUTDOOR	OUTDOOR	MANUFACTURER	SERVES	CONFIG.	INDOOR UNIT	OUTDOOR UNIT	WEIGHT	AIRFLOW RANGE	VOLTAGE /	MCA	MOCP	TYPE	C	APACI
N TAG	MODEL	MODEL	PLAN TAG	(8)	JERVEJ	CONFIG.	(L x W x H)	(L x W x H)	(lbs.)		PHASE	AC / ACCU	ACCU		TONS	TOT
\C-1	PKA-A12HA7	PUZ-A12NKA7	HP-1	MITSUBISHI	ELEC 42	(1)	36" x 10" x 12"	32" x 12" x 25"	29	320-370-425	208 V / 1	1 / 11	15	R-410a	1.0	12,0

FAN SCHEDULE

OWNBLAST EXHAUST FAN WITH EC MOTOR. ATIBLE WITH ROOFING SYSTEM, BIRDSCREEN, MOTORIZED DAMPER (SAME VOLTAGE AS FAN MOTOR & INTERLOCKED WITH FAN), AND ELECTRICAL DISCONNECT. ROOF CURBS FOR EF-2, EF-3, EF-5, SF-1, SF-2 SHALL BE SLOPED TO MATCH EXISTING IMB ON THE ROOF. CONFIRM ROOF SLOPE WITH EXISTING ROOF.

JRING OCCUPIED HOURS ONLY. ESPECTIVE CO / NO2 GAS DETECTION SYSTEMS. OCCUPANTS SHALL HAVE THE ABILITY TO MANUALLY OPERATE THE FANS FOR VENTILATION PURPOSES. SET ROOM SET POINT TO 85°F(ADJ).

/NBLAST EXHAUST FAN. E ROOF SUPPLY FAN.

GENE	RAL			PHYSICAL	SIZE				FA	N					М	OTOR		ELECTRICAL
	SERVES	TYPE	ACC.	ROOF / WALL	WEIGHT	AIRFLOW	E.S.P.	WH	EEL	DRIVE		MAXIMUM		HP	RPM	TYPE	CONTROL	VOLTAGE /
	JERVEJ	1175	ACC.	OPENING SIZE	(lbs)	(CFM)	(in-wg)	TYPE	DIA. Ø	DRIVE	BHP	RPM	SONES	ΠF		IIFE	DEVICE	PHASE
	SERVICE DRIVE 1	(1)	(2)	26.5" x 26.5"	81	2700 CFM	0.35	B.I.	18"	DIRECT	0.44	884	9.8	0.75	1750	O.D.P.	(4)	208 V / 1
	SERVICE 18	(6)	(2)	36.5" x 36.5"	175	9400 CFM	0.35	B.I.	30"	BELT	2.1	661	17.2	3	1750	O.D.P.	(4)	460 V / 3
	SERVICE 32	(6)	(2)	36.5" x 36.5"	142	7700 CFM	0.35	B.I.	30"	BELT	1.36	565	13.1	2	1750	O.D.P.	(4)	460 V / 3
	JAN/STOR 13	(1)	(2)	12.5" x 12.5"	19	100 CFM	0.35	B.I.	10"	DIRECT	0.02	1725	3.5	0.02	1725	O.D.P.	(3)	120 V / 1
	COMPRESSOR	(1)	(2)	18.5" x 18.5"	54	1200 CFM	0.35	B.I.	14.0"	DIRECT	0.16	937	6.9	0.5	1750	0.D.P.	(5)	120 V / 1
6	SERVICE 32	(7)	(2)	38.5" x 38.5"	531	9400 CFM	0.35	B.I.	36"	BELT	1.45	924	28	2	1750	O.D.P.	(4)	460 V / 3
0	SERVICE 18	(7)	(2)	32.5" x 32.5"	394	7700 CFM	0.35	B.I.	30"	BELT	1.38	1050	28	2	1750	O.D.P.	(4)	460 V / 3

GAS UNIT HEATER SCHEDULE

4. PROVIDE WITH 120V THERMOSTAT (REMOTE MOUNT) AND CONTROL TRANSFORMER. THERMOSTAT SHALL HAVE FAN ONLY SWITCH TO ALLOW FAN (NO HEAT) TO OPERATE MANUALLY.


				GAS	5-FIR	ED RA	DIANT HE	ATE	ER SC	CHEDL	JLE					
PROVIDE WITH PROVIDE LINE V PROVIDE PRE A PROVIDE 3 YEA PROVIDE WITH PROVIDE WITH HEATERS SHAL	120 VOLT POWE VOLTAGE THERI ND POST PURG RS WARRANTY STAINLESS STE OUTSIDE COMB L BE 2-STAGE C	TEEL REFLECTORS F ER GAS BURNER WIT MOSTATS AS SHOW SE LINE VOLT CONTR ON COMPONENTS, EEL GAS FLEX CONN BUSTION AIR DUCT. OPERATION. IBER AND ROLLES S	TH ELECTRONIC SP/ N ON PLAN. SINGLE ROL PANELS. 10 YEAR WARRANT ECTION AND GAS C	RK. THERMOST ON TUBIN DCK.	G.	LL BE SHAREI) BETWEEN 2 HEAT	ERS.								
		GEN	IERAL				PHYSIC	AL SIZE				GAS-FIRED H	EATING			
PLAN TAG	MANUFACTU		SERVES	TUBI		CONFIG.	DIMENSIONS (D x W x H)		NGTH	CAPACITY (BTU/h)	GAS LO		EFF.	VENT CONN.	VENT TYPE	REMAR
RH	REZNOR	R VPT	SEE PLANS	-		2-STAGE	SEE PLANS	8	4'-0"	150,000	NATURAL GAS	-	82%	4"Ø	POSITIVE	ALL
RH-1A	REZNOR		SERVICE DRIVE	1 (1)		2-STAGE	SEE PLANS	-	60'-0"	100,000	NATURAL GAS	,	82%	4"Ø	POSITIVE	(2-9)
RH-1B	REZNOR	R VPT	SERVICE DRIVE	,		2-STAGE	SEE PLANS	3	60'-0"	100,000	NATURAL GAS	5 100,000	82%	4"Ø	POSITIVE	(2-9)
RH-1C	REZNOR	R VPT	SERVICE DRIVE	1 (1)		2-STAGE	SEE PLANS	3	0'-0"	100,000	NATURAL GAS	6 100,000	82%	4"Ø	POSITIVE	(2-9)
RH-1D	REZNOR	R VPT	SERVICE DRIVE	1 (1)		2-STAGE	SEE PLANS	3	0'-0"	100,000	NATURAL GAS	S 100,000	82%	4"Ø	POSITIVE	(2-9)
	2. PROVIDE 3. PROVIDE TO NAILER (V	WITH BIRDSCREEN. WITH MANUFACTUR WITH 18" ROOF CUF VERIFY REQUIRED F WITH MOTORIZED D	RB. CONTRACTOR LASHING DIMENSIC AMPER. INTERLOC	HALL CON	FIRM RO Ofing Co	- 70% PVDF. OF INSULATIO DNTRACTOR).	ON THICKNESS AT I INCREASE INDICA D INTERLOCK HD-2	COLOR INAL P	SELECTI PLACEMEN JRB HEIG	ED BY ARCH NT OF EQUII HT AS REQU	IITECT. PMENT. PROVIDE I JIRED.	OLTAGE TO	MATCH ASSO			
	1. PROVIDE 2. PROVIDE 3. PROVIDE TO NAILER (V 4. PROVIDE	WITH MANUFACTUR WITH 18" ROOF CUF VERIFY REQUIRED F WITH MOTORIZED D GENE	RB. CONTRACTOR	SHALL CON N WITH ROO (HD-1 WITI	FIRM RO Ofing Co H EF-1 of	- 70% PVDF. OF INSULATIO DNTRACTOR). PERATION AN	STANDARD FINISH IN THICKNESS AT I INCREASE INDICA D INTERLOCK HD-2 PHYSICAL SIZE	COLOR FINAL P TED CL WITH E	SELECTI PLACEMEN JRB HEIG	ED BY ARCH NT OF EQUII HT AS REQI RATION. DAI	IITECT. MENT. PROVIDE I JIRED. MPER ACTUATOR V	OLTAGE TO	MATCH ASSC	DCIATED INTE	RLOCKED F	AN.
	1. PROVIDE 2. PROVIDE 3. PROVIDE TO NAILER (V 4. PROVIDE	WITH MANUFACTUR WITH 18" ROOF CUF VERIFY REQUIRED F WITH MOTORIZED D	RB. CONTRACTOR	HALL CON	FIRM RO Ofing Co H EF-1 of	- 70% PVDF. OF INSULATIO DNTRACTOR). PERATION AN	STANDARD FINISH ON THICKNESS AT I INCREASE INDICA D INTERLOCK HD-2	COLOR FINAL P TED CL WITH E	SELECTI LACEMEN JRB HEIG EF-5 OPER	ED BY ARCH NT OF EQUII HT AS REQI RATION. DAI	IITECT. PMENT. PROVIDE I JIRED. MPER ACTUATOR V	OLTAGE TO	MATCH ASSC	DCIATED INTE	RLOCKED F	
	1. PROVIDE 2. PROVIDE 3. PROVIDE TO NAILER (V 4. PROVIDE	WITH MANUFACTUR WITH 18" ROOF CUF VERIFY REQUIRED F WITH MOTORIZED D GENE	RB. CONTRACTOR : LASHING DIMENSIC AMPER. INTERLOC RAL MODEL SE FUN	SHALL CON N WITH ROO (HD-1 WITH RVES /	FIRM RO OFING CO H EF-1 OF OVEF	- 70% PVDF. OF INSULATIO DNTRACTOR). PERATION AN	STANDARD FINISH INCREASE INDICA D INTERLOCK HD-2 PHYSICAL SIZE OPENING SIZE	COLOR FINAL P TED CL WITH E	SELECTI LACEMEN JRB HEIG EF-5 OPER	ED BY ARCH NT OF EQUII HT AS REQU RATION. DAI	IITECT. PMENT. PROVIDE I JIRED. MPER ACTUATOR M LOW (ft²) NECK M) AREA	OLTAGE TO AIRFI (FPM) NECK	MATCH ASSC _OW (ft²) CORE	OCIATED INTE	RLOCKED F/ AIR P.D. (IN WG)	AN.

				DIFFUSER REC	JISTER ANL	GRILLE	SCHEL	JULE				
a. VEF b. SEE	ALL FRAMES, FI RIFY QUANTITIES PLANS FOR NE	WITH PLAN CK SIZES.	S.	WITH CEILING CONSTRUCTION PRIOR TO FUR		•						
3. NON-RA	DIAL OPPOSÉD	BLADE DAN	IPER. MAIN BAL	IFFUSERS, REGISTERS AND GRILLES LOCATE ANCING SHALL BE DONE WITH BRANCH VOLU IRAL DUCT WITH 1" INSULATION. COORDINAT	ME DAMPER AT TAKEC	FF LOCATION OF N	-	OPPOSED BLAD	E DAMPER SI	HALL BE USED	For fine tuning oni	.Y.
	MANUEAOTUR	1	1			1						
PLAN TAG	MANUFACTUR ER	MODEL	FUNCTION	DESCRIPTION	MOUNTING (1)	DEFLECTION	AIR P.D. (IN WG)	MATERIAL	FINISH	NECK SIZE	FACE SIZE	REMARKS
D-1	KRUEGER	PLQ	SUPPLY	PLAQUE DIFFUSER	ACT CEILING	360°	0.10"	STEEL	WHITE	SEE PLANS	24"x24"	(1) (2)
G-1	KRUEGER	6690	RETURN / XFR	ROUND NECK PERFORATED FACE	ACT CEILING	PERFORATED	0.10"	STEEL	WHITE	SEE PLANS	24"x24"	(1) (2)
G-2	KRUEGER	80H	EXHAUST	RECT SINGLE DEFLECTION GRILLE	DUCT	SINGLE 3/4"	0.10"	STEEL	WHITE	SEE PLANS	NECK SIZE + 1-3/4"	(1) (2)
G-3	KRUEGER	S80H	RETURN	RECT SINGLE DEFLECTION GRILLE	WALL/SOFFIT	SINGLE 3/4"	0.10"	STEEL	WHITE	SEE PLANS	NECK SIZE + 1-3/4"	(1) (2)
R-1	KRUEGER	880H	SUPPLY	RECT DOUBLE DEFLECTION REGISTER	DUCT	DOUBLE 3/4"	0.10"	STEEL	WHITE	SEE PLANS	NECK SIZE + 1-3/4"	(4) (0) (0)
11						DOODLE OF	0.10				NEON SIZE + 1-5/4	(1) (2) (3)

REMARKS

1. VARIABLE FREQUENCY DRIVES SHALL BE SUITABLE FOR HVAC APPLICATIONS. DRIVE SHALL HAVE STANDARD ACH550 FEATURES PLUS FOLLOWING FEATURES: DISCONNECT, EMI, RFI FILTERS, INPUT AC LINE REACTORS AND AUTOMATIC RESET UPON LOSS OF POWER. DRIVES SHALL NOT HAVE BY PASS. SEE MECHANICAL SPECIFICATIONS. 2. VARIABLE FREQUENCY DRIVES SHALL BE FURNISHED AND INSTALLED BY MECHANICAL CONTRACTOR. POWERED BY ELECTRICAL CONTRACTOR.

						-	-
PLAN TAG	MANUFACTURER	MODEL	SERVES	MO	TOR	VOLTAGE /	REMARKS
PLAN TAG	MANUFACIURER	WODEL	SERVES	HP	TYPE	PHASE	REIVIARNO
VFD-EF-2	ASEA BROWN	ACH550	EF-2	3 hp	0.D.P.	480 V / 3	(1) (2)
VFD-EF-3	ASEA BROWN	ACH550	EF-3	2 hp	O.D.P.	480 V / 3	(1) (2)
VFD-SF-1	ASEA BROWN	ACH550	SF-1	2 hp	O.D.P.	480 V / 3	(1) (2)
VFD-SF-2	ASEA BROWN	ACH550	SF-2	2 hp	O.D.P.	480 V / 3	(1)(2)

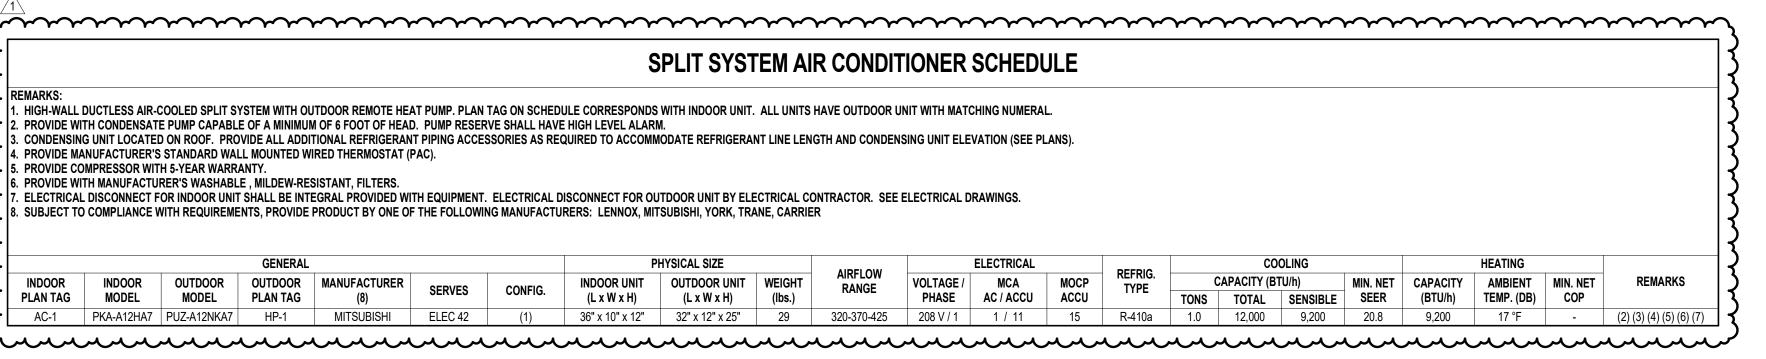

ZONE DAMPER SCHEDULE

1. PROVIDE ZONE DAMPER, ACTUATOR, ZONE CONTROLLER, THERMOSTAT, AND ALL REQUIRED LOW VOLTAGE AND LINE VOLTAGE WIRING, RELAYS, AND PROGRAMMING REQUIRED FOR A COMPLETE OPERATIONAL SYSTEM. MINIMUM FLOW SHALL BE 30% OF DESIGN FLOW. 2. PROVIDE BY-PASS DAMPER, ACTUATOR, STATIC PRESSURE SENSOR BYPASS CONTROLLER, AND ALL REQUIRED WIRING RELAYS, AND PROGRAMMING REQUIRED FOR A COMPLETE OPERATIONAL SYSTEM. MINIMUM FLOW SHALL BE 0. 4. AIRFLOW SCHEDULED IS DESIGN AIRFLOW. 5. PRESSURE DEPENDANT, MODULATING, OPPOSED BLADE DAMPER WITH 24-VOLT ACTUATOR.

PLAN TAG	MANUFACTURER	DUC1	SIZE	AIRFLOW	SERVES	DESCRIPTION	REMARKS
PLAN TAG	WANUFACIURER	Н	W	(CFM) (3)	SERVES	DESCRIPTION	REIMARNO
BPD-1	HONEYWELL	12"	22"	1,800	BYPASS	(5)	(2) (3) (4)
ZD-1	HONEYWELL	10"	12"	650	SERVICE MGR 14	(5)	(1) (3) (4)
ZD-2	HONEYWELL	8"	8"	250	BREAK 12	(5)	(1) (3) (4)
ZD-3	HONEYWELL	12"	20"	1,650	LOBBY 2	(5)	(1) (3) (4)






ARCHITECT **BVH ARCHITECTURE** 901 JONES STREET OMAHA NE 68102 V 402 345 3060 F 402 345 7871 bvh.com

CIVIL ENGINEER LAMP RYNEARSON 14710 W DODGE RD #100 OMAHA, NE 68154 V 402 496 2498 Ira-inc.com

STRUCTURAL ENGINEER LANGE STRUCTURAL GROUP 1919 S 40TH STREET, SUITE 302 LINCOLN NE 68506 V 402 421 9540 langestructuralgroup.com

MEP ENGINEER MORRISSEY ENGINEERING 4940 N 118TH ST OMAHA, NE 68164 V 402 491 4144 morrisseyengineering.com

CONSTRUCTION MANAGER MCL CONSTRUCTION 14124 INDUSTRIAL RD OMAHA, NE 68144 V 402 339 2221 mclconstruction.com

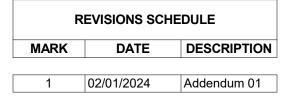





PROJECT: 23043 **DATE:** JANUARY 19, 2024 PROJECT STATUS: CONSTRUCTION © COPYRIGHT BVH ARCHITECTURE







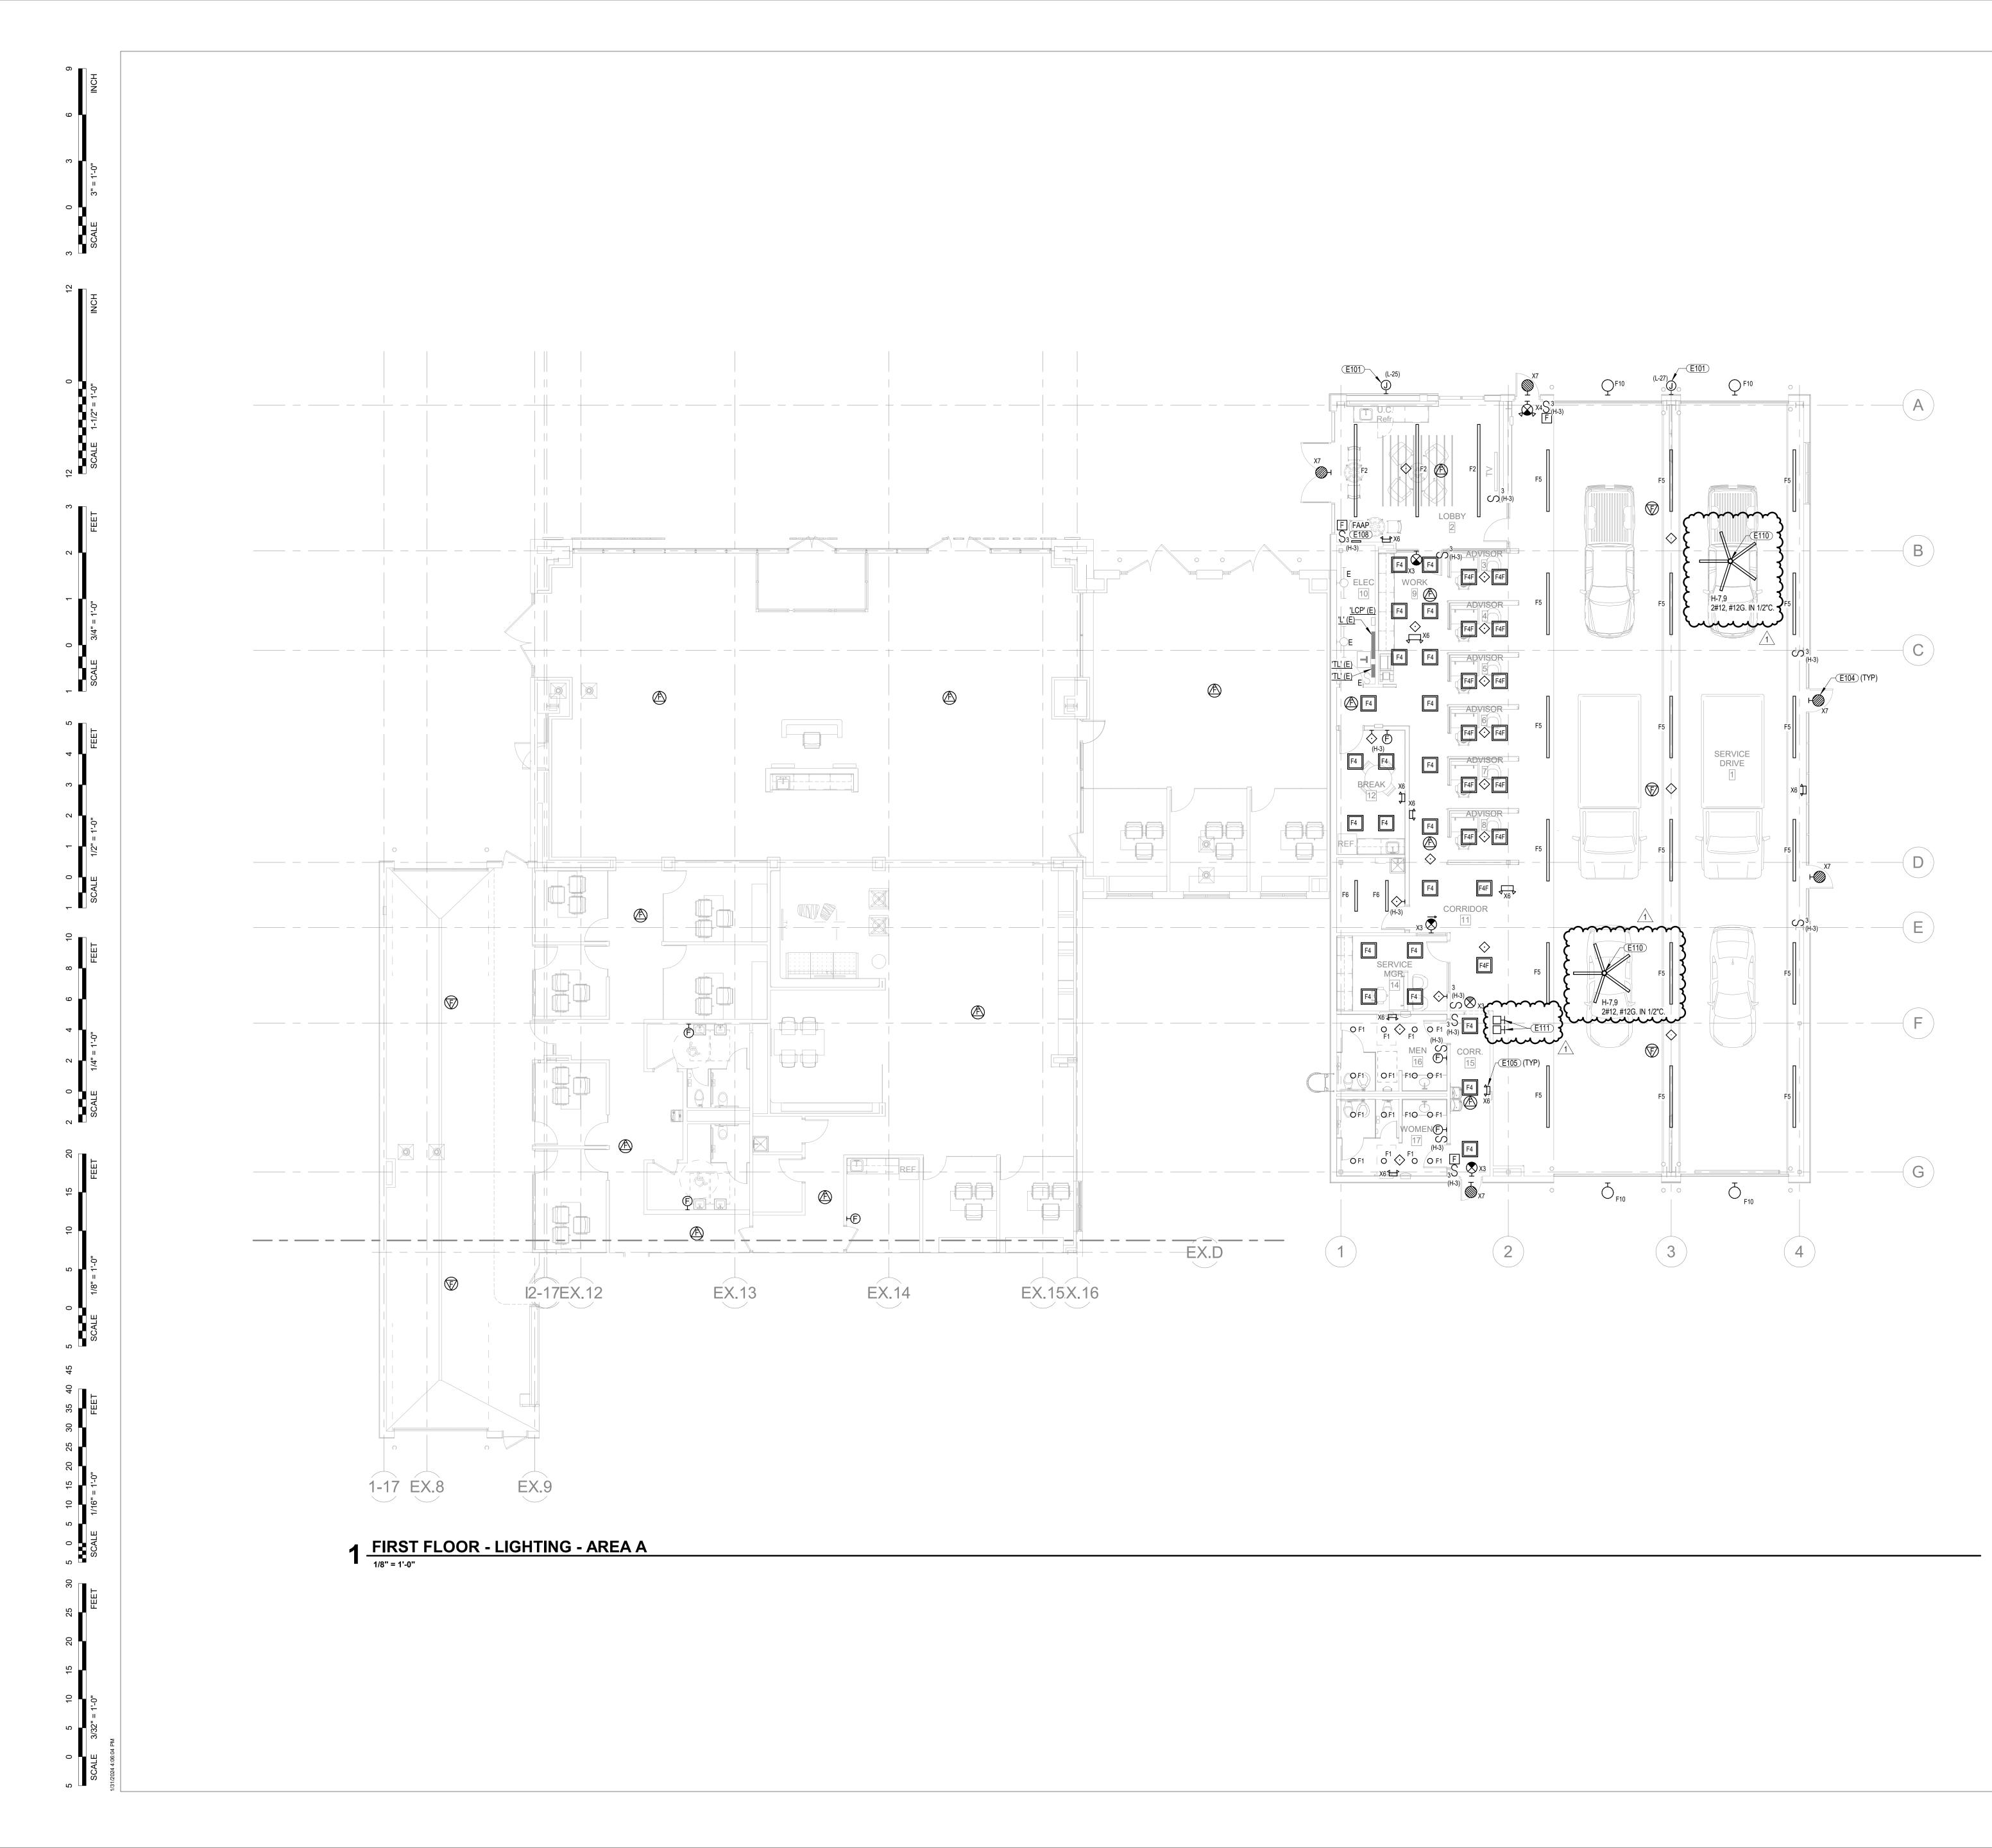


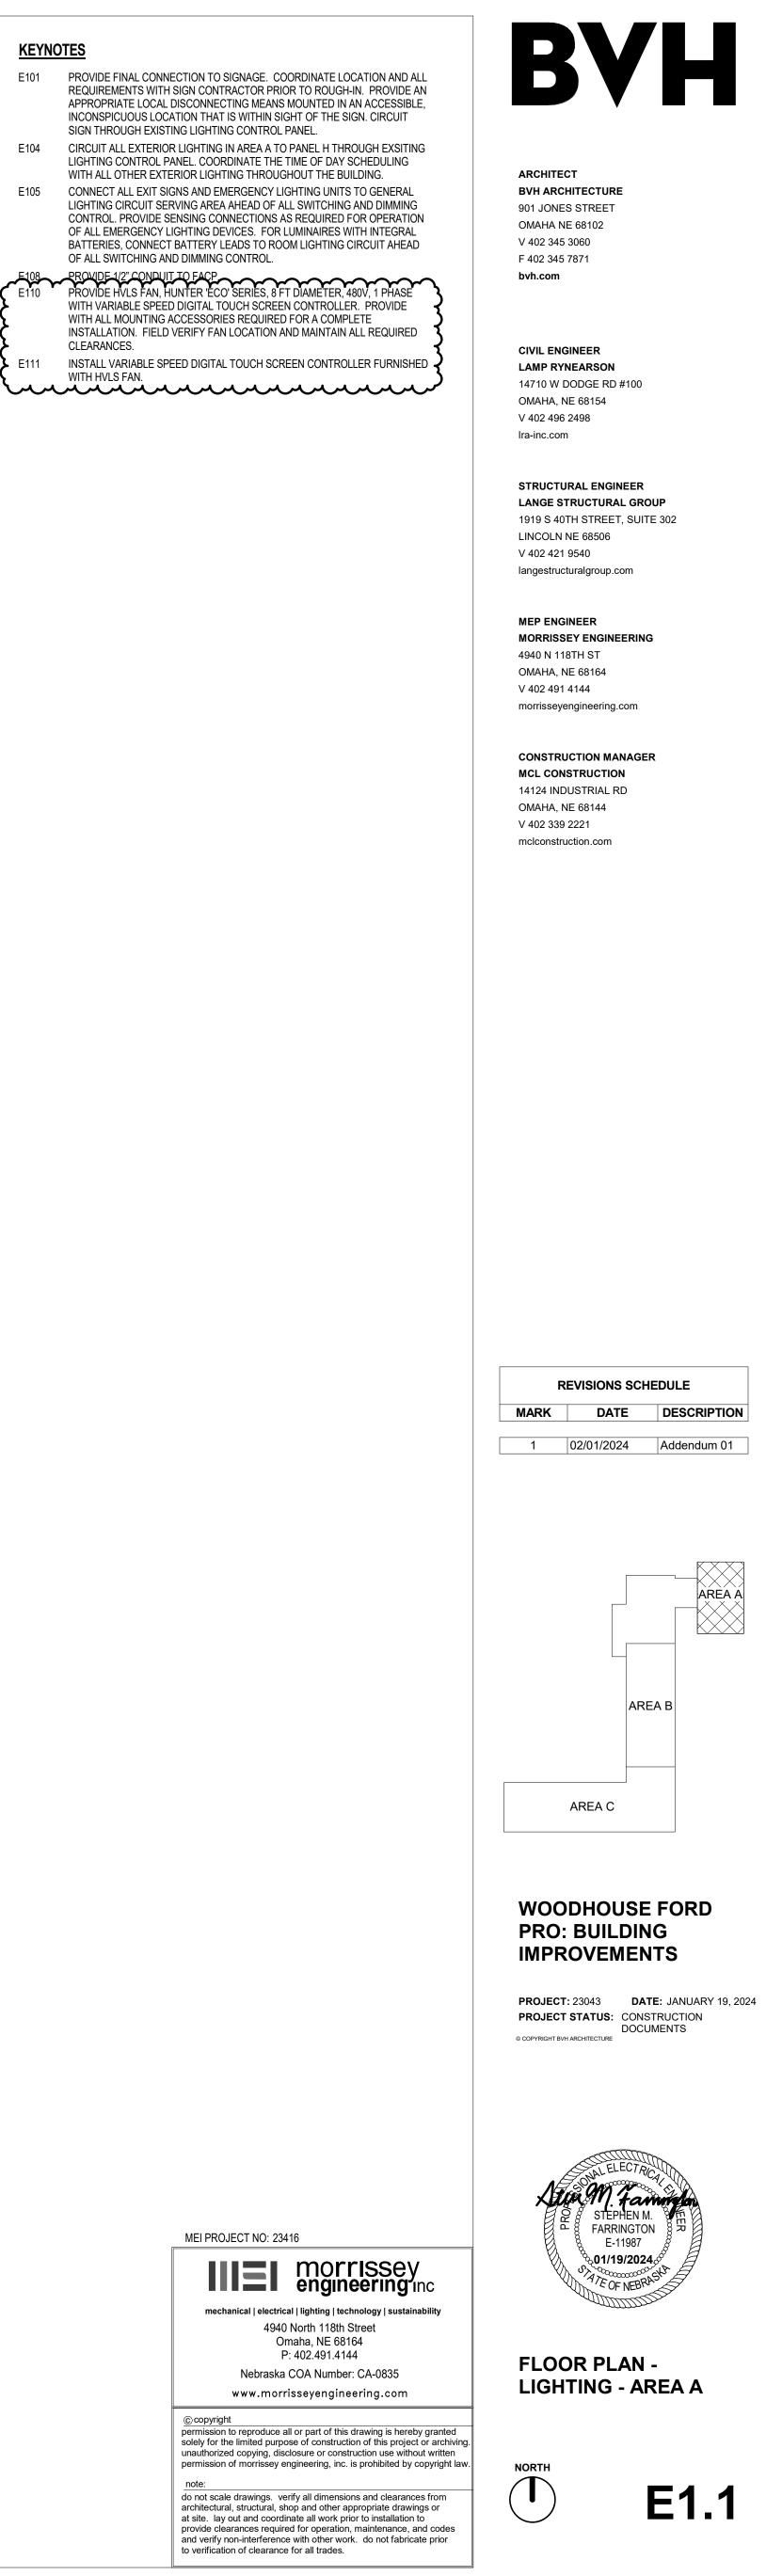



KEYNOTES


INCONSPICUOUS LOCATION THAT IS WITHIN SIGHT OF THE SIGN. CIRCUIT SIGN THROUGH EXISTING LIGHTING CONTROL PANEL. E104 CIRCUIT ALL EXTERIOR LIGHTING IN AREA A TO PANEL H THROUGH EXSITING LIGHTING CONTROL PANEL. COORDINATE THE TIME OF DAY SCHEDULING WITH ALL OTHER EXTERIOR LIGHTING THROUGHOUT THE BUILDING. E105 CONNECT ALL EXIT SIGNS AND EMERGENCY LIGHTING UNITS TO GENERAL LIGHTING CIRCUIT SERVING AREA AHEAD OF ALL SWITCHING AND DIMMING CONTROL. PROVIDE SENSING CONNECTIONS AS REQUIRED FOR OPERATION OF ALL EMERGENCY LIGHTING DEVICES. FOR LUMINAIRES WITH INTEGRAL BATTERIES, CONNECT BATTERY LEADS TO ROOM LIGHTING CIRCUIT AHEAD

CLEARANCES. WITH HVLS FAN.

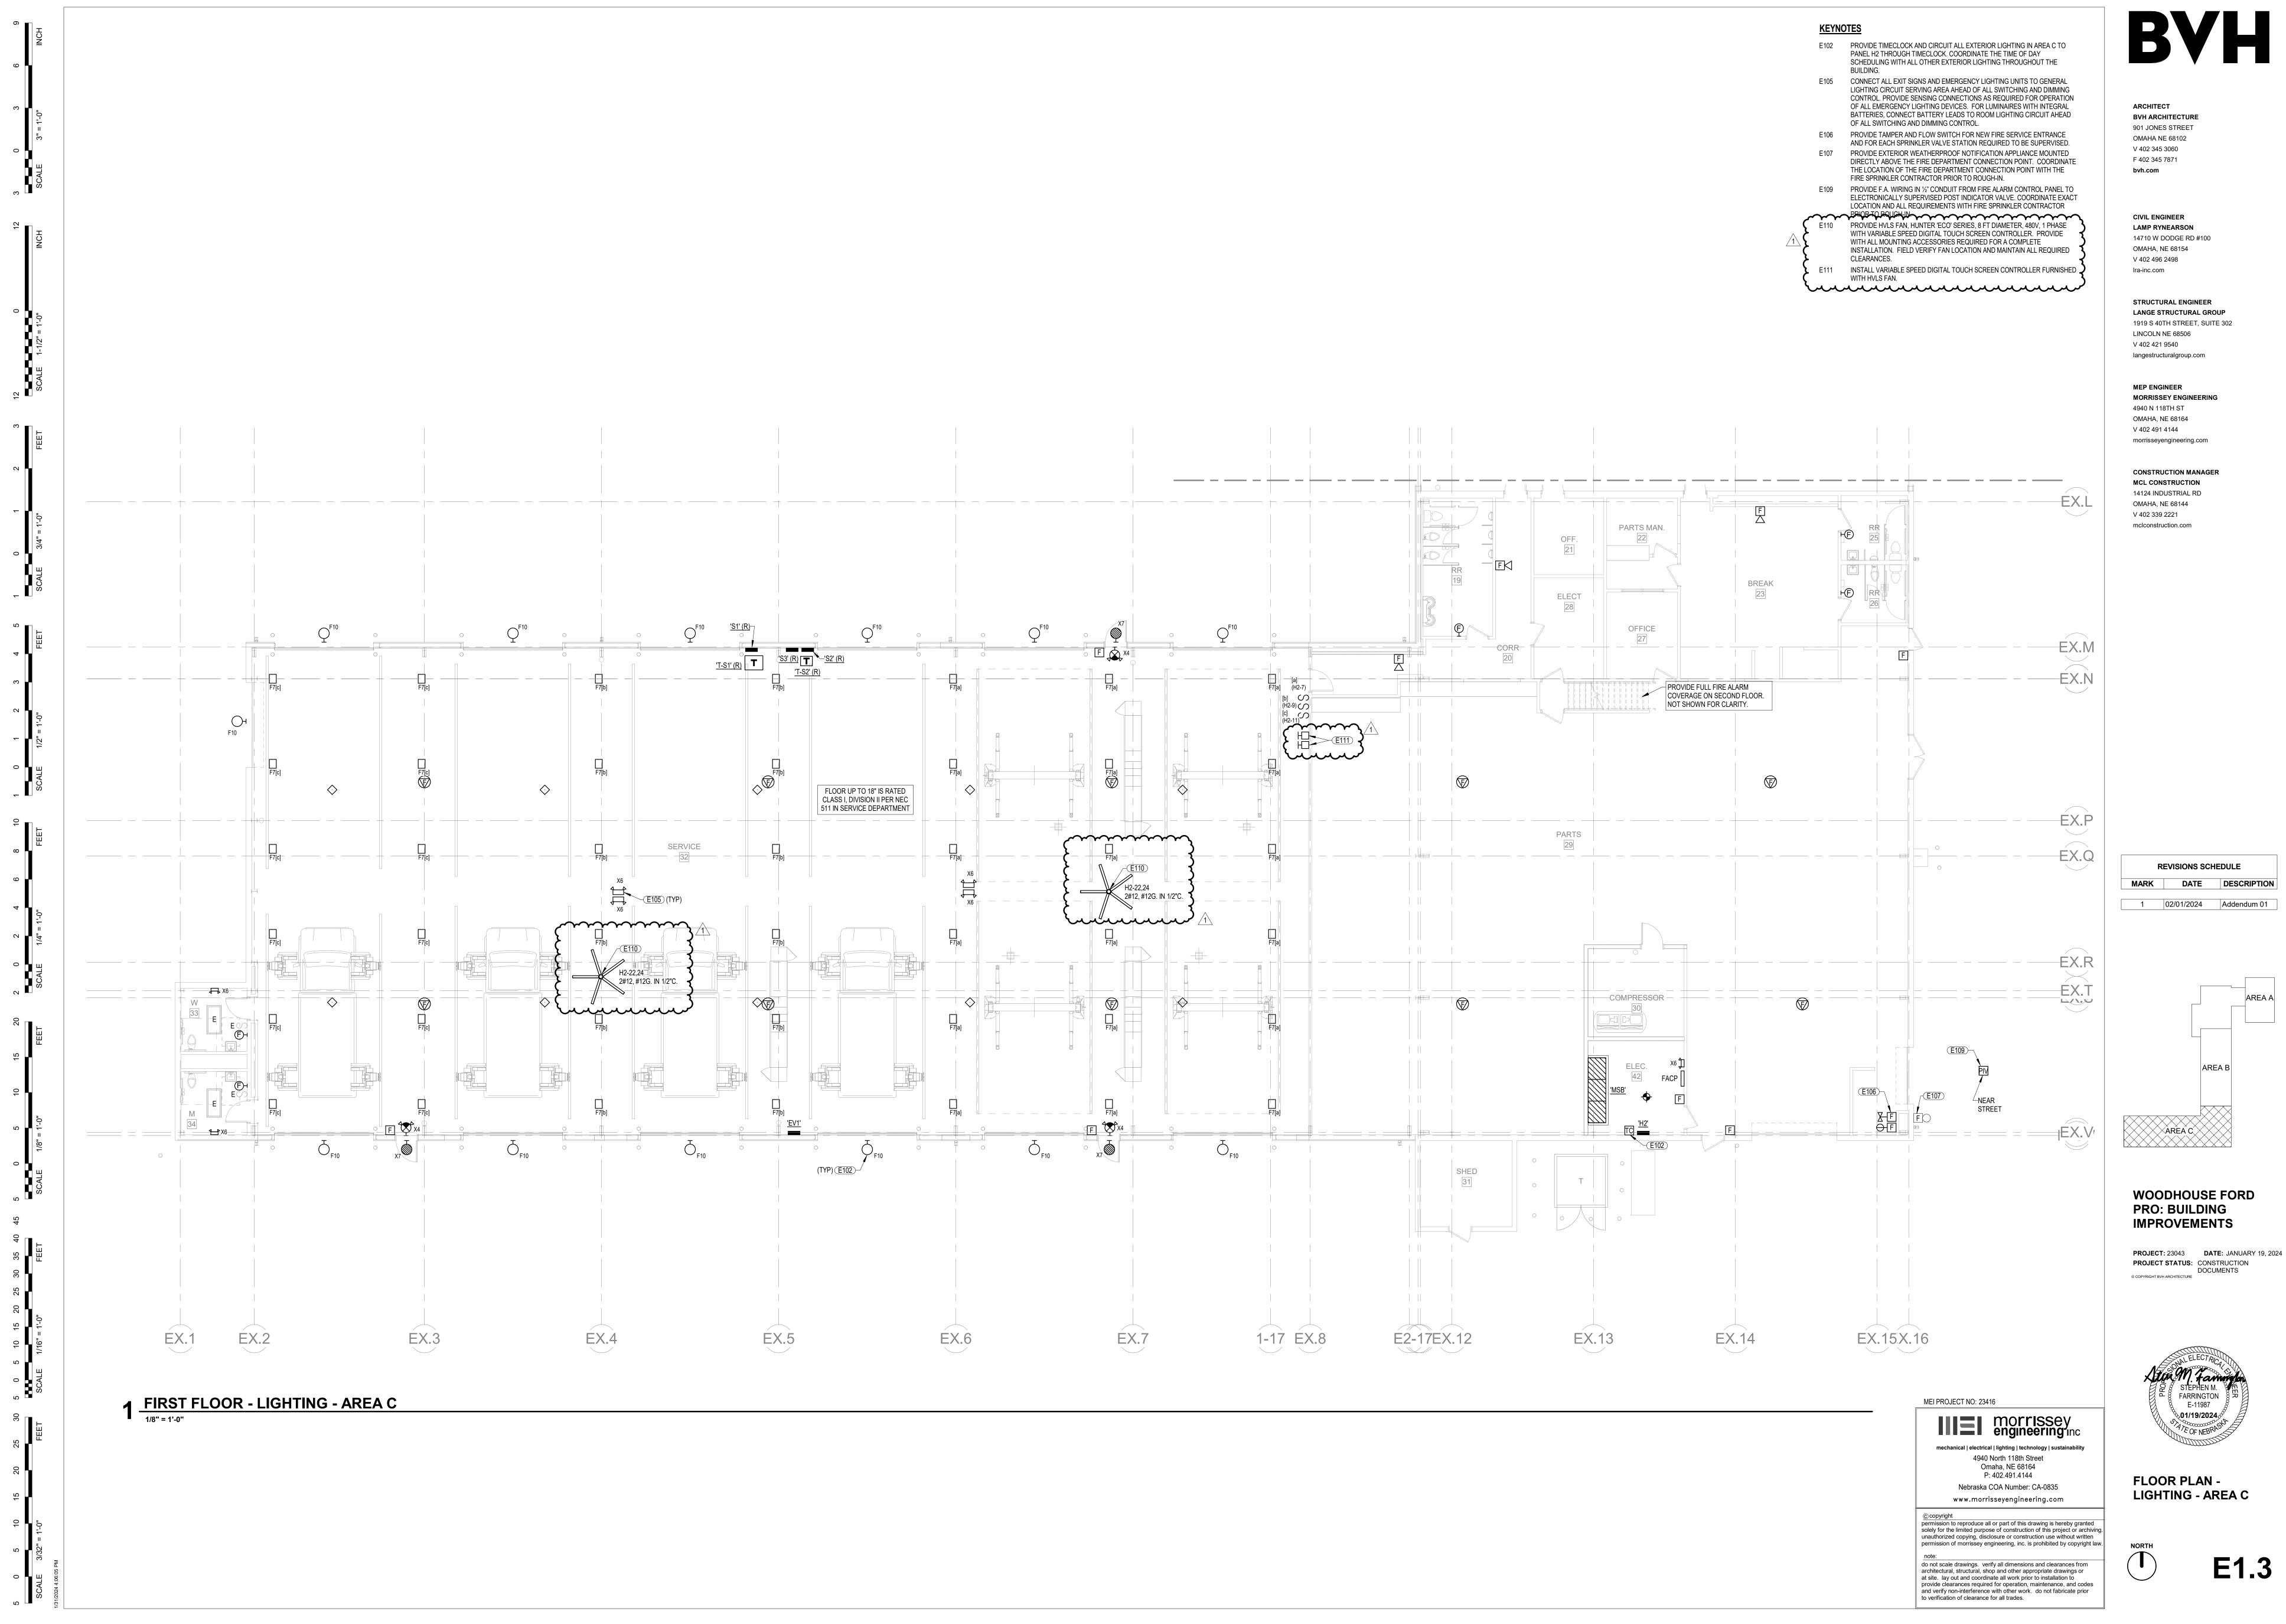


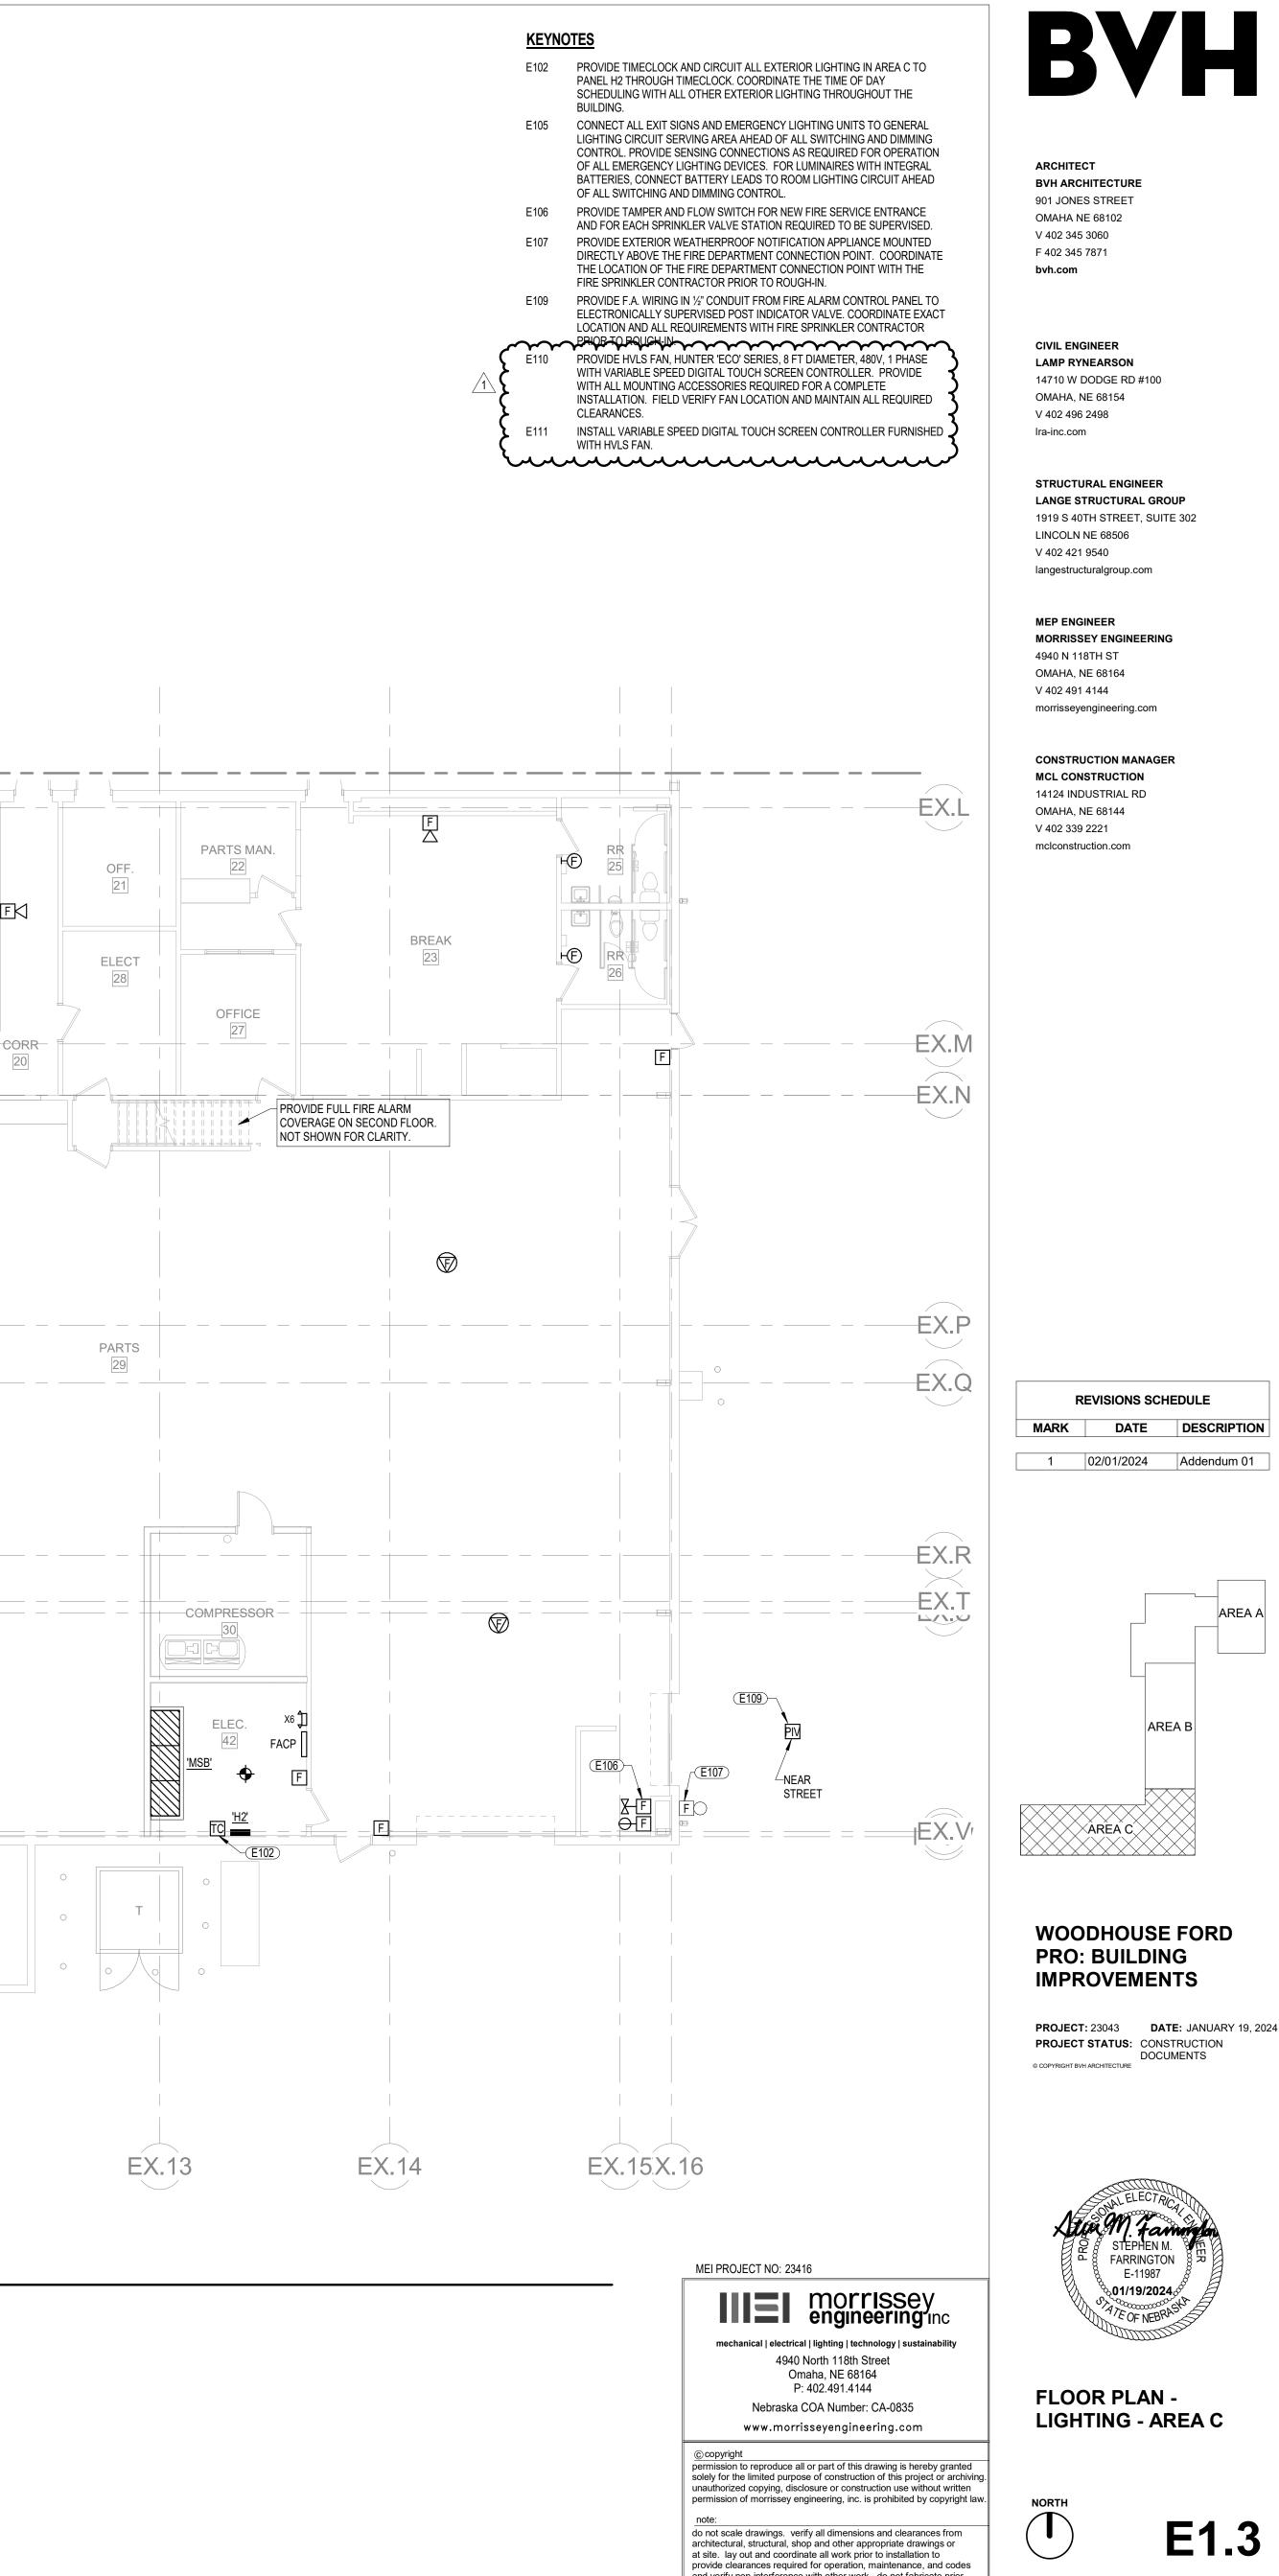


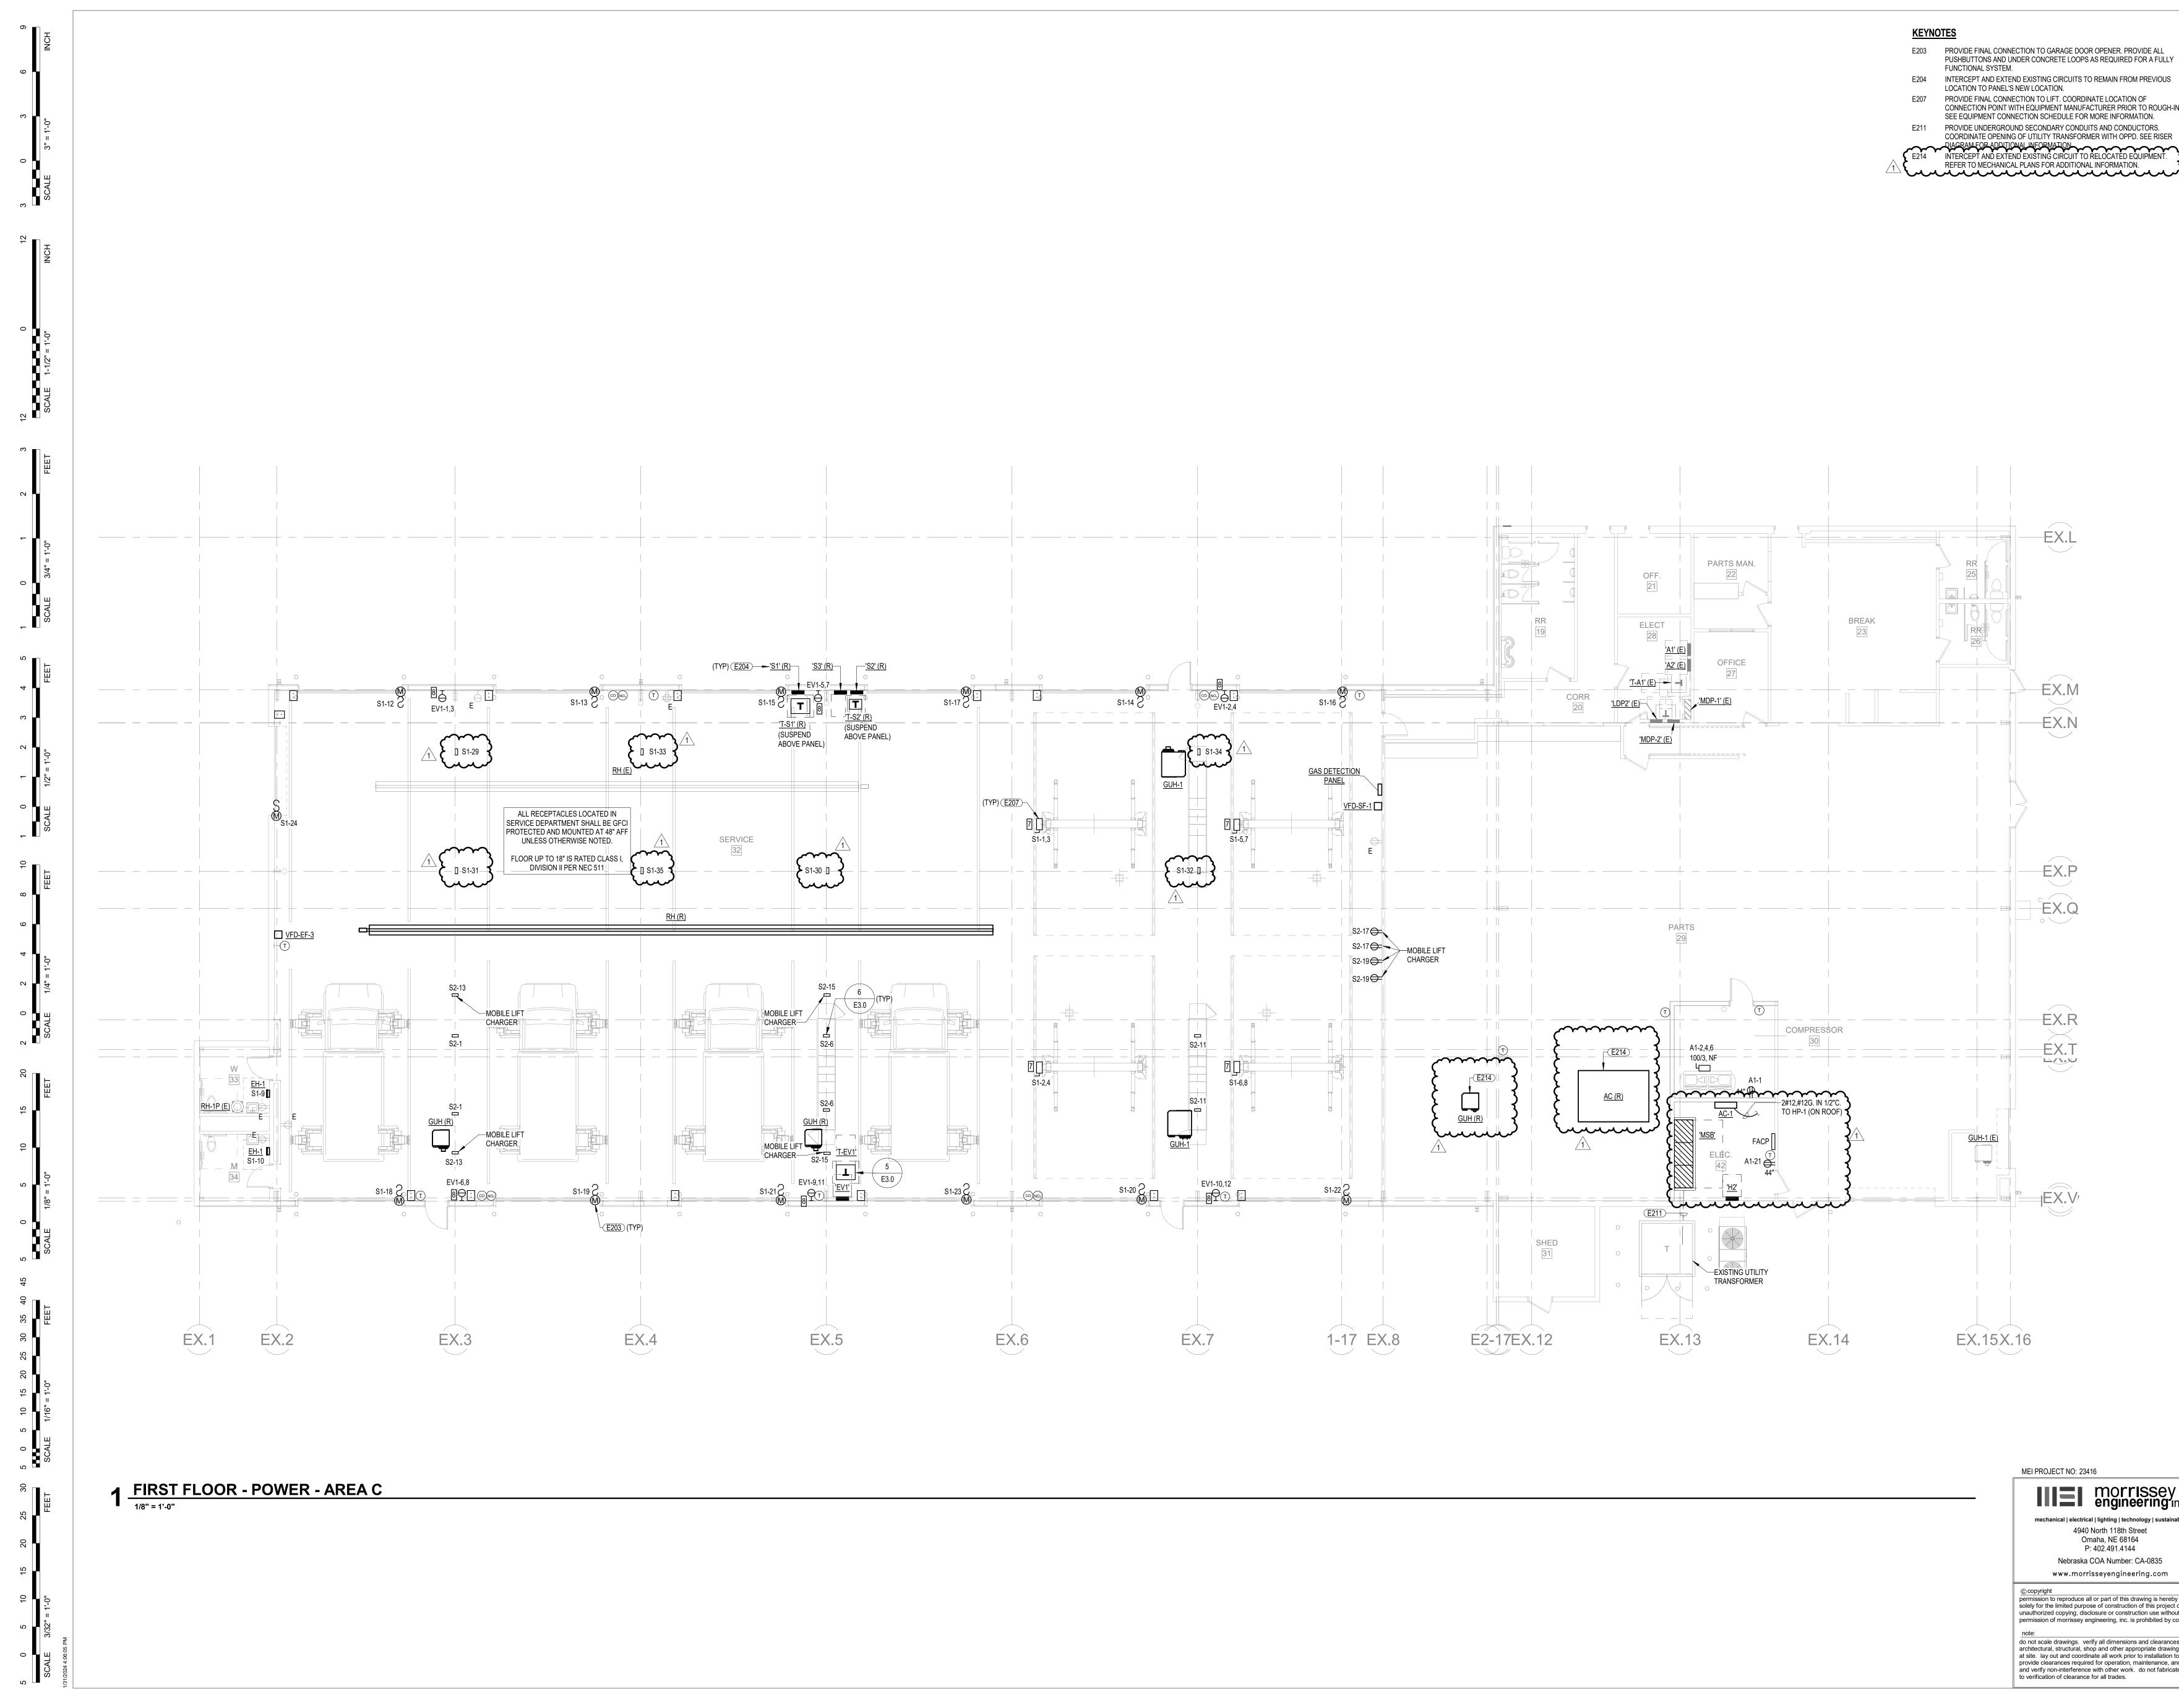

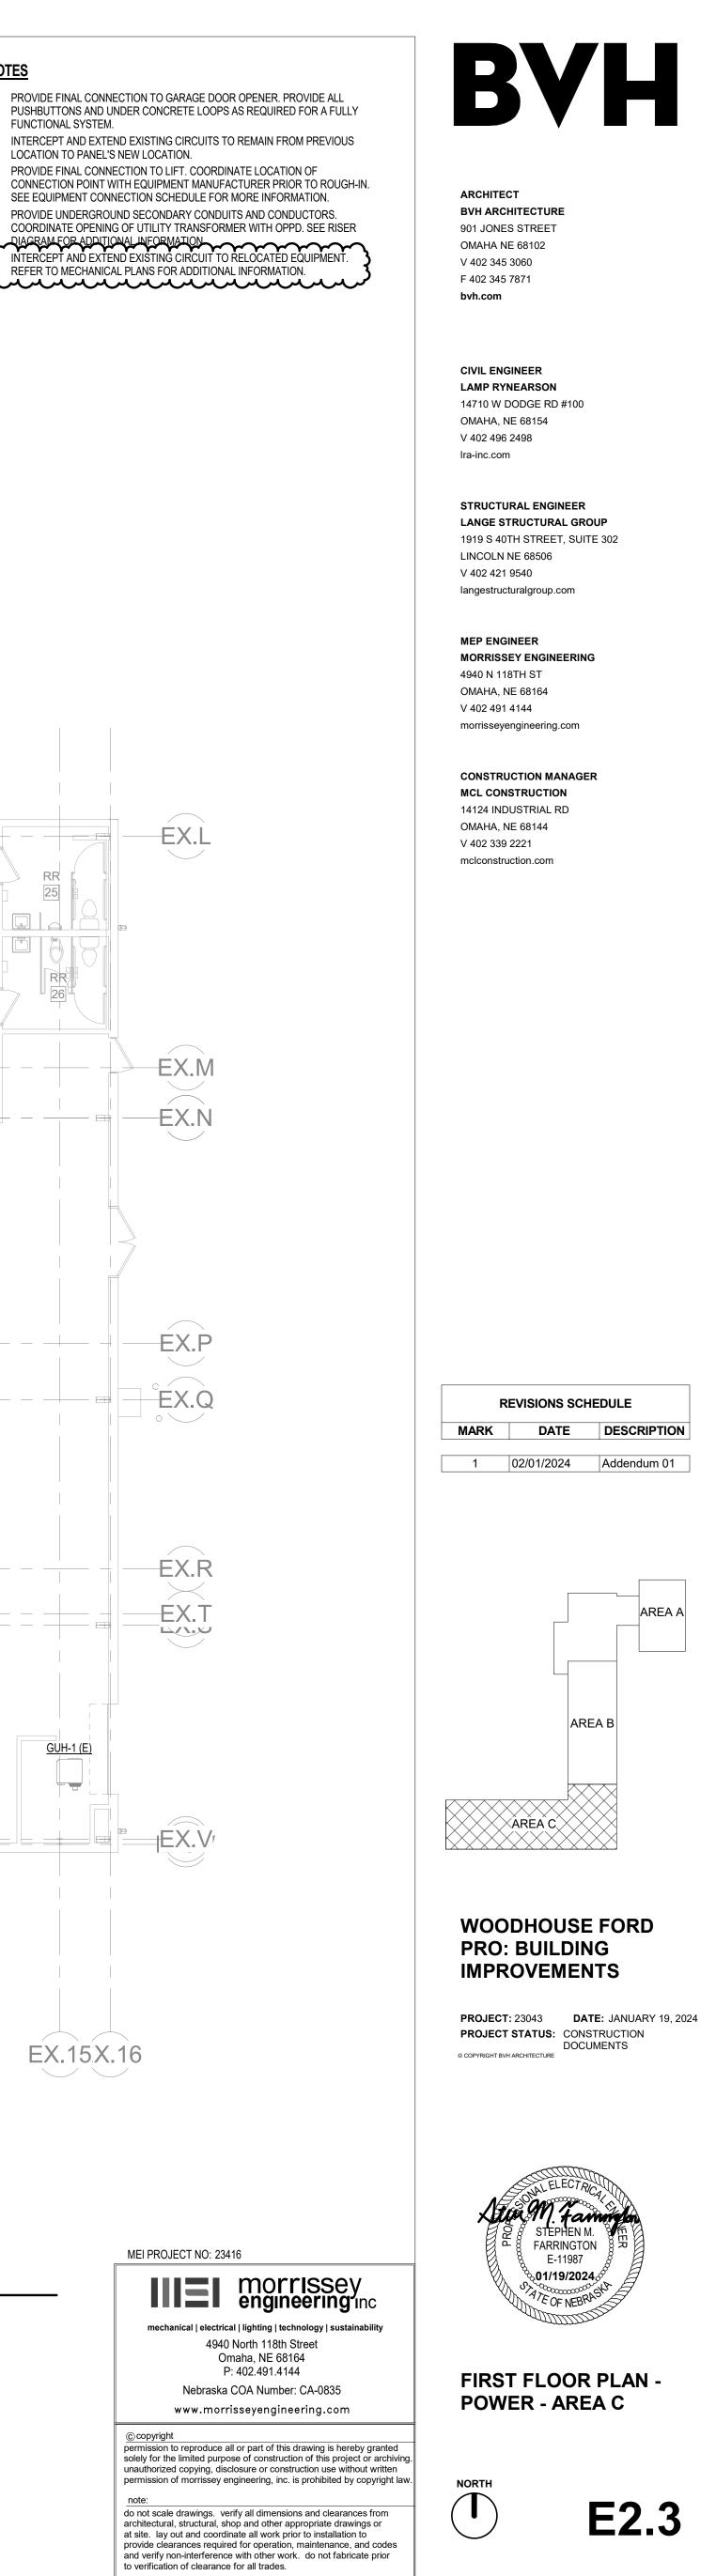

E203 PROVIDE FINAL CONNECTION TO GARAGE DOOR OPENER. PROVIDE ALL PUSHBUTTONS AND UNDER CONCRETE LOOPS AS REQUIRED FOR A FULLY E204 INTERCEPT AND EXTEND EXISTING CIRCUITS TO REMAIN FROM PREVIOUS E207 PROVIDE FINAL CONNECTION TO LIFT. COORDINATE LOCATION OF SEE EQUIPMENT CONNECTION SCHEDULE FOR MORE INFORMATION. E211 PROVIDE UNDERGROUND SECONDARY CONDUITS AND CONDUCTORS. COORDINATE OPENING OF UTILITY TRANSFORMER WITH OPPD. SEE RISER

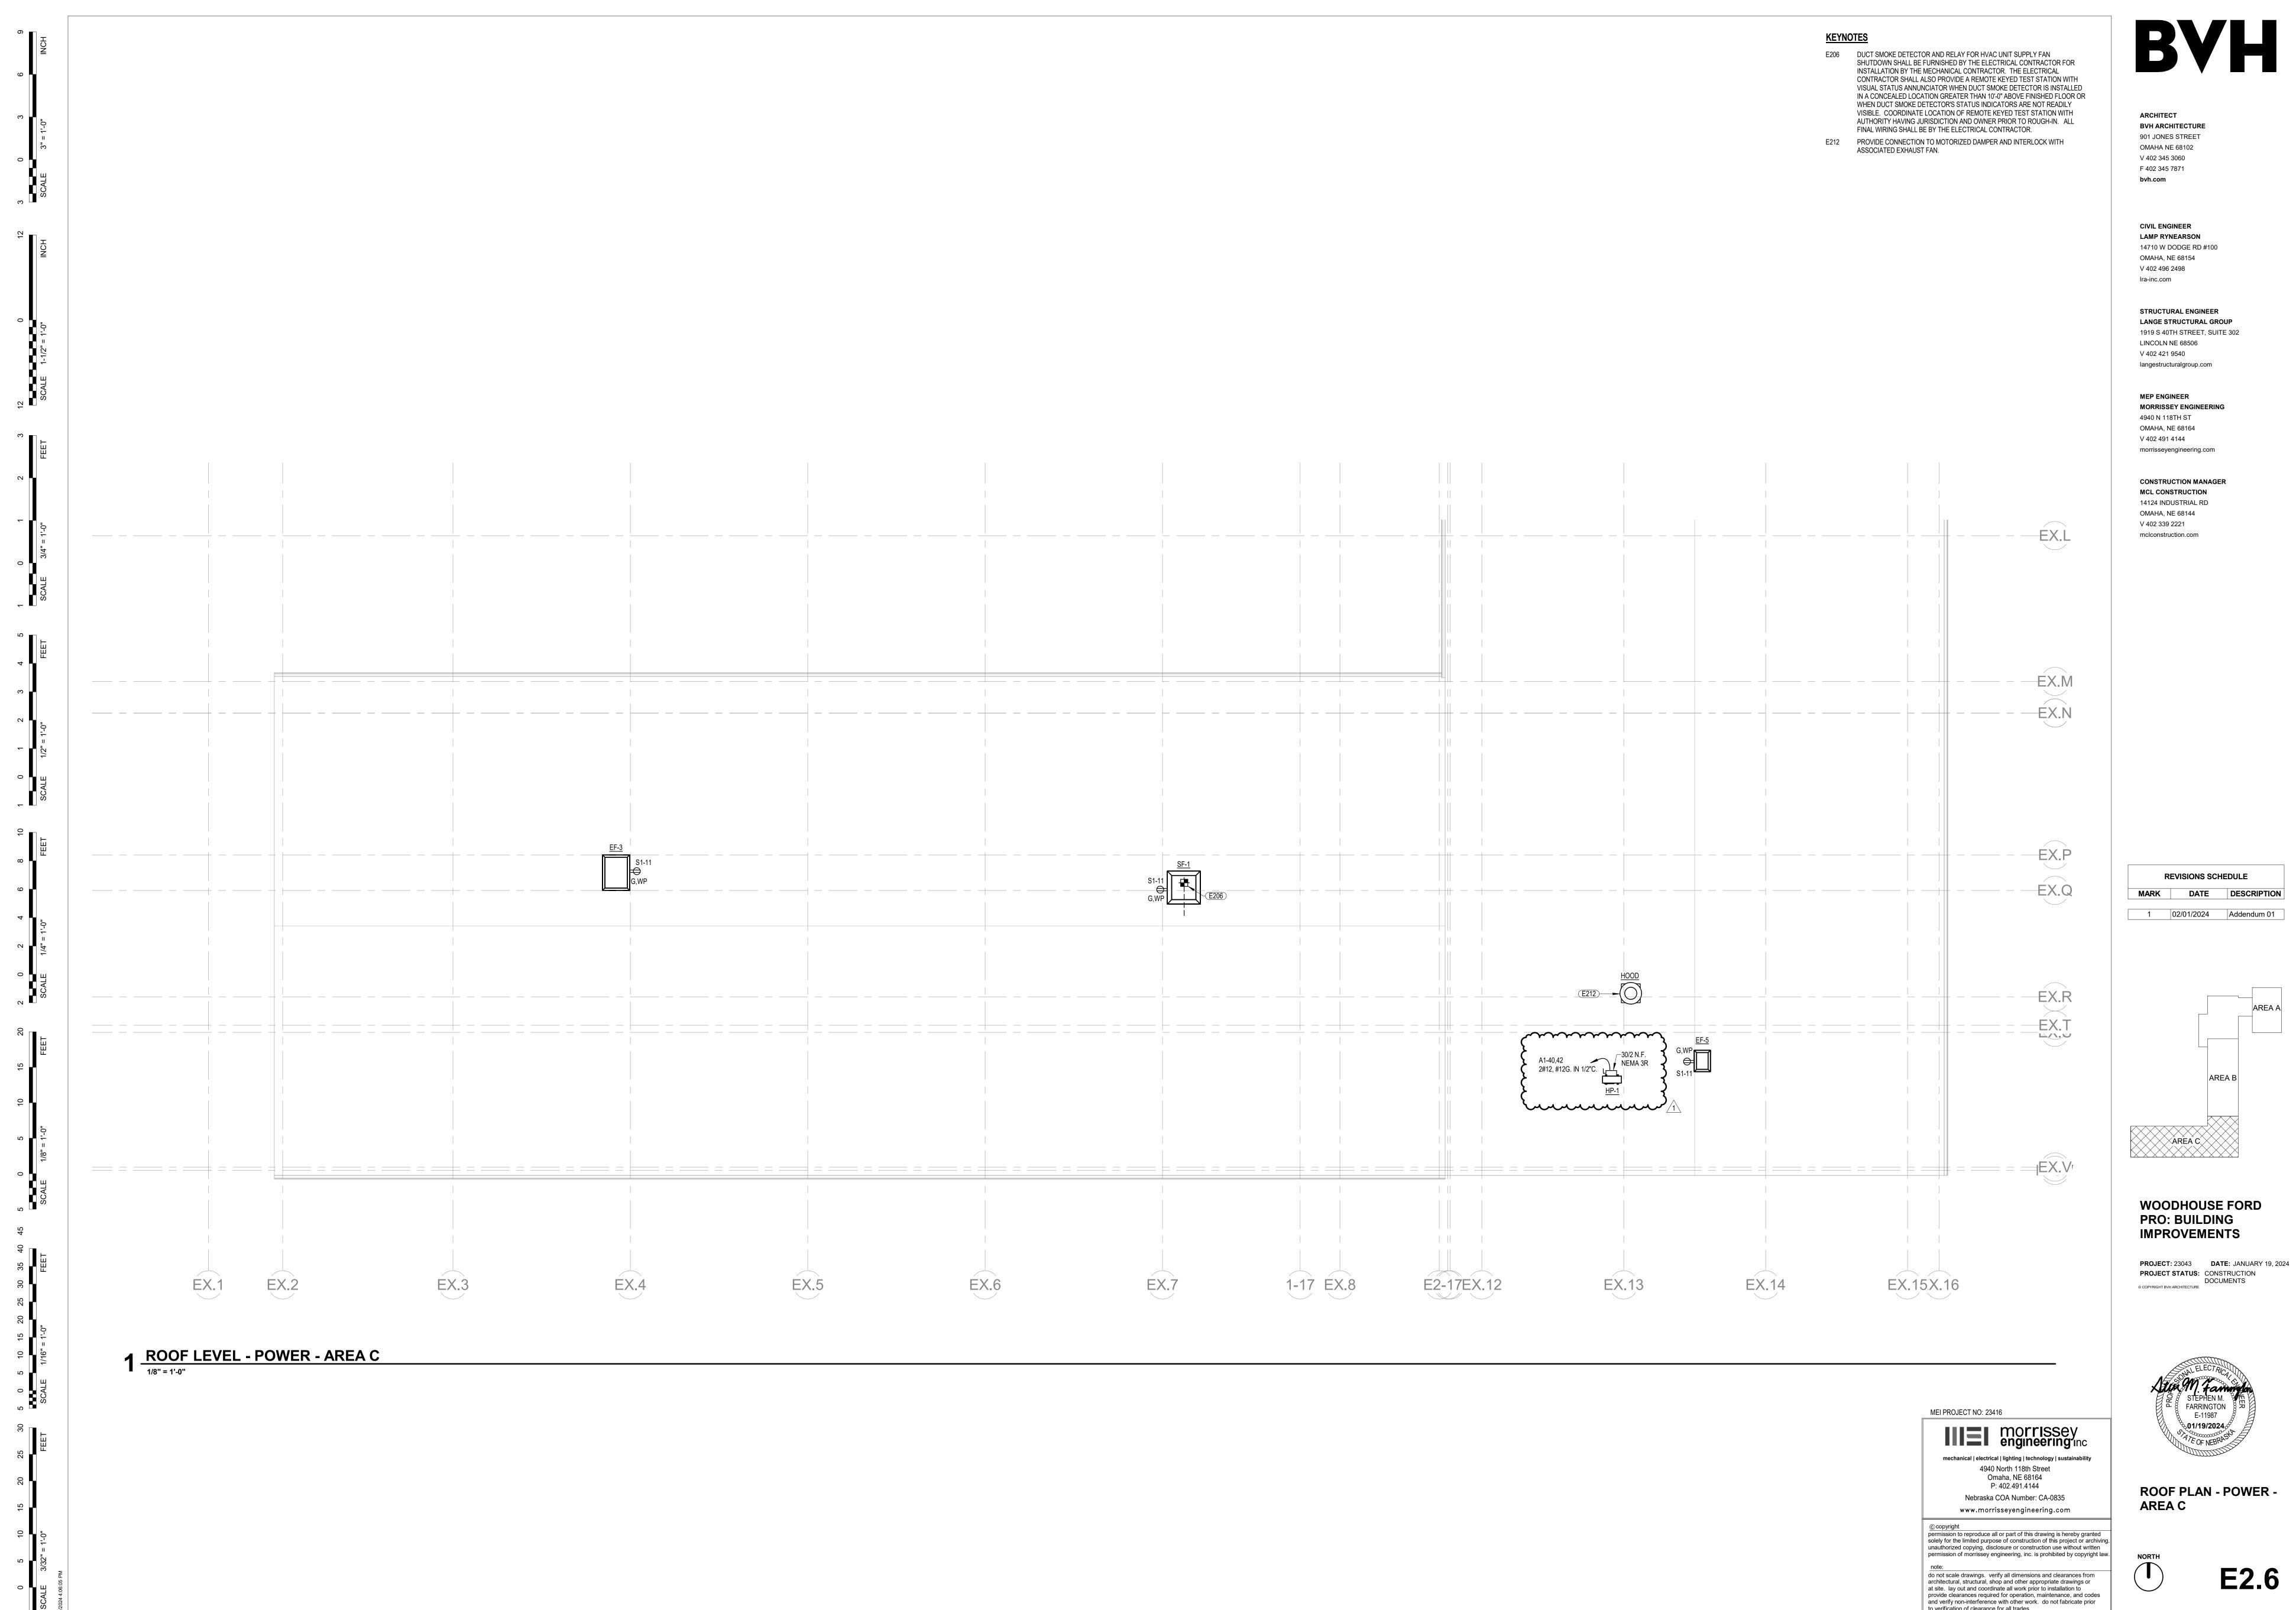

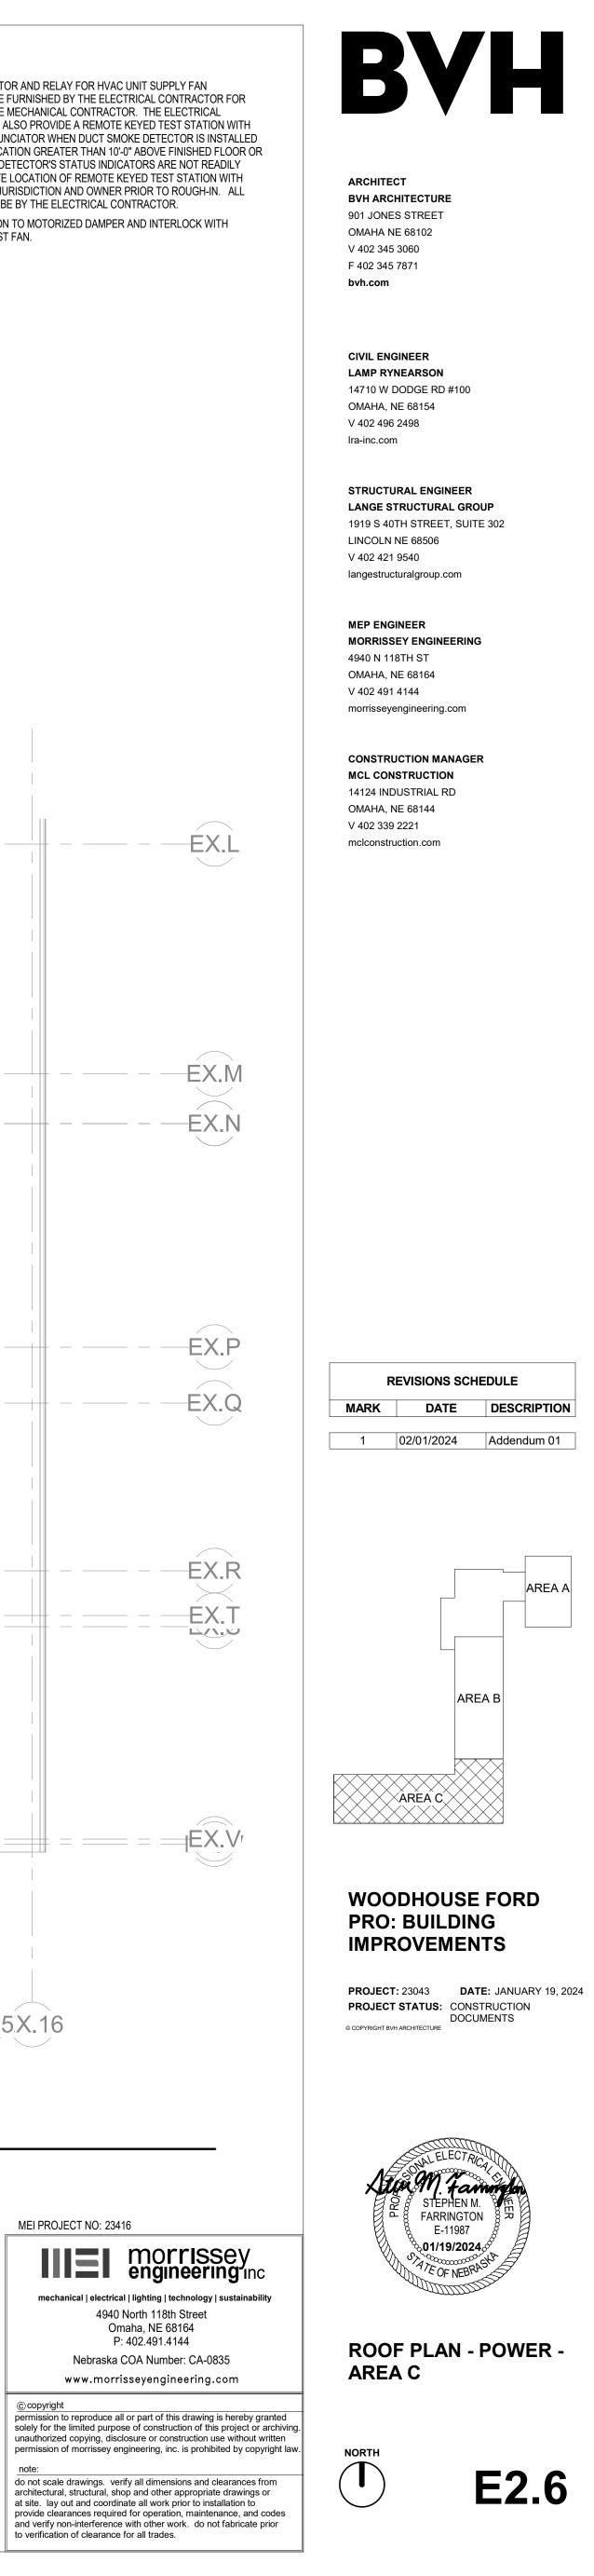

		1		1						
\wedge	PLAN TAG	208 V	1	INTEGRAL	ᡝᢇ᠋ᡗ᠊ᢩ᠈ᡟ	2#12,#12G-1/2"C				
	RH-1C RH-1D	120 V 120 V	1 1 1	TOGGLE TOGGLE	L-24 L-24	2#12,#12G-1/2"C 2#12,#12G-1/2"C 2#12,#12G-1/2"C 2#12,#12G-1/2"C	NOTE 4 NOTE 4			
	EF-1 EF-2 EF-3 EF-4 EF-5	208 V 460 V 460 V 120 V 120 V	1 3 3 1 1	30/2, N.F., NEMA 3R 30/3, N.F., NEMA 3R 30/3, N.F., NEMA 3R WP TOGGLE WP TOGGLE	L-29,31 HC2-1,3,5 H2-1,3,5 L-28 A1-27	2#12,#12G-1/2"C 3#12,#12G-1/2"C 3#12,#12G-1/2"C 2#12,#12G-1/2"C 2#12,#12G-1/2"C	NOTE 1 NOTE 1,2 NOTE 1,2 NOTE 1 NOTE 1 NOTE 1			
	EWH-1 GAS DETECTION PANEL GAS DETECTION PANEL GAS DETECTION PANEL	277 V 120 V 120 V 120 V 120 V	1 1 1 1	TOGGLE INTEGRAL INTEGRAL INTEGRAL	H-2 L-33 A-36 S1-26	2#12,#12G-1/2"C 2#12,#12G-1/2"C 2#12,#12G-1/2"C 2#12,#12G-1/2"C				
		208 V 2077 V 460 V		\sim	\sim	\sim				
	SF-1 SF-2 VFD-EF-2	460 V 460 V 480 V	$\frac{3}{3}$	30/3, N.F., NEMA 3R 30/3, N.F., NEMA 3R INTEGRAL	H2-2,4,6 HC2-7,9,11 HC2-1,3,5	3#12,#12G-1/2"C 3#12,#12G-1/2"C 3#12,#12G-1/2"C	NOTE 1,2 NOTE 1,2			
	VFD-EF-2 VFD-EF-3 VFD-SF-1 VFD-SF-2	480 V 480 V 480 V 480 V 480 V	3 3 3 3	INTEGRAL INTEGRAL INTEGRAL INTEGRAL	HC2-1,3,5 H2-1,3,5 H2-2,4,6 HC2-7,9,11	3#12,#12G-1/2"C 3#12,#12G-1/2"C 3#12,#12G-1/2"C 3#12,#12G-1/2"C				
	NOTES: 1. INTERLOCK FAN WITH A									
	COORDINATE ALL REQU	CTION TO INSTANTANEC T BREAKER SERVING W IREMENTS WITH PLUME	OUS WATER HEA ATER HEATER I BING CONTRACT	ATER. THE REQUIRED DIS BRANCH CIRCUIT TO LOC FOR PRIOR TO ROUGH-IN.	SCONNECTING MEA K CIRCUIT BREAKE	ANS SHALL CONSIST OF PA ER IN OPEN (OFF) POSITION	DLOCK I.			
	4. PROVIDE FINAL CONNECTIONS.	JFACTURER	ELEC	TRIC HEAT S		·				
	EH-1	KING		W-TKIT-1-TP	1500 VA	120 V	1			
	NOTES: 1. PROVIDE WITH INTEGR/	AL SERVICE DISCONNE	CT AND THERM	DSTAT. INSTALL PER MAN	IUFACTURERS INST	TRUCTIONS.				
			PARTS 30			FLEC 28				
			PARTS 30			ELEC 28				
SWITCHBOARD SCHEDULE Panel: MSB Rating: 1200 A Al.C. Rating: 35000			PARTS 30			ELEC 28				
)P-1 (E)			
Panel: MSB Rating: 1200 A A.I.C. Rating: 35000 Type: MAIN CKT. BKR. W/GND. Volts: 480/277 BAR Phases: 3		SFORMER (E)		METER SPD 2 SO(4 6	3 5 7 PANE	100-4) ME	EXIST. PANEL			
Panel: MSB Rating: 1200 A A.I.C. Rating: 35000 Type: MAIN CKT. BKR. W/GND. Volts: 480/277 BAR Phases: 3					3 5 7 PANE	100-4) ME				
Panel: MSB Rating: 1200 A A.I.C. Rating: 35000 Type: MAIN CKT. BKR. W/GND. Volts: 480/277 BAR Phases: 3 Integral SPD: YES Wires: 4 S.E. Rated: YES CKT NAMEPLATE DESIGNATION RATING Comments					3 ✓ 5 7 9 11	100-4) ME	EXIST. PANEL			
Panel: MSBRating: 1200 AA.I.C. Rating: 35000Type: MAIN CKT. BKR. W/GND. BARVolts: 480/277 Phases: 3Volts: 480/277 Phases: 3Integral SPD: YESWires: 4S.E. Rated: YESCKTNAMEPLATE DESIGNATIONRATING 800 AComments1MDP-1800 A32SPARE400 A3			(1200-4S)	E 0007 E 0007 12 14 E 3.0	3 5 7 9 11 13 15	100-4 EL 800-4 W 3P,4W	EXIST. PANEL <u>A1</u>			
Panel: MSBRating: 1200 A Volts: 480/277Al.C. Rating: 35000Type: MAIN CKT. BKR. W/GND. BARVolts: 480/277 Phases: 3Al.C. Rating: 35000Integral SPD: YESWires: 4S.E. Rated: YESCKTNAMEPLATE DESIGNATIONRATING 800 AComments1MDP-1800 A32SPARE400 A33SPARE400 A34SPACE400 A3				E 0007 E 0007 12 14 E 3.0	3 5 7 9 11 13 15 15	100-4 EL 800-4 W 3P,4W	EXIST. PANEL <u>A1</u>			
Panel: MSBRating: 1200 A Volts: 480/277Al.C. Rating: 35000Type: MAIN CKT. BKR. W/GND.Volts: 480/277 Phases: 3Al.C. Rating: 35000Integral SPD: YESWires: 4S.E. Rated: YESCKTNAMEPLATE DESIGNATIONRATINGComments1MDP-1800 A32SPARE400 A33SPARE400 A34SPACE400 A35SPARE400 A36SPARE225 A3	E403-		1200-4S	E 0007 E 0007 12 14 E 3.0	3 5 7 9 11 13 15 15 1200А 480/277V SWITCHBOARD	100-4 EL 800-4 W 3P,4W	EXIST. PANEL <u>A1</u>			
Panel: MSBRating: 1200 A Volts: 480/277A.I.C. Rating: 35000Type: MAIN CKT. BKR. W/GND. BARVolts: 480/277 Phases: 3S.E. Rated: YESIntegral SPD: YESWires: 4S.E. Rated: YESCKTNAMEPLATE DESIGNATIONRATING 800 AComments1MDP-1800 A32SPARE400 A33SPARE400 A34SPACE400 A35SPACE400 A36SPARE225 A37SPARE225 A38XFMR T-EV1125 A3LOCKABLE BREAKER	(E403)-		1200-4S	E 007 E 007 1 E 3.0	3 5 7 9 11 13 15 15 1200А 480/277V SWITCHBOARD	100-4 EL 800-4 W 3P,4W	EXIST. PANEL <u>A1</u>			
Panel: MSB Rating: 1200 A Al.C. Rating: 35000 Type: MAIN CKT. BKR. W/GND. Volts: 480/277 Phases: 3 Integral SPD: YES Wires: 4 S.E. Rated: YES CKT NAMEPLATE DESIGNATION RATING Comments 1 MDP-1 800 A 3 2 SPARE 400 A 3 3 SPARE 400 A 3 4 SPACE 400 A 3 5 SPACE 400 A 3 6 SPARE 225 A 3 7 SPARE 225 A 3 8 XFMR T-EV1 125 A 3 8 XFMR T-EV2 125 A 3 10 H2 100 A 3 11 SPARE 100 A 3 12 SPARE 100 A 3	E403-		1200-4S	E 0007 4 6 8 10 12 14 5 14 5 10 12 14 5 10 12 14 5 10 12 14 5 10 12 14 5 10 12 14 5 10 12 14 5 10 12 14 5 14 14 14 14 14 14 14 14 14 14	3 5 7 9 11 13 15 15 1200А 480/277V SWITCHBOARD	100-4 EL 800-4 W 3P,4W	EXIST. PANEL <u>A1</u>			
Panel: MSB Rating: 1200 A ALC. Rating: 35000 Type: MAIN CKT. BKR. W/GND. Volts: 480/277 Phases: 3 ALC. Rating: 35000 Integral SPD: YES Wires: 4 S.E. Rated: YES CKT NAMEPLATE DESIGNATION RATING Comments 1 MDP-1 800 A 3 2 SPARE 400 A 3 3 SPARE 400 A 3 4 SPACE 400 A 3 5 SPACE 400 A 3 6 SPARE 225 A 3 7 SPARE 225 A 3 8 XFMR T-EV1 125 A 3 8 XFMR T-EV2 125 A 3 10 H2 100 A 3 11 SPARE 100 A 3 12 SPARE 100 A 3 13 SPACE 100 A 3	E403-		1200-4S	E 007 E 007 1 E 3.0	3 5 7 9 11 13 15 15 1200А 480/277V SWITCHBOARD	100-4 EL 800-4 W 3P,4W	EXIST. PANEL <u>A1</u>			
Panel: MSB Rating: 1200 A A.I.C. Rating: 35000 Type: MAIN CKT. BKR. W/GND. Volts: 480/277 BAR Phases: 3 Integral SPD: YES Wires: 4 SER Kires: 4 SER Mires: 4 SER Mires: 4 SER Mires: 4 SER MoP-1 800 A 3 SPARE 400 A SPARE 225 A SPARE 225 A Phase 225 A SPARE 225 A String: SPARE 225 A String: SPARE 105 A LOCKABLE BREAKER 10 H2 100 A SPARE 100 A SPARE 100 A SPARE 100 A SPARE 100 A SPARE </td <td>E403-</td> <td></td> <td>1200-4S</td> <td>E 0007 4 6 8 10 12 14 5 14 5 10 12 14 5 10 12 14 5 10 12 14 5 10 12 14 5 10 12 14 5 10 12 14 5 10 12 14 5 14 14 14 14 14 14 14 14 14 14</td> <td>3 5 7 9 11 13 15 15 1200А 480/277V SWITCHBOARD</td> <td>100-4 EL 800-4 W 3P,4W</td> <td>EXIST. PANEL <u>A1</u></td>	E403-		1200-4S	E 0007 4 6 8 10 12 14 5 14 5 10 12 14 5 10 12 14 5 10 12 14 5 10 12 14 5 10 12 14 5 10 12 14 5 10 12 14 5 14 14 14 14 14 14 14 14 14 14	3 5 7 9 11 13 15 15 1200А 480/277V SWITCHBOARD	100-4 EL 800-4 W 3P,4W	EXIST. PANEL <u>A1</u>			
Panel: MSB Rating: 1200 A A.I.C. Rating: 35000 Type: MAIN CKT. BKR. W/GND. Volts: 480/277 Phases: 3 Integral SPD: YES Wires: 4 S.E. Rated: YES CKT NAMEPLATE DESIGNATION RATING Comments 1 MDP-1 800 A 3 2 SPARE 400 A 3 3 SPARE 400 A 3 4 SPACE 400 A 3 5 SPACE 400 A 3 6 SPARE 225 A 3 7 SPARE 225 A 3 8 XFMR T-EV1 125 A LOCKABLE BREAKER 9 XFMR T-EV2 125 A LOCKABLE BREAKER 10 H2 100 A 3 11 SPARE 100 A 3 12 SPARE 100 A 3 13 SPARE 100 A 3 14 SPACE 100 A 3 13 SPACE 100 A 3 14 SPACE 100 A 3	E403-		1200-4S	ELEC 28	<u>з</u> <u>5</u> <u>7</u> <u>9</u> <u>11</u> <u>13</u> <u>15</u> <u>1200A</u> 480/277V SWITCHBOARD - NEW	100-4 EL 800-4 W 3P,4W	EXIST. PANEL <u>A1</u>			
Panel: MSB Rating: 1200 A A.I.C. Rating: 35000 Type: MAIN CKT. BKR. W/GND. Volts: 480/277 BAR Phases: 3 Integral SPD: YES Wires: 4 S.E. Rated: YES CKT NAMEPLATE DESIGNATION RATING Comments 1 MDP-1 800 A 3 2 SPARE 400 A 3 3 SPARE 400 A 3 5 SPACE 400 A 3 5 SPACE 400 A 3 6 SPARE 225 A 3 7 SPARE 225 A 3 7 SPARE 225 A 3 8 XFMR T-EV1 125 A LOCKABLE BREAKER 9 XFMR T-EV2 126 A LOCKABLE BREAKER 9 XFMR T-EV2 128 PARE 100 A 10 H2 11 SPACE 100 A 3 11	E403-			E 0007 4 6 8 10 12 14 5 14 5 10 12 14 5 10 12 14 5 10 12 14 5 10 12 14 5 10 12 14 5 10 12 14 5 10 12 14 5 14 14 14 14 14 14 14 14 14 14	3 5 7 9 9 11 13 15 15 1200А 480/277V -1200А 480/277V SWITCHBOARD	100-4 EL 800-4 V 3P,4W D 'MSB'	E402			
Panel: MSB Rating: 1200 A A.I.C. Rating: 35000 Type: MAIN CKT. BKR. W/GND. Volts: 480/277 BAR Phases: 3 Integral SPD: YES Wires: 4 S.E. Rated: YES CKT NAMEPLATE DESIGNATION RATING Comments 1 MDP-1 800 A 3 2 SPARE 400 A 3 3 SPARE 400 A 3 4 SPACE 400 A 3 5 SPACE 400 A 3 6 SPARE 225 A 3 7 SPARE 225 A 3 8 XFMR T-EV1 125 A 3 LOCKABLE BREAKER 9 XFMR T-EV2 125 A 3 LOCKABLE BREAKER 10 H2 100 A 3 11 SPARE 100 A 3 12 SPARE 100 A 11 SPARE 100 A 3 11 SPARE 100 A 3 12 SPARE 100 A 3 11 SPARE 100 A 3 <	E403-			ELEC 28	<u>з</u> <u>5</u> <u>7</u> <u>9</u> <u>11</u> <u>13</u> <u>15</u> <u>1200A</u> 480/277V SWITCHBOARD - NEW	100-4 EL 800-4 W 800-4 (EXIST. PANEL A1 E402			
Panel: MSB Rating: 1200 A ALC. Rating: 35000 Type: MAIN CKT. BKR. W/GND. Volts: 480/277 Phases: 3 Integral SPD: YES Wires: 4 S.E. Rated: YES CKT NAMEPLATE DESIGNATION RATING Comments 1 MDP-1 800 A 3 2 SPARE 400 A 3 3 SPARE 400 A 3 4 SPACE 400 A 3 5 SPACE 400 A 3 6 SPARE 225 A 3 7 SPARE 225 A 3 8 XFMR T-EV1 125 A 1 10 H2 100 A 3 11 SPARE 100 A 3 12 SPARE 100 A 3 13 SPACE 100 A 3 14 SPACE 100 A 3 13 SPARE 100 A 3 14 SPACE 100 A 3	E403-			ELEC 28	3 5 7 9 9 11 13 15 15 1200A 480/277V SWITCHBOARD - NEW 1 (E) EXIST PANE H2	100-4 EL 800-4 (3P,4W D'MSB' (T. EXIST. PANEL A2 TA1 (R	E)			
Panel: MSB Rating: 1200 A A.I.C. Rating: 35000 Type: MAIN CKT. BKR. W/GND. Volts: 480/277 BAR Phases: 3 Integral SPD: YES Wires: 4 S.E. Rated: YES CKT NAMEPLATE DESIGNATION RATING Comments 1 MDP-1 800 A 3 2 SPARE 400 A 3 3 SPARE 400 A 3 5 SPACE 400 A 3 5 SPACE 400 A 3 6 SPARE 225 A 3 7 SPARE 225 A 3 7 SPARE 225 A 3 8 XFMR T-EV1 125 A LOCKABLE BREAKER 9 XFMR T-EV2 10 H2 11 SPARE 100 A 3 11 SPARE 100 A 3 11 SPARE 100 A 3	E403-	CTRICAL I SCALE		ELEC 28	3 5 7 9 9 11 13 15 15 1200A 480/277V SWITCHBOARD - NEW 1 (E) EXIST PANE H2	100-4 EL 800-4 W 3P,4W D'MSB' X 3P,4W D'MSB' T. EXIST. PANEL A2 TA1 (E)			
Panel: MSB Rating: 1200 A A.I.C. Rating: 35000 Type: MAIN CKT. BKR. W/GND. Volts: 480/277 BAR Phases: 3 Integral SPD: YES Wires: 4 S.E. Rated: YES CKT NAMEPLATE DESIGNATION RATING Comments 1 MDP-1 800 A 3 2 SPARE 400 A 3 3 SPARE 400 A 3 4 SPACE 400 A 3 5 SPACE 400 A 3 6 SPARE 225 A 3 7 SPARE 205 A 3 6 SPARE 21 125 A 8 XFMR T-EV1 125 A LOCKABLE BREAKER 9 XFMR T-EV2 100 A 3 11 SPARE 100 A 3 11 SPARE 100 A 3 11 SPARE 100 A 3	E403-	CTRICAL I SCALE		ELEC 28	3 5 7 9 9 11 13 15 15 1200A 480/277V SWITCHBOARD - NEW 1 (E) EXIST PANE H2	100-4 EL 800-4 (3P,4W D'MSB' (T. EXIST. PANEL A2 TA1 (R	E)			
Panel: MSB Rating: 1200 A A.I.C. Rating: 35000 Type: MAIN CKT. BKR. W/GND. Volts: 480/277 BAR Phases: 3 Integral SPD: YES Wires: 4 S.E. Rated: YES CKT NAMEPLATE DESIGNATION RATING Comments 1 MDP-1 800 A 3 2 SPARE 400 A 3 3 SPARE 400 A 3 4 SPACE 400 A 3 5 SPACE 400 A 3 6 SPARE 225 A 3 7 SPARE 225 A 3 7 SPARE 24 SPARE 100 A 3 LOCKABLE BREAKER 9 KFMR T-EV1 125 A 1 SPARE 10 H2 10 A 3 11 SPARE 100 A 3 11 SPARE 100 A 3 113		UTILITY TRANSFORM		ELEC 28	3 5 7 9 11 13 13 15 9 11 13 15 15 1200A 480/277V SWITCHBOARD - NEW 1 (E) EXIST PANE 1 (E) EXIST PANE 1 (E) EXIST PANE 1 (E) EXIST PANE 1 (E) EXIST PANE A1	100-4 EL 800-4 (3P,4W D 'MSB' T. EXIST. PANEL A2 TA1 (E)			
Panel: MSB Rating: 1200 A ALC. Rating: 35000 Type: MAIN CKT. BKR. W/GND. Volts: 480/277 Phases: 3 Integral SPD: YES Wires: Image: State of the state of t		UTILITY TRANSFORM		ELEC 28	3 5 7 9 11 13 13 15 9 11 13 15 15 1200A 480/277V SWITCHBOARD - NEW 1 (E) EXIST PANE 1 (E) EXIST PANE 1 (E) EXIST PANE 1 (E) EXIST PANE 1 (E) EXIST PANE A1	100-4 EL 800-4 (3P,4W D 'MSB' T. EXIST. PANEL A2 TA1 (

	LUMINAIRE SCHEDULE											
				LIG								
MARK	DESCRIPTION	MANUFACTURER	CATALOG NUMBER	SPEC.	ССТ	TYPE	LOAD	VOLTS	FINISH	MOUNTING	REMARKS	
F1	6" ROUND DOWNLIGHT	COOPER	RTN-HC615D010-HM612840-61WDH	1500 LM	4000 K	LED	14 W	277 V	CLEAR	RECESSED	NOTE 1	
F2	12' SUSPENDED LINEAR	COOPER	RTN-SQ4-F-OU-075D-840-1D-UNV-STD-W-12	9000 LM	4000 K	LED	52 W	277 V	WHITE	SUSPENDED	NOTE 1	
F4	2x2 TROFFER	COOPER	RTN-22CZ2-32-S-UNV-L840-CD1-U	3200 LM	4000 K	LED	24 W	277 V	WHITE	RECESSED	NOTE 1	
F4F	2x2 TROFFER	COOPER	RTN-22CZ2-32-S-UNV-L840-CD1-U-DF-22W-U	3200 LM	4000 K	LED	24 W	277 V	WHITE	RECESSED	NOTE 1	
F5	8' SERVICE DRIVE STRIP	COOPER	RTN-8TSNLED-LD5-88SL-LW-UNV-L840-CD1	8800 LM	4000 K	LED	61 W	277 V	WHITE	SUSPENDED	NOTE 1	
F6	4' STRIP LIGHT	COOPER	RTN-4SNLED-LD5-44SL-LW-UNV-L840-CD1	4400 LM	4000 K	LED	31 W	277 V	WHITE	SUSPENDED	NOTE 1	
F7	HIGHBAY	COOPER	RTN-VHB-24-N-UNV-L850-CD-U	24,000 LM	5000 K	LED	174 W	277 V	WHITE	SUSPENDED	NOTE 1	
F10	EXTERIOR WALL PACK	COOPER	RTN-GWC-SA2B-750-U-T3-DP	6105 LM	5000 K	LED	44 W	277 V	DARK PLATINUM	WALL	NOTE 1	
X3	SINGLE FACE EXIT SIGN	COOPER	RTN-LPX7SD	FURN. W/ LUMINAIRE	FURN. W/ LUMINAIRE	LED	2 W	277 V	WHITE	NOTE 2	NOTE 1	
X4	SINGLE FACE EXIT SIGN	COOPER	RTN-APXEL71R	FURN. W/ LUMINAIRE	FURN. W/ LUMINAIRE	LED	2 W	277 V	WHITE	NOTE 2	NOTE 1	
X6	LED BATTERY LIGHT	COOPER	RTN-SEL50SD	FURN. W/ LUMINAIRE	FURN. W/ LUMINAIRE	LED	2 W	277 V	WHITE	SURFACE	NOTE 1	
X7	EXTERIOR BATTERY LIGHT	COOPER	RTN-SELDWA29SD	FURN. W/ LUMINAIRE	FURN. W/ LUMINAIRE	LED	4 W	277 V	SILVER	WALL	NOTE 1	

GENERAL REQUIREMENTS:


A. CONTRACTOR SHALL VERIFY CATALOG NUMBERS AND INSTALLATION REQUIREMENTS PRIOR TO ORDERING. NOTIFY ENGINEER OF ANY CONFLICTS WITH PROPOSED INSTALLATION. B. CONTRACTOR SHALL COORDINATE CEILING TRIM OPTIONS FOR LUMINAIRES INSTALLED IN GRID-TYPE SUSPENDED CEILINGS. SEE ARCHITECTURAL DRAWINGS AND SPECIFICATIONS. C. UNLESS NOTED OTHERWISE REFER TO PLANS FOR SUSPENSION LENGTHS REQUIRED FOR ALL SUSPENDED LUMINAIRES.

LUMINAIRE SCHEDULE NOTES:


1. PRICING AND SPECIFICATION ASSISTANCE: DAN RODRIGUEZ - CED AUTOMOTIVE dan@rodriguez@cedslc.com / 562.964.5995


2. REFER TO PLANS FOR MOUNTING REQUIREMENTS SUCH AS WALL MOUNT, END MOUNT, CEILING MOUNT AND PROVIDE LUMINAIRES ACCORDINGLY. PROVIDE DIRECTIONAL CHEVRON ARROWS AS INDICATED ON PLANS.

	EQUIPMENT CONNECTION SCHEDULE											
						CON	NECTION	WIRE, GROUND,				
MARK	ITEM	VOLTAGE	PH	HP (KW)	AMPS	DISCONNECT	CORD AND PLUG	CONDUIT	REMARKS			
1	WHEEL BALANCER	208 V	1		10		L6-20R	2#12,#12G-1/2"C				
2	RIM CLAMP TIRE CHANGER	208 V	1		6		L6-20R	2#12,#12G-1/2"C				
3	TIRE CHANGER	208 V	1		20		L6-20R	2#12,#12G-1/2"C				
4	BENCH LATHE	120 V	1		15		5-15R	2#12,#12G-1/2"C				
5	BRAKE LATHE	120 V	1		15		5-15R	2#12,#12G-1/2"C				
6	FOUR POST LIFT	208 V	1	3		60/2, NF		2#6,#10G-1"C				
7	TWO POST LIFT	208 V	1	4		60/2, NF		2#6,#10G-1"C				
8	CAR CHARGER RECEPTACLE	208 V	1		50		14-50R	3#6,#10G-1"C				

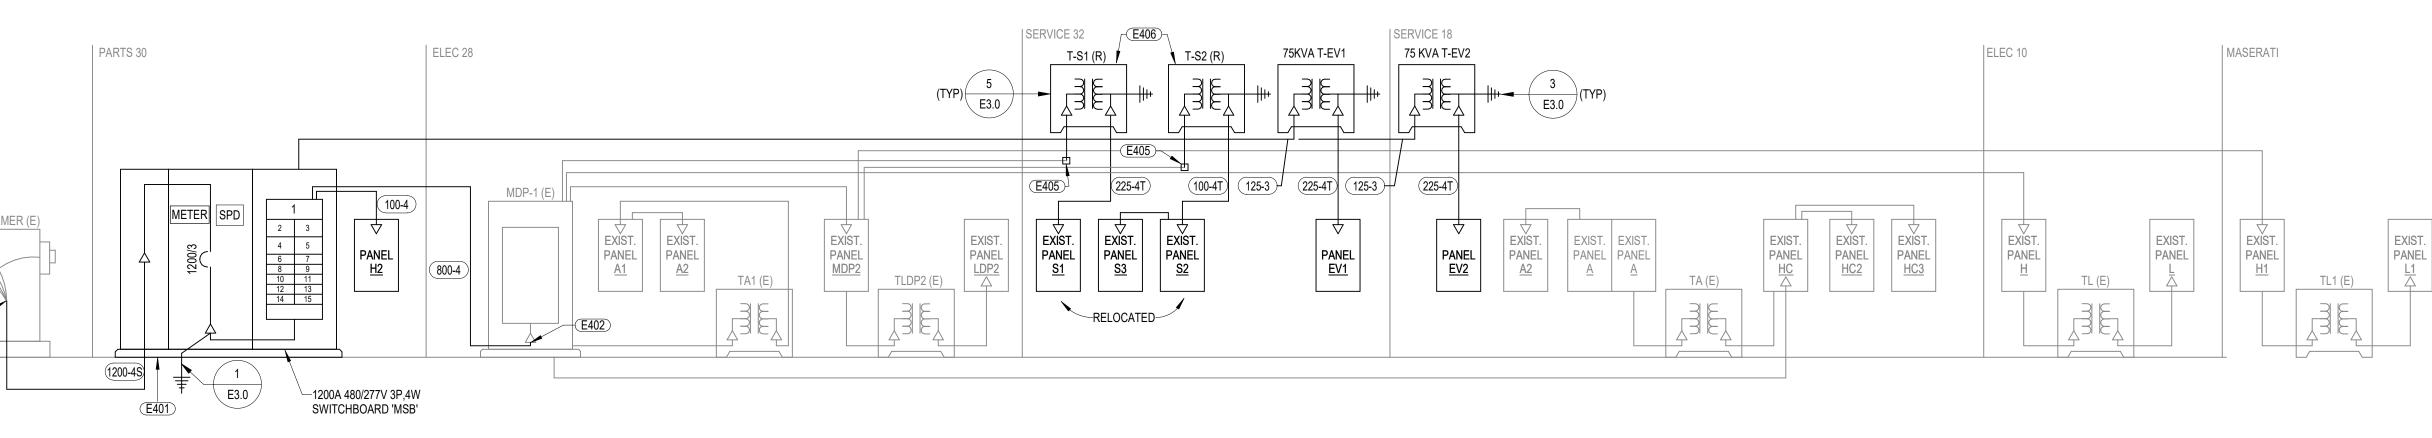



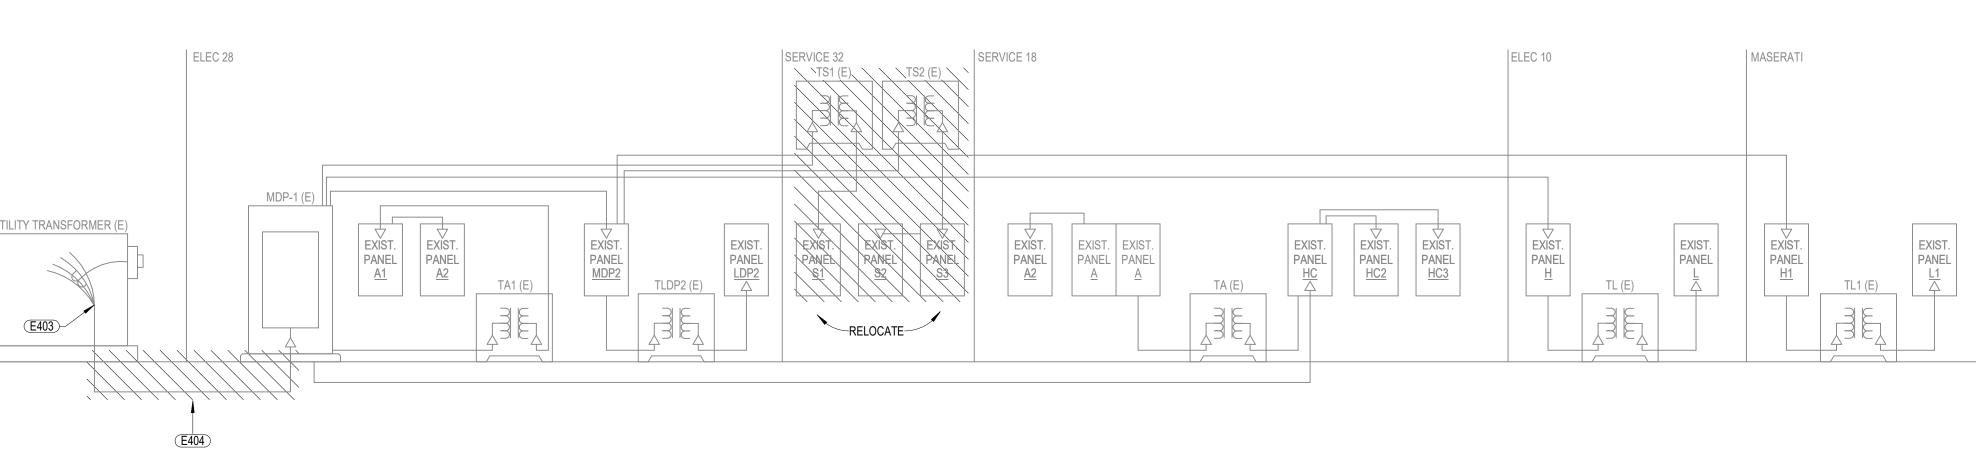

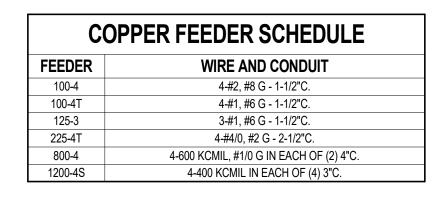

KEYNOTES

PROVIDE 3-1/2" THICK CONCRETE HOUSEKEEPING PAD WITH 3/4" CHAMFER EDGE AROUND ALL SIDES EXCEPT THOSE ABUTTING A WALL.
REMOVE MAIN BONDING JUMPER FROM EXISTING MAIN DISTRIBUTION PANEL.
COORDINATE THE OPENING OF THE UTILITY TRANSFORMER FOR THE REMOVAL OF EXISTING SERVICE FEEDERS AND THE CONNECTION OF NEW SERVICE FEEDERS WITH OPPD. COORDINATE THE CUTOVER FROM EXISTING

TO NEW SERVICE WITH THE OWNER PRIOR TO COMMENCEMENT OF WORK. REMOVE EXISTING SERVICE FEEDERS. CAP AND ABANDON CONDUIT E404

- UNDERGROUND. INTERCEPT AND EXTEND EXISTING FEEDERS TO NEW TRANSFORMER LOCATION. E405
- E406 PROVIDE LOCKABLE UPSTREAM BREAKERS FOR RELOCATED TRANSFORMERS.






ARCHITECT **BVH ARCHITECTURE** 901 JONES STREET OMAHA NE 68102 V 402 345 3060 F 402 345 7871 bvh.com

CIVIL ENGINEER LAMP RYNEARSON 14710 W DODGE RD #100 OMAHA, NE 68154 V 402 496 2498 Ira-inc.com

STRUCTURAL ENGINEER LANGE STRUCTURAL GROUP 1919 S 40TH STREET, SUITE 302 LINCOLN NE 68506 V 402 421 9540 langestructuralgroup.com

MEP ENGINEER MORRISSEY ENGINEERING 4940 N 118TH ST OMAHA, NE 68164 V 402 491 4144 morrisseyengineering.com

CONSTRUCTION MANAGER MCL CONSTRUCTION 14124 INDUSTRIAL RD OMAHA, NE 68144 V 402 339 2221 mclconstruction.com

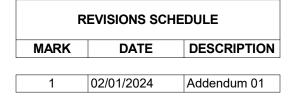



PROJECT: 23043 **DATE:** JANUARY 19, 2024 PROJECT STATUS: CONSTRUCTION © COPYRIGHT BVH ARCHITECTURE










EXISTIN	G LI	GH	TIN	GΡ	AN	IEL	S	CHEDULE			g L	GH		•
Panel: A Rating: 225 A Mounting: SURFACE Type: MCB W/FEE	D THRU	J LUGS	S AND GI	ND.BAI	r A	P	hase: Wire:	4	Rati Mounti	i ng: 200 A i ng: SURFACE /pe: MCB W/GND	. BAR			
Integral SPD: NO										Description	ОРТ	RF	Р СКТ	
Circuit Description GARAGE DOOR GARAGE DOOR	OPT		-	B C 	2	P R 2 50		Circuit Description FOUR POST LIFT	REC - AIR DR FACP WORKBENCH	YER	L N,G	20 1	1 1 1 3 1 5	-
TWO POST LIFT REC (E)	N 	60 2 20 1	5 7 9		8	2 50		FOUR POST LIFT	UPSTAIRS NE GARAGE DOO GARAGE DOO	etwork (E) Dr		20 ² 20 ²	1 7 1 9 1 11	-
GARAGE DOOR GARAGE DOOR		20 1 20 1	11 13		12 14	2 60 2 60		TWO POST LIFT	GARAGE DOO WORKBENCH	OR I CORD REELS	N,G	20 20 20 20 20 20 20 20 20 20 20 20 20 2	1 13 1 15	-
GARAGE DOOR GARAGE DOOR GARAGE DOOR		20 1 20 1 20 1	15 17 19		16 18 20	1 20 1 20	 N,G	SE SERVICE DOOR (E) WORKBENCH CORD REELS	MOBILE LIFT MOBILE LIFT REC - ELEC F	CHARGERS	N,G N,G	20 1	1 17 1 19 1 21	-
GARAGE DOOR REC - ROOFTOP REC		20 1 20 1	21 23 25		22 24 26	1 20 1 20 1 20	N,G	WORKBENCH CORD REELS WORKBENCH CORD REELS OFFICE REC (E)	CONF ROOM GUH-1 EF-5		 N	20 ²	1 23 1 25	
WHEEL BALANCER RIM CLAMP TIRE CHANGER	N,G N,G	20 2 20 2	27		28 30	1 20 1 15	N,G N,G	WORKBENCH CORD REELS BENCH LATHE	SPACE SPACE		N 	15 ² ²	1 27 1 29 1 31	-
TIRE CHANGER	N,G	20 2	31		32 34 36	1 15 1 20 1 20		CAR LATHE EXTERIOR LTG (E) GAS DETECTION PANEL	SPACE SPACE SPACE				1 33 1 35 1 37	-
SPARE SPARE SPARE		20 1 20 1 20 1	37 39 41		38 40 42	1 20 1 20 1 20		SPARE DOOR (E) SPARE	SPACE SPACE			^	1 39 1 41	
PANEL A2 (E)		100 3	43		44 46	2 60	N	TWO POST LIFT		circuit breaker. Indle type circuit bi	eaker.			
SPARE SIGNAGE (E)		20 1 20 1	49 51	····	50 52	2 60 2 60		TWO POST LIFT	Notes:					
SIGNAGE (E) COMPUTER (E) SPARE (E)		20 1 20 1 20 1	53 55 57		54 56 58	1 20 1 20		SPARE (E) SPARE (E)						
SPARE (É) SPARE ENTRANCE DOOR (E)		20 1 20 1 20 1	59 61 63		60 62 64	1 20 1 20 1 20		SPARE (E) SPARE (E) SPARE (E)						-
SPARE A/C (E)		20 1 20 1	65 67		66 68	1 20 1 20		SPARE (E) TELE SERVER (E)		EXISTIN	211	GH		-
SPARE TWO POST LIFT	 N	20 1 60 2	69 71 73		70 72 74	1 20 1 20 1 20	 	WALL REC (E) SPARE SPARE	Pa	nel: H		G		
SPARE (E) SPARE (E)		20 1 30 2	75 77 79		76 78 80	1 20 1 20 1 20 1 20		SPARE SPARE (E) SPARE (E)	Mount	ing: 225 A ing: SURFACE /pe: MCB W/GND	. BAR			
SPARE (E)		20 2	81		80 82 84	1 20 1 20 1 20		SPARE (E) SPARE (E) SPARE (E)	Integral S	•				
Options: G – GFCI type circuit breaker.	reaker						•	cuit breaker. it breaker	Circuit	Description	OPT N,L	1 1	Р СКТ 1 1	f
L – Locking handle type circuit b Notes:	reaKer.			íN —	r IOVİ	ue nev	v circu	I DICANCI				20 20	1 3 1 5 7	
								L		<u>алала</u> G (E)	N	20 20	1 11	j
									PARKING LO	T LTG (E)		20 2	2 13 15	ļ
									PARKING LO	Г LTG (E)		20 2 20 2	2 17 19 2 21 2 3	ļ
	HTI	NG	PA	NEL	S				SPARE (E)			20 2	2 25 27	
Panel: EV2 Rating: 225 A Mounting: SURFACE							oltage: Phase: Wire:		SPARE (E) GFPE			20 2	20	
J	D THRU	U LUGS	S AND GI	ND.BAI	r A	.I.C. R		SERIES RATED WITH UPSTREAM OVERCURRENT	SPARE (E) SPARE (E)			20 ² 20 ²	1 35 1 37	
			017		01/-	p -	07-	PROTECTIVE DEVICE	SPARE (E) SPARE (E) Options:			20 1	1 39 1 41	I
Circuit Description	OPT G	R F 50 2	3		2	P R 2 50		Circuit Description EVSE	G – GFCI type	circuit breaker. Indle type circuit bi	eaker.			
EVSE	G	50 2	5 7		8	2 50		EVSE	Notes:					
EVSE SPACE	G 	50 2	11 13		12 14	2 50 1	G 	EVSE SPACE						
SPACE SPACE SPACE		1 1 1	19		16 18 20	1 1 1	 	SPACE SPACE SPACE						-
SPACE SPACE SPACE SPACE		1 1 1	21 23 25		22 24	1		SPACE SPACE SPACE		EXISTIN	<u>, , , , , , , , , , , , , , , , , , , </u>	GL	111	-
SPACE SPACE		1 1 1	27 29		26 28 30	1 1 1	 	SPACE SPACE	Pa	nel: LDP2	JL	J	• • • •	•
SPACE SPACE SPACE		1 1 1	31 33 35		32 34 36	1 1 1	 	SPACE SPACE SPACE	Mount	ing: 200 A ing: SURFACE /pe: MLO W/GND	RVD			
SPACE SPACE SPACE SPACE		1 1	37 39 41		38 40 42	1		SPACE SPACE SPACE	Integral S	•	. JAK			
SPACE Options: G – GFCI type circuit breaker.		<u> </u> 1	41	S – 3		<u>1 </u> t trip ty	/pe cire	SPACE	Circuit EX LOAD (E)	Description	OPT		Р СКТ 1 1	Ţ
L – Locking handle type circuit b Notes:	reaker.			_ `		رد _{- ا}	. 510		EX LOAD (E) EX LOAD (E)			20 ² 20 ²	1 3 1 5	
									EX LOAD (E) EX LOAD (E) EX LOAD (E)			20 1	1 7 1 9 1 11	ł
									EX LOAD (E) EX LOAD (E)			20 ² 20 ²	1 13 1 15	ļ
									EX LOAD (E) EX LOAD (E) SPARE (E)			20 1	1 17 1 19 2 21	
EXISTIN	GL	GH	TIN	G P	ΔΝ	IEI	_ \$0	CHEDULE	EX LOAD (E) EX LOAD (E)			50 2 20 2 20 2	2 21 23 1 25 1 27	ĺ
Panel: L	- LI			- 1	- 11	Vo		120/208	EX LOAD (E) Options:			20 1	1 27	ĺ
Rating: 150 A Mounting: SURFACE Type: MCB W/GNE). BAR				Δ		Wire:		L – Locking ha	circuit breaker. Indle type circuit bi	eaker.			
Integral SPD: YES									Notes:					
Circuit Description GARAGE DOOR	OPT	20 1	• CKT A	ВС	СКТ 2	1 20		GARAGE DOOR	╡└──					-
GARAGE DOOR GARAGE DOOR BREAK ROOM REC		20 1 20 1 20 1 20 1	3 5		4 6	1 20 1 20	G,N G,N	EWC FRIDGE PRINTER						-
BREAK ROOM REC COMM REC (E)		20 1 20 1	9 11		8 10 12	1 20 1 20 1 20		REC - WORK 9 REC - ADVISOR 7,8		EXISTIN	g li	GH		•
REC - ADVISOR 5,6 REC - ADVISOR 3,4 FRIDGE	G,N	20 1 20 1	13 15 17		14 16 18	1 20 1 20 1 20		RR, CORR REC (E) EF (E) REC - LOBBY COUNTERTOP	Rati	nel: MDP-2 ing: 225 A ing: SURFACE				
REC - LOBBY COUNTERTOP REC - LOBBY COUNTERTOP	л, о, і N	20 1 20 1	19 21		20 22	1 20 1 20		REC - CORRIDOR REC - SERVICE MGR		/pe: MLO W/GND	. BAR			
REC - LOBBY REC SIGNAGE SIGNAGE		20 1 20 1 20 1	23 25 27		24 26 28	1 20 1 20 1 15		RH RTO-1,2 (E) EF-4			05-			Ī
EF-1	N	15 2	20		30	1 20 2 30		REC - ROOFTOP REC SIGNAGE (E)	SPACE SPACE	Description	OPT 	1	P CKT 1 1 1 3	ļ
GAS DETECTION PANEL SPARE SPARE		20 1 20 1 20 1	35 37		36 38	1 20 1 20		LCP (E) SPARE	SPACE SPACE				1 5 1 7 9	ļ
SPARE (E) SPARE (E) CU-1,BC-1 (E)		20 1 20 1 20 1	39 41 43		40 42 44	1 20 1 20 1 20		SPARE SPARE (E) RELAY PANEL SPARE (E)	POLE LTG AN	ID TIMECLOCK (E	i)	20 3	3 <u>11</u> 13	
SPARE (E) SPARE (E)		20 1 20 1	45 47		46 48	2 50	N	EVSE	XFMR FOR B((E)	ODY SHOP PANE	L	40 3	15 3 17 19	
SPACE SPACE SPACE		1 1 1	49 51 53		50 52 54	1 1 1	 	SPACE SPACE SPACE	PARTS XFMR	(E) PANEL LDP2	?	40 3	21 3 23	ļ
SPACE SPACE SPACE SPACE		1 1	55			1		SPACE SPACE SPACE	SPARE			70 3	25 27 3 29	j
SPACE Options: G – GFCI type circuit breaker.		1	59	S – 2		1 t trip ty	/pe circ	SPACE	Options:	alies 20 1			31	ĺ
G – GFCI type circuit breaker. L – Locking handle type circuit b Notes:	reaker.						•	uit breaker. it breaker	L – Locking ha	circuit breaker. Indle type circuit bi	eaker.			
									Notes:					
														-

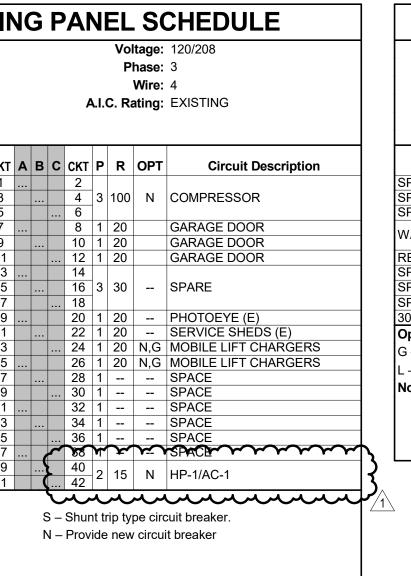

Panel: A2 Rating: 100 A Mounting: SURFACE Type: MLO W/GND. Integral SPD: NO		·					A	.	Ρ	hase: Wire:	-	
Circuit Description	ОРТ	R	Р	скт	A	в	С	скт	Р	R	OPT	Circuit Description
SPACE			1	1				2	1			SPACE
SPACE			1	3				4	1			SPACE
SPACE			1	5				6	1			SPACE
WASHER (E)		30	2	7				8	1	50		PORSCHE (E)
× ,				9				10	1			LIFT PLUG (E)
REC (E)		20	1	11				12	1	20		HEAT CABLE (E)
SPARE		20	1					14	1	20		RR OFFICES (E)
SPARE		20	1	15				16	2	60		EV CHARGER (E)
SPARE		20	1	17				18	1			
30A REC (E)		30	1	19				20	1			SPACE
Options:						_		<u>.</u> .				
G – GFCI type circuit breaker.						5	5 –	Shur	nt ti	rip ty	pe circ	cuit breaker.
– Locking handle type circuit broken in the second seco	eaker.					Ν	1 –	Prov	ide	new	/ circui	it breaker
Notes:												

					.1.0	Ρ	hase: Wire:	
скт	Α	в	С	скт	Р	R	ОРТ	Circuit Description
1				2	1	20		EWH-1
3				4				
5				6	3	60		SPARE
7	3			8		-		
<mark>ع</mark> 11	ア			10				
11				12	3	30		RTU-2 (E)
13				14				
15				16				
17				18	3	70		XFMR TL (E)
19				20				
21				22	1	20		WOMENS RR HWH (E)
23				24	1	20		MENS RR HWH (E)
25				26	1	20		FLOOR HEAT (E)
27				28	1			GFPE
29				30	1	20		EWH (E)
31				32	1	20		EWH (E)
33				34	1	20		SPARE (E)
35				36	1	20		SPARE (E)
37				38	1	20		SPARE (E)
39				40	1	20		SPARE (E)
41				42	1	20		SPARE (E)
							•	suit breaker. t breaker

Rating: 225 A Mounting: SURFACE	Mounting: SURFACE Type: MLO W/GND. BAR							Voltage: 480/277 Phase: 3 Wire: 4 A.I.C. Rating: EXISTING							
Circuit Description	OPT	R	Р	скт	Α	в	с	скт	Р	R	ОРТ	Circuit Description			
SERVICE BAY LTG		20	1	1				2				-			
SERVICE BAY LTG		20	1	3				4	3	20		EXHAUST FAN (E)			
				5				6							
XFMR TA (E)		20	3	7				8	1	20		SERVICE BAY LTG			
				9				10	1	20		EXTERIOR LTG			
				11				12	1	20		SPARE			
LTG CONTACTOR (E)		20	3	13				14	1	20		SPARE			
				15				16	1	20		SPARE			
SPARE		20	1	17				18	1	20		SPARE			
SPARE		20	1	19				20	1	20		UPSTAIRS REC (E)			
SPARE		20	1	21				22	1	30		SPARE			
				23				24							
RTU (E)		20	3	25				26	3	60		RTU (E)			
				27				28							
Options: G – GFCI type circuit breaker.						S	S –	Shur	nt tr	ip ty	pe circ	cuit breaker.			
L – Locking handle type circuit l	oreaker.										•	t breaker			

E	KIS
Panel:	HC2
Rating:	100
Mounting:	
Type:	
Integral SPD:	NO
Circuit Des	cript
EF-2	
SF-2	
SPARE (E)	
Options:	
G – GFCI type circ	
L – Locking handle	e type
Notes:	

Panel: S3

Panel: S2

PAR PARE

SPARE

SPARE Options:

SPARE

SPARE

ISPARF

SPARE

SPARE

SPARE

Panel: A2

MAIN BREAKER (E)

PAR

SPARE


		s: 480/2		A.I.C. Rating: EXISTING
ntegra	I SPD: NO Wire	s: 4		S.E. Rated: YES
скт	NAMEPLATE DESIGNATION	RATI	١G	Comments
1	SERVICE DRIVE XFMR (E)	100 A	3	
2	480V PANEL (E) MDP2?	200 A	3	
3	MAIN BACK BODY SHOP (E)	100 A	3	
4	SPARE	225 A	3	
5	480V PANEL FRONT SERVICE AREA (E)	. 225 A	3	
6	HEATING AND COOLING (E)	60 A	3	
7	CAR EXHAUST FAN (E)	20 A	3	
8	SPARE	20 A	3	
9	SPARE	20 A	1	
10	SPARE	20 A	1	
11	SPARE	20 A	1	
12	SPARE	20 A	1	
13	POLE LTG (E)	20 A	3	
14	SPARE	20 A	1	
15	POLE LTG (E)	40 A	3	
16	SPARE	20 A	1	
17	SPARE	20 A	1	
18	STREET LTG PANEL (E)	125 A	3	
19				
20				
Notes:				OR THE BREAKER ITSELF MUST BE THE

BE INSTALLED ON OR ABOVE THE MA CIRCUIT BREAKER WITH THE FOLLOWING INFORMATION: a. SERVICE SIZE - PER NEC.

b. ALL PROGRAMMED BREAKER SETTINGS. c. "CAUTION - ANY CHANGES TO THESE SETTINGS COULD BE A POTENTIAL RISK TO LIFE AND PROPERTY" 3. PROVIDE AN ARC ENERGY REDUCING MAINTENANCE SWITCH FOR EACH CIRCUIT BREAKER FRAME SIZE 1200 AMPS AND LARGER.

TING PANEL SCHEDULE										
	Voltage: 120/208 Phase: 3 Wire: 4 A.I.C. Rating: EXISTING									
,	СКТ	A	в	С	скт	Р	R	ΟΡΤ	Circuit Description	
	1 3 5				2 4 6	3	100		MAIN BREAKER (E)	
	7 9				8 10	2	30		SPARE (E)	
	11				12	1	20		EX LOAD (E)	
	13				14	1	20		WASHER (E)	
	15 17				16 18	2	30		DRYER (E)	
	19 21				20 22	2	20		EX LOAD (E)	
	23				24	1	20		EX LOAD (E)	
	25				26	1	20		EX LOAD (E)	
_	27				28	1	20		EX LOAD (E)	
	29				30	1	20		EX LOAD (E)	
S – Shunt trip type circuit breaker. N – Provide new circuit breaker										

TING PANEL SCHEDULE Voltage: 480/277 Phase: 3 Wire: 4 A.I.C. Rating: EXISTING									
_	скт	Α	в	с	скт	Р	R	ΟΡΤ	Circuit Description
	1				2	1			SPACE
	3				4	1			SPACE
	5				6	1			SPACE
	7				8	1			SPACE
	9				10		40		SPARE
3	11				12	3			
	13				14				
	15				16	3	20		POLE LTG (E)
3	17				18				
	19				20				
	21				22	3	100		PANEL H-1 (E)
3	23				24				
	25				26				
	27				28	3	90		SPARE
3	29				30				
	31				32	1			
S – Shunt trip type circuit breaker. N – Provide new circuit breaker									

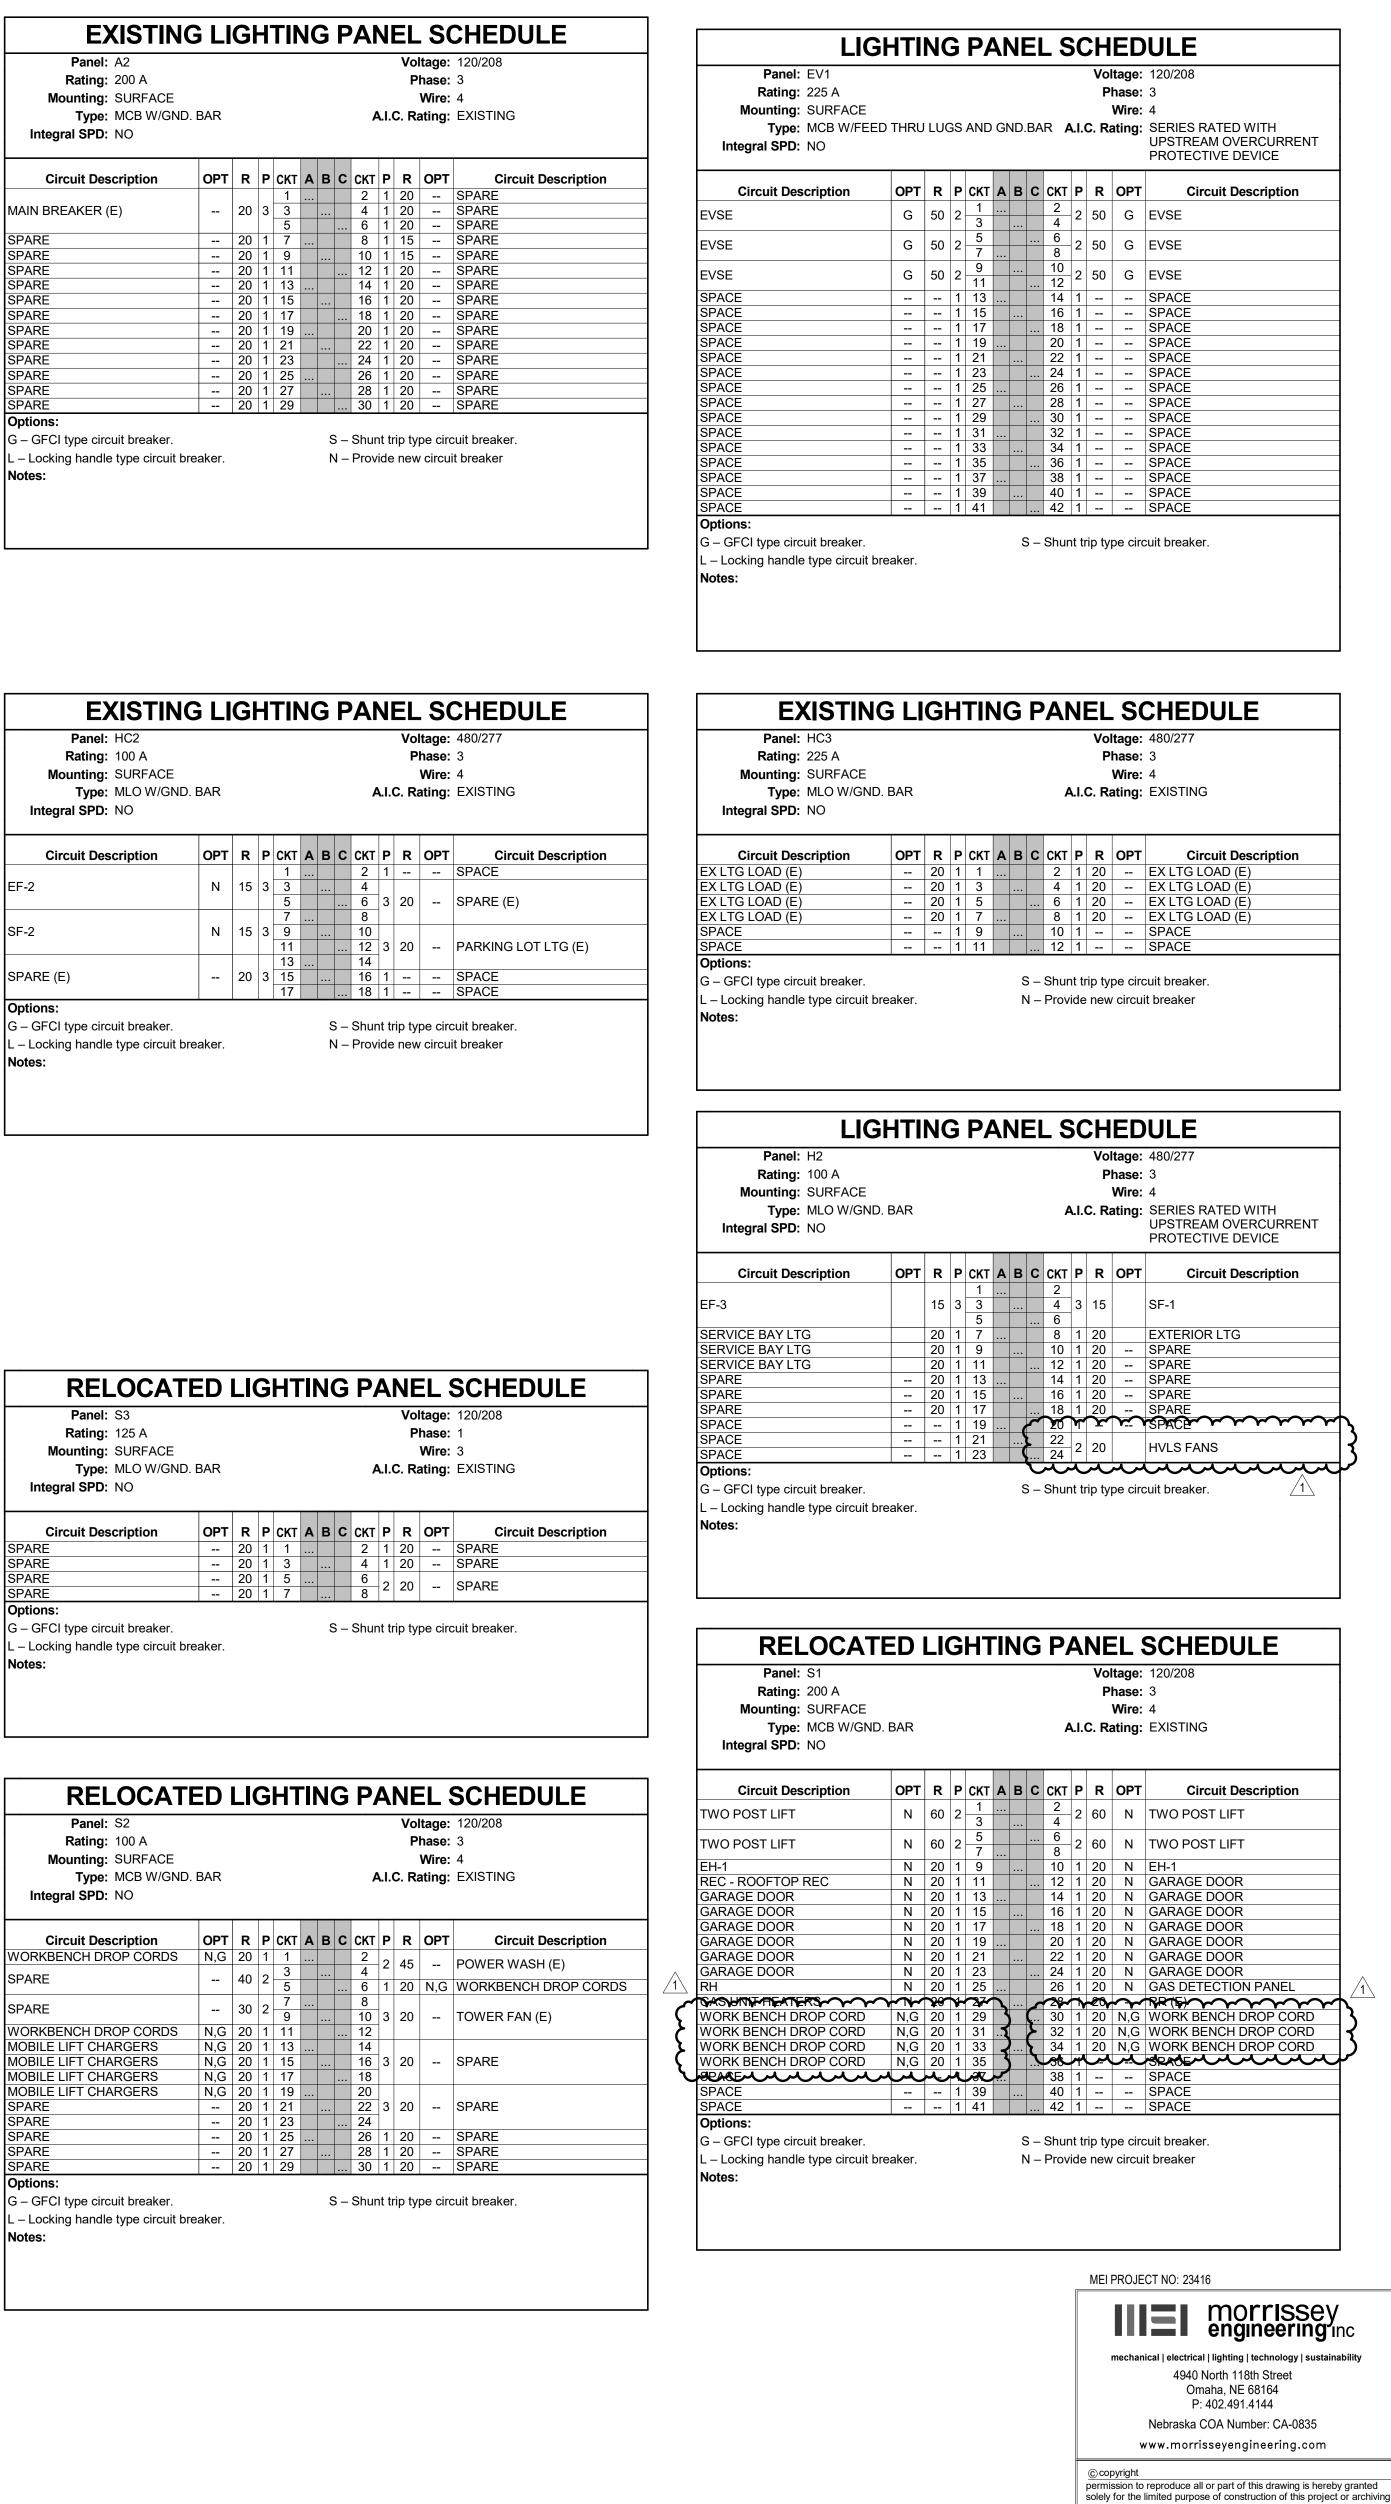

permission of morrissey engineering, inc. is prohibited by copyright law. do not scale drawings. verify all dimensions and clearances from architectural, structural, shop and other appropriate drawings or at site. lay out and coordinate all work prior to installation to

provide clearances required for operation, maintenance, and codes and verify non-interference with other work. do not fabricate prior to verification of clearance for all trades.

unauthorized copying, disclosure or construction use without written




ARCHITECT **BVH ARCHITECTURE** 901 JONES STREET OMAHA NE 68102 V 402 345 3060 F 402 345 7871 bvh.com

CIVIL ENGINEER LAMP RYNEARSON 14710 W DODGE RD #100 OMAHA, NE 68154 V 402 496 2498 Ira-inc.com

STRUCTURAL ENGINEER LANGE STRUCTURAL GROUP 1919 S 40TH STREET, SUITE 302 LINCOLN NE 68506 V 402 421 9540 langestructuralgroup.com

MEP ENGINEER MORRISSEY ENGINEERING 4940 N 118TH ST OMAHA, NE 68164 V 402 491 4144 morrisseyengineering.com

CONSTRUCTION MANAGER MCL CONSTRUCTION 14124 INDUSTRIAL RD OMAHA, NE 68144 V 402 339 2221 mclconstruction.com

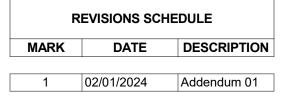



PROJECT: 23043 **DATE:** JANUARY 19, 2024 PROJECT STATUS: CONSTRUCTION © COPYRIGHT BVH ARCHITECTURE





